


1250-JAL-JAT

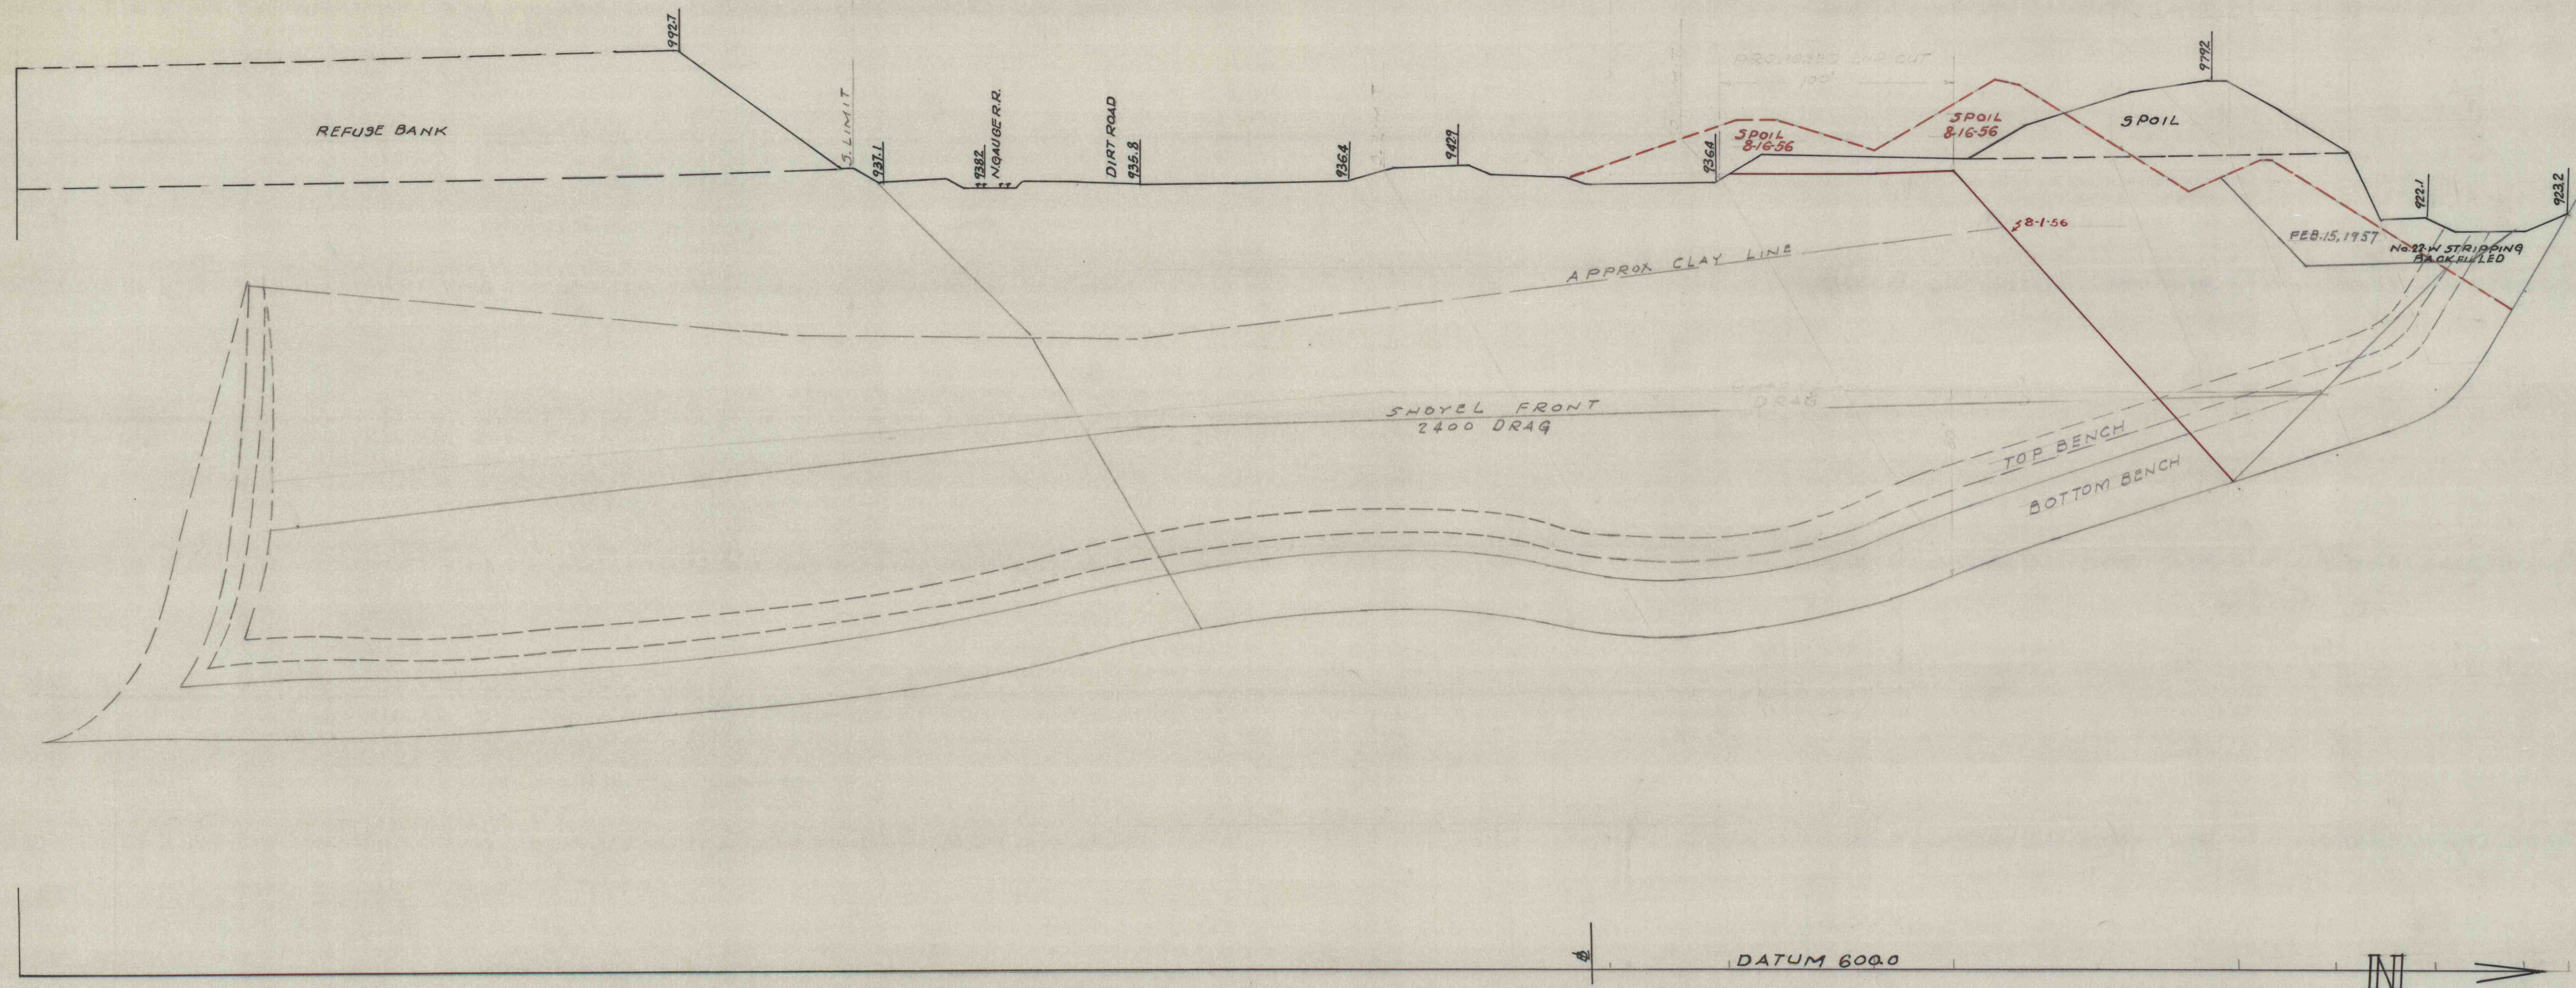

SECTION 19+00 WEST

ST. CLAIR COAL CO.
No. 22 MAMMOTH VEIN STRIPPING
WEST EXTENSION
SCALE 1"=50' JUNE 1955