


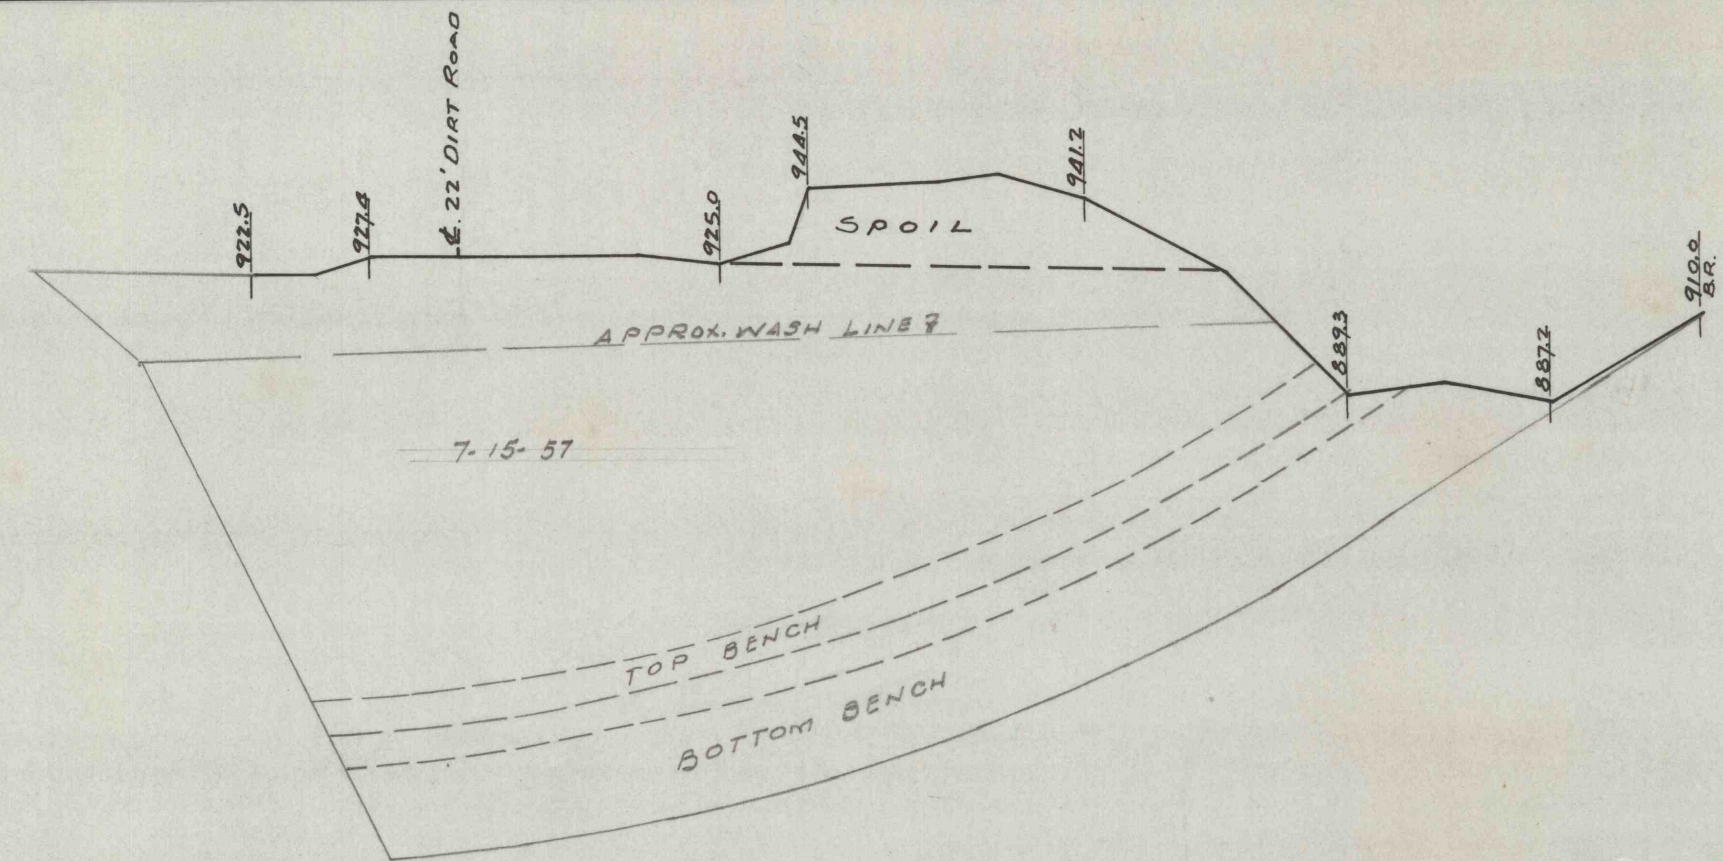

BL
0+0

DATUM 600.0

N

ST. CLAIR COAL CO.
 No. 22 MAMMOTH VEIN STRIPPING
 WEST EXTENSION
 SECTION 25+00 WEST
 SCALE 1"=50' AUGUST 6, 1956
 ENGR. DEPT. J. ROBERT BAZLEY INC.