


SECTION 13+00

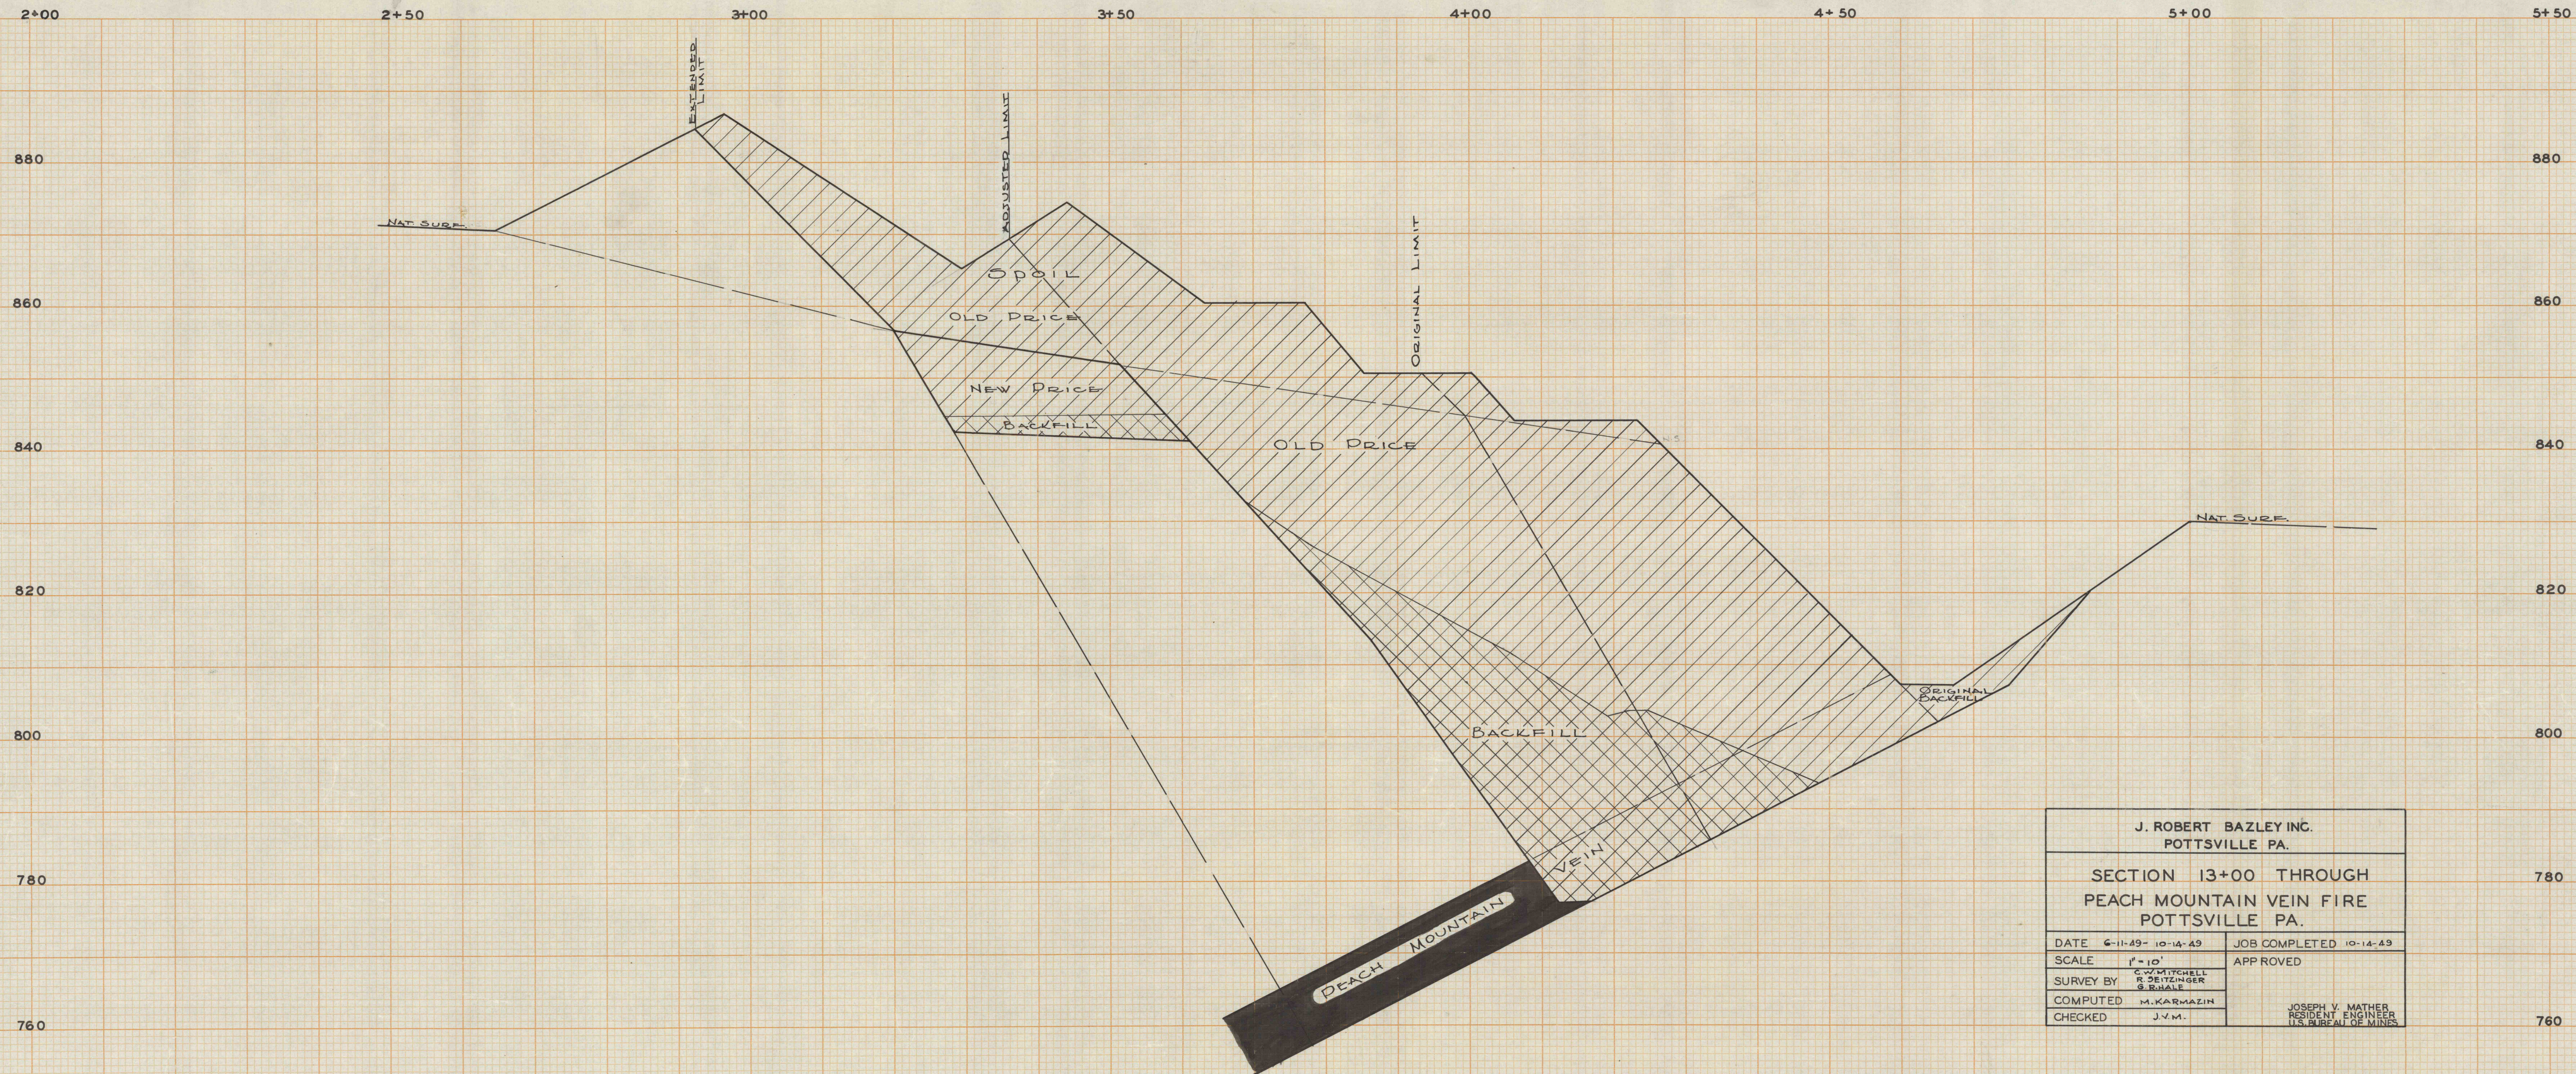

J. ROBERT BAZLEY INC. POTTSVILLE PA.	
SECTION 13+00 THROUGH PEACH MOUNTAIN VEIN FIRE POTTSVILLE PA.	
DATE 6-11-49- 10-14-49	JOB COMPLETED 10-14-49
SCALE 1"=10'	APPROVED JOSEPH V. MATHER RESIDENT ENGINEER U.S. BUREAU OF MINES
SURVEY BY C. WITCHELL R. DEITZINGER S. BHALP	
COMPUTED M. KARMAZIN	
CHECKED J. V. M.	