


SECTION 12+00

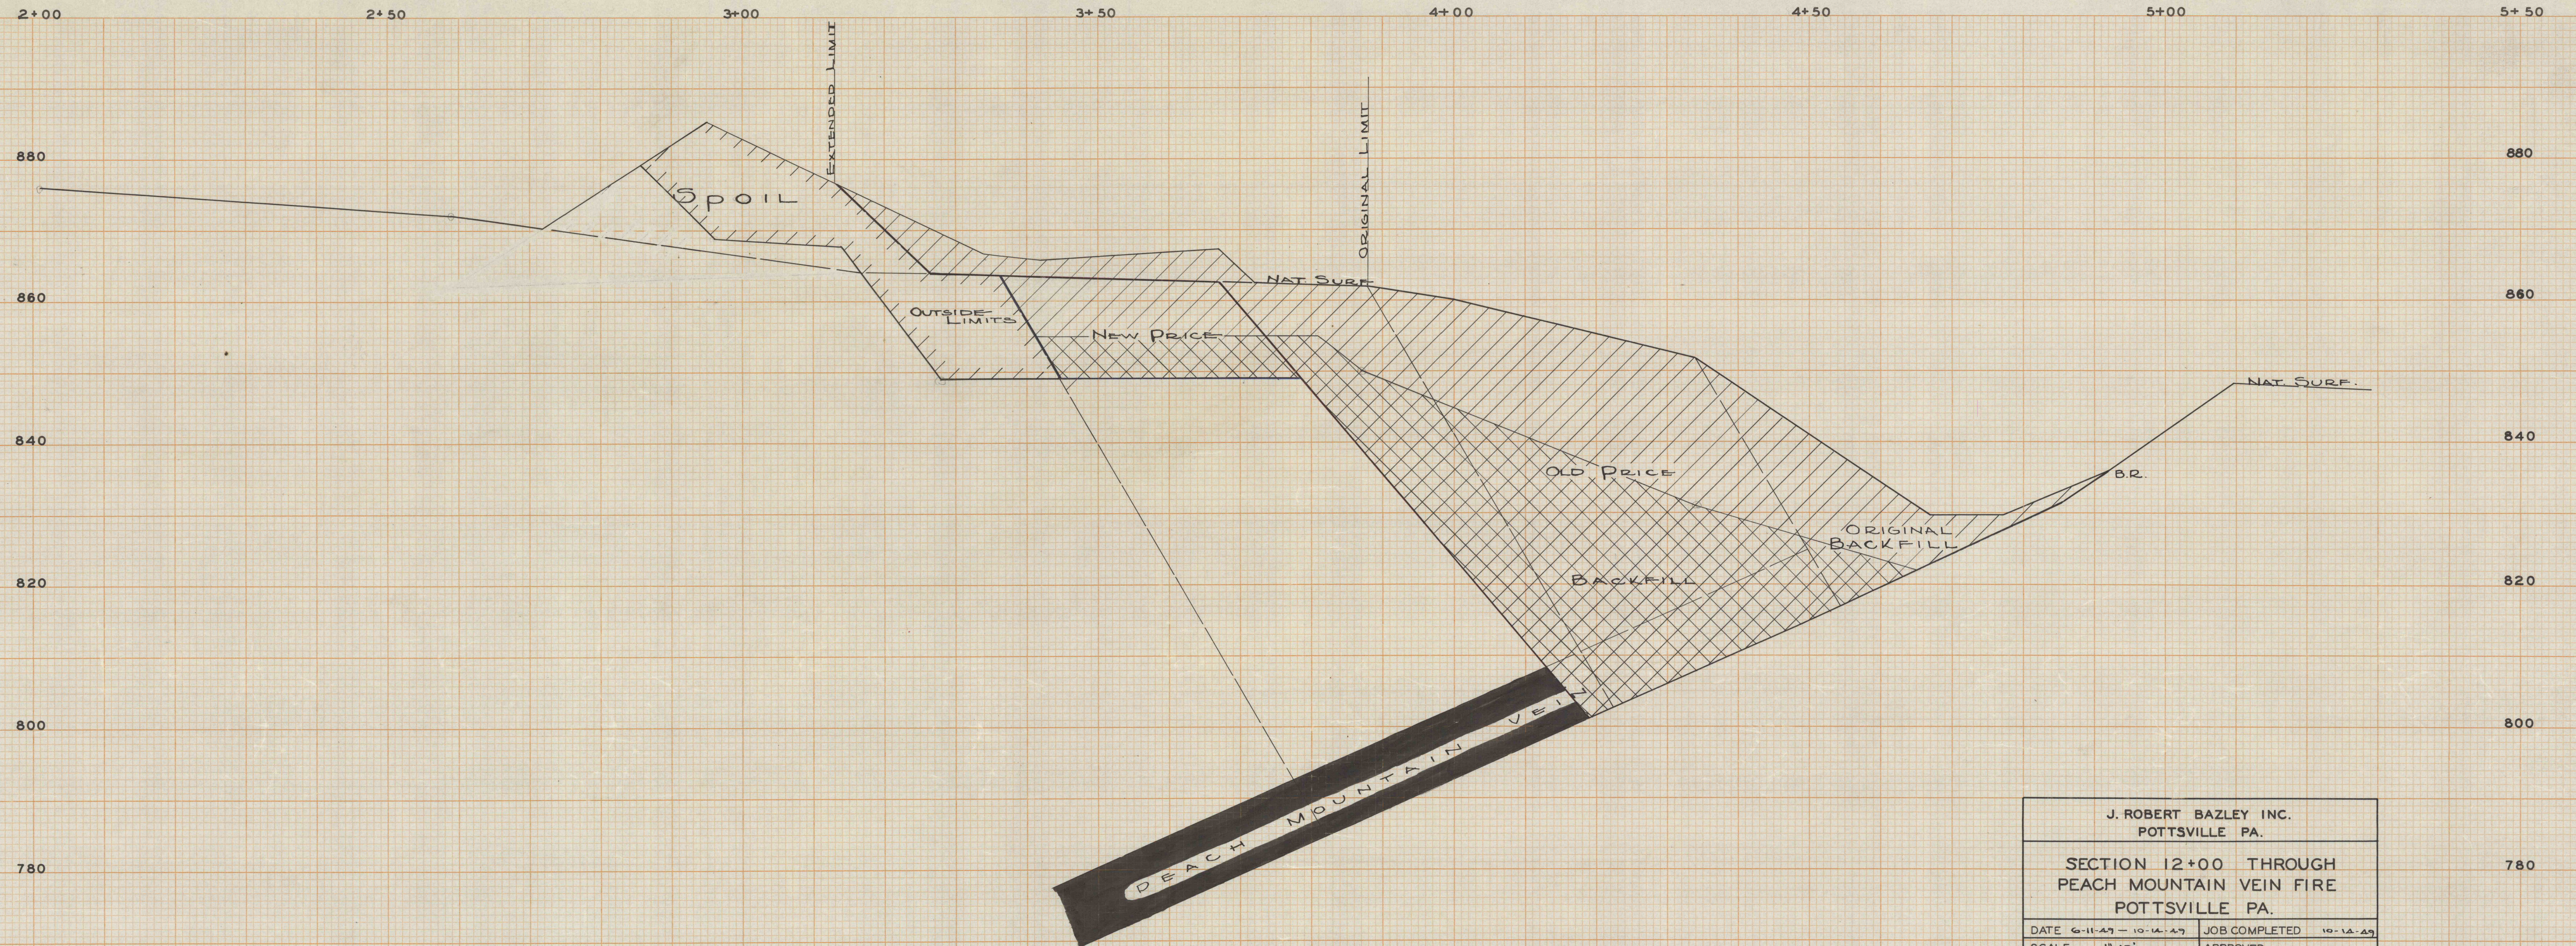

J. ROBERT BAZLEY INC. POTTSVILLE PA.	
SECTION 12+00 THROUGH PEACH MOUNTAIN VEIN FIRE POTTSVILLE PA.	
DATE 6-11-47 - 10-14-47	JOB COMPLETED 10-12-47
SCALE 1"=10'	APPROVED
SURVEY BY C.W. NATHANIEL G.S. HALE D. SEITZINGER	
COMPUTED M. KARMANIN	JOSEPH V. MATHER RESIDENT ENGINEER U.S. BUREAU OF MINES
CHECKED J.V.M.	