

SECTION 11+50

2+00

2+50

3+00

3+50

4+00

4+50

5+00

5+50

920

920

900

900

880

880

860

860

840

840

820


820

800

800

780

780

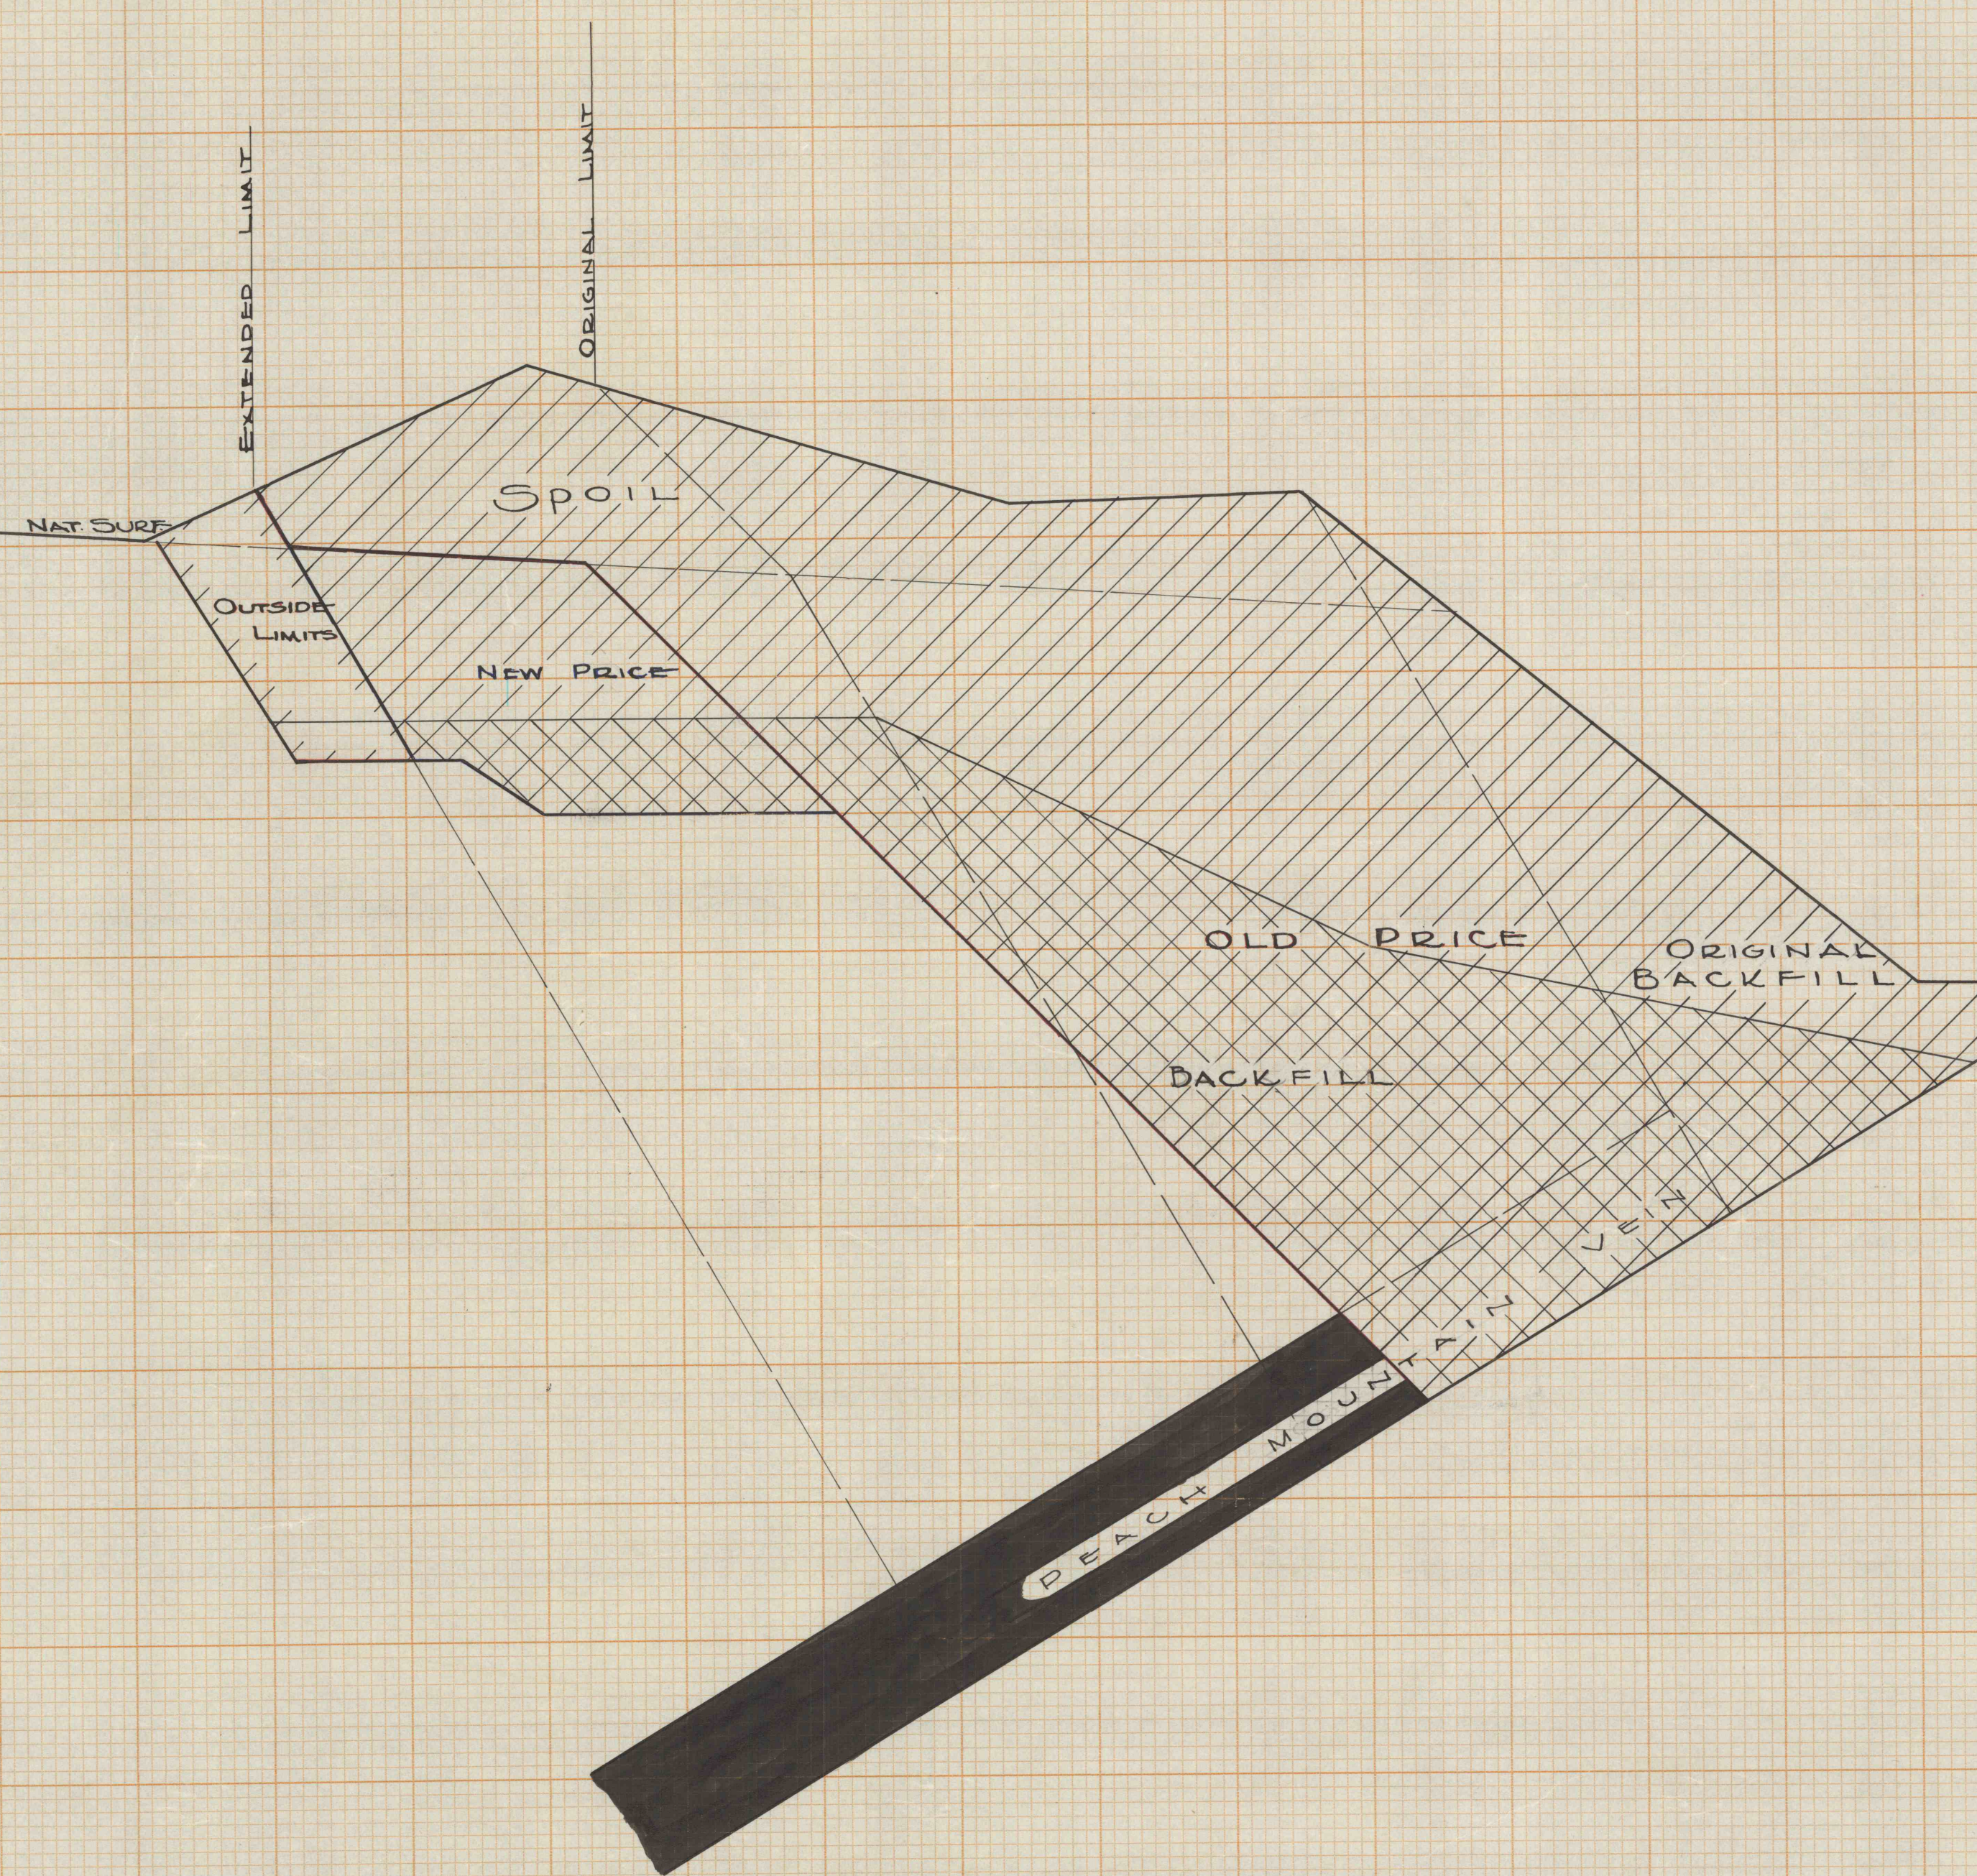

J. ROBERT BAZLEY INC. POTTSVILLE PA.	
SECTION 11+50 THROUGH PEACH MOUNTAIN VEIN FIRE POTTSVILLE PA.	
DATE 6-11-49 - 10-12-49	JOB COMPLETED 10-12-49
SCALE 1"=10'	APPROVED
SURVEY BY E.W. MITCHELL G.B. HALE R. SEITZINGER	<i>Joseph V. Mather</i> JOSEPH V. MATHER RESIDENT ENGINEER U.S. BUREAU OF MINES
COMPUTED M. KARMAZIN	
CHECKED J.V.M.	