

SECTION 11+00

2+00

2+50

3+00

3+50

4+00

4+50

5+00

5+50

920

900

880

860

840

820

800

920

900


880

860

840

820

800

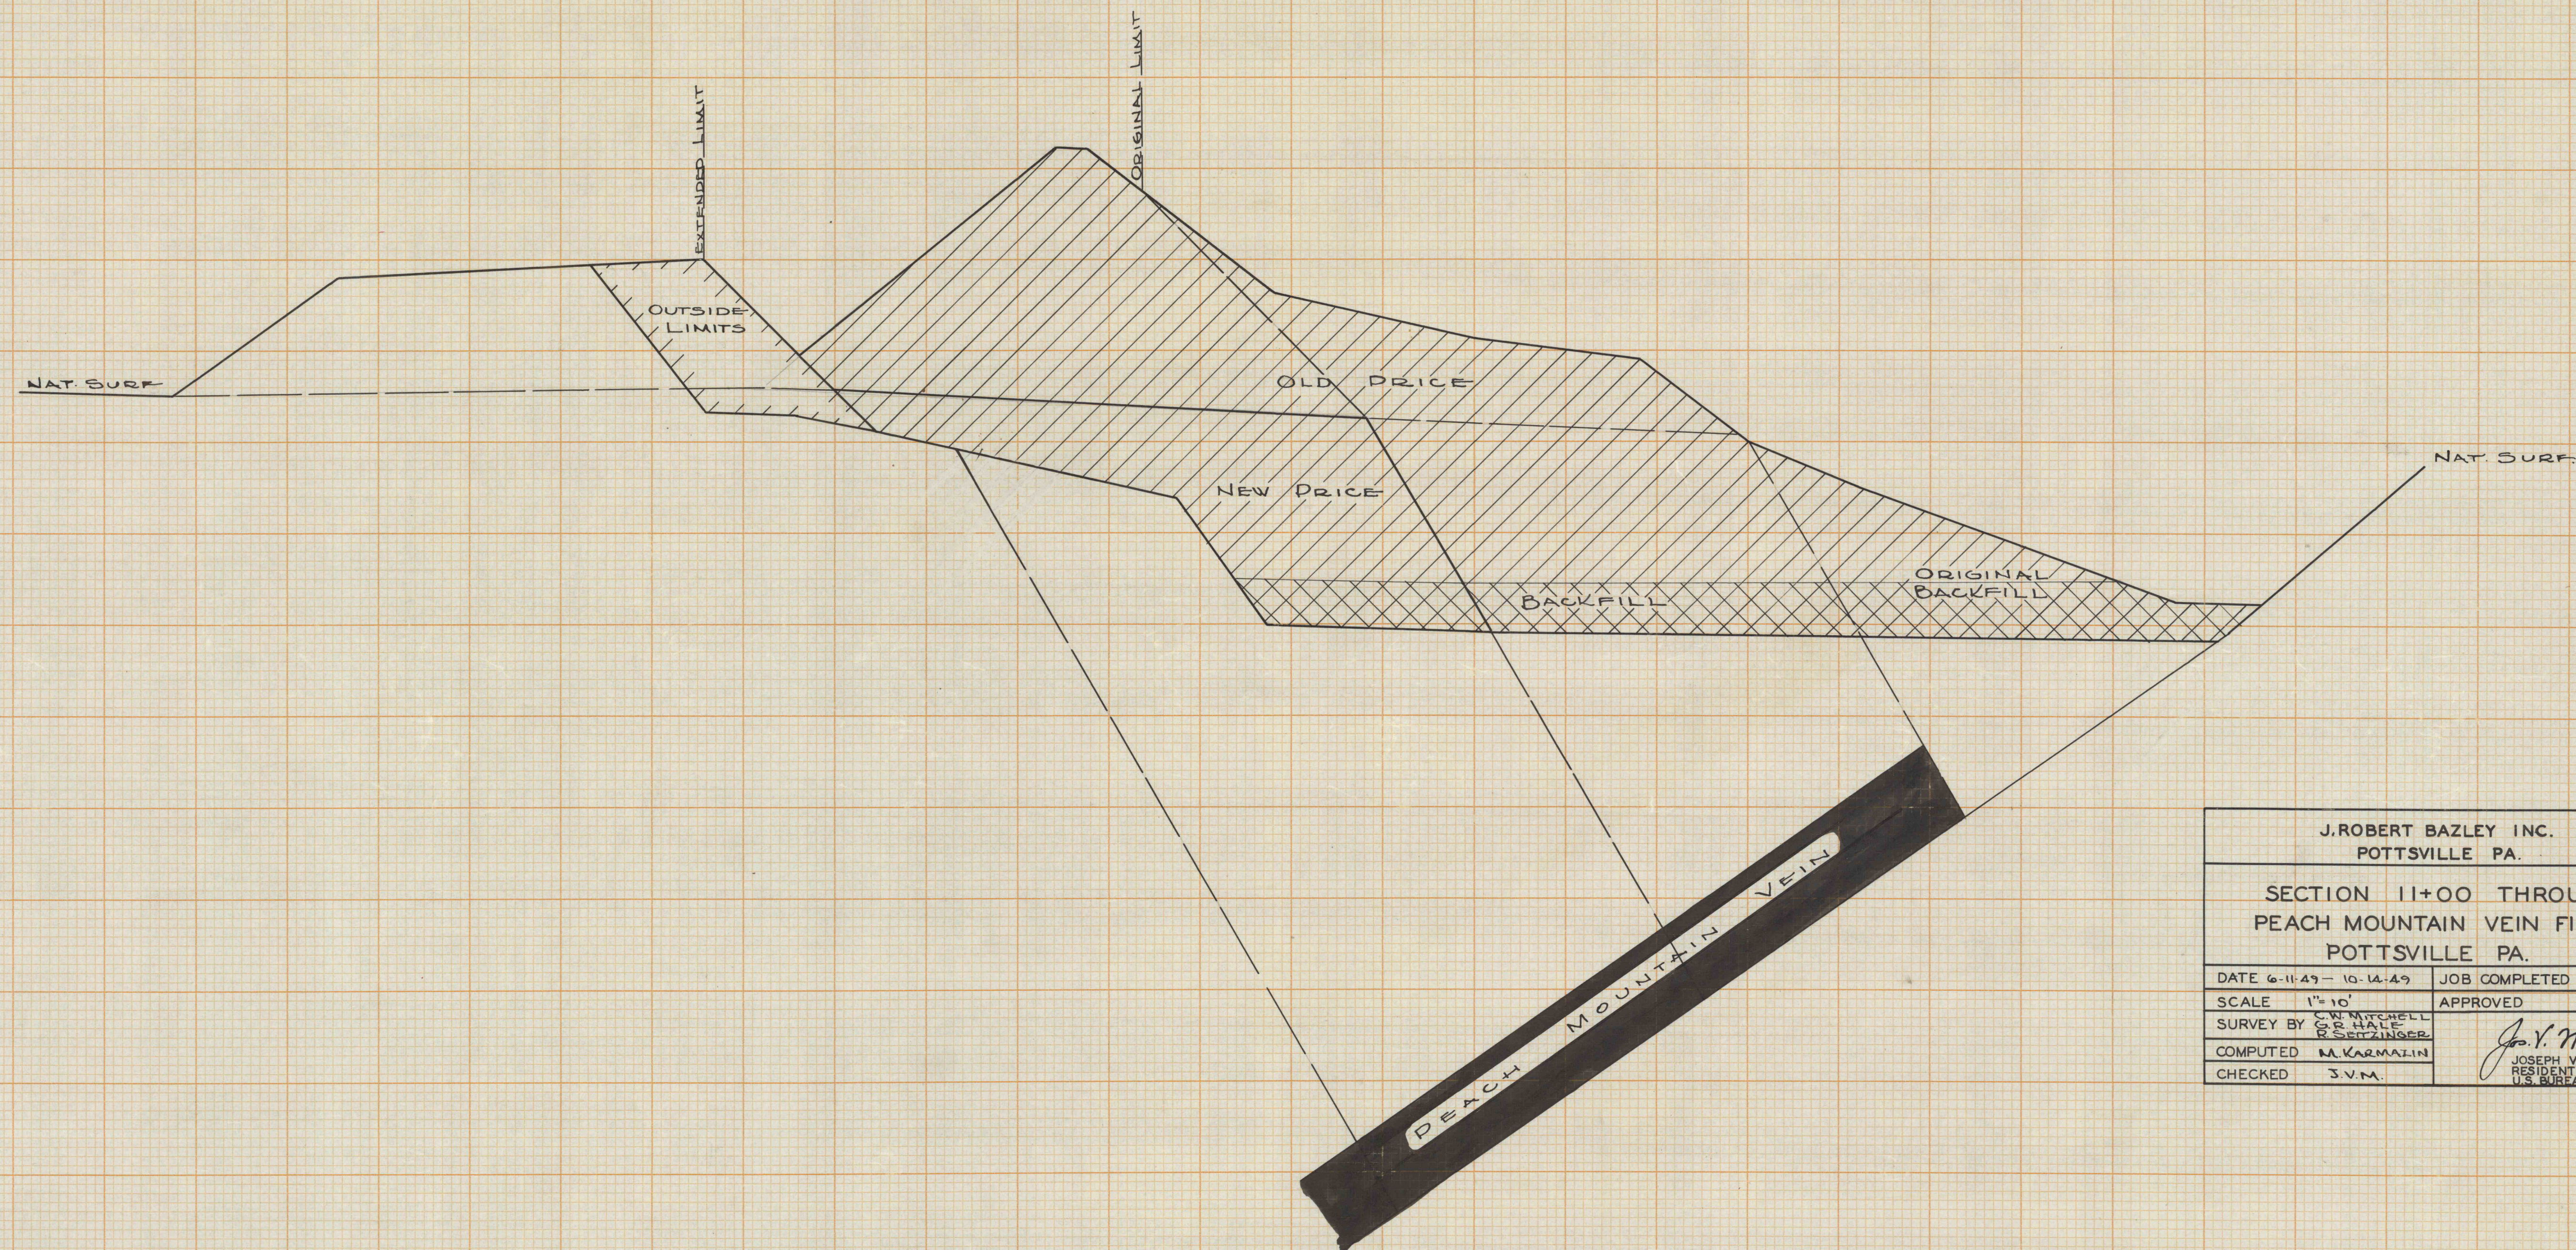

J. ROBERT BAZLEY INC. POTTSVILLE PA.	
SECTION 11+00 THROUGH PEACH MOUNTAIN VEIN FIRE POTTSVILLE PA.	
DATE 6-11-49 - 10-14-49	JOB COMPLETED 10-14-49
SCALE 1"=10'	APPROVED
SURVEY BY C.W. MITCHELL OR HALE P. SETZINGER	<i>Joe V. Mather</i> JOSEPH V. MATHER RESIDENT ENGINEER U.S. BUREAU OF MINES
COMPUTED M. KARMAZIN	
CHECKED J.V.M.	