


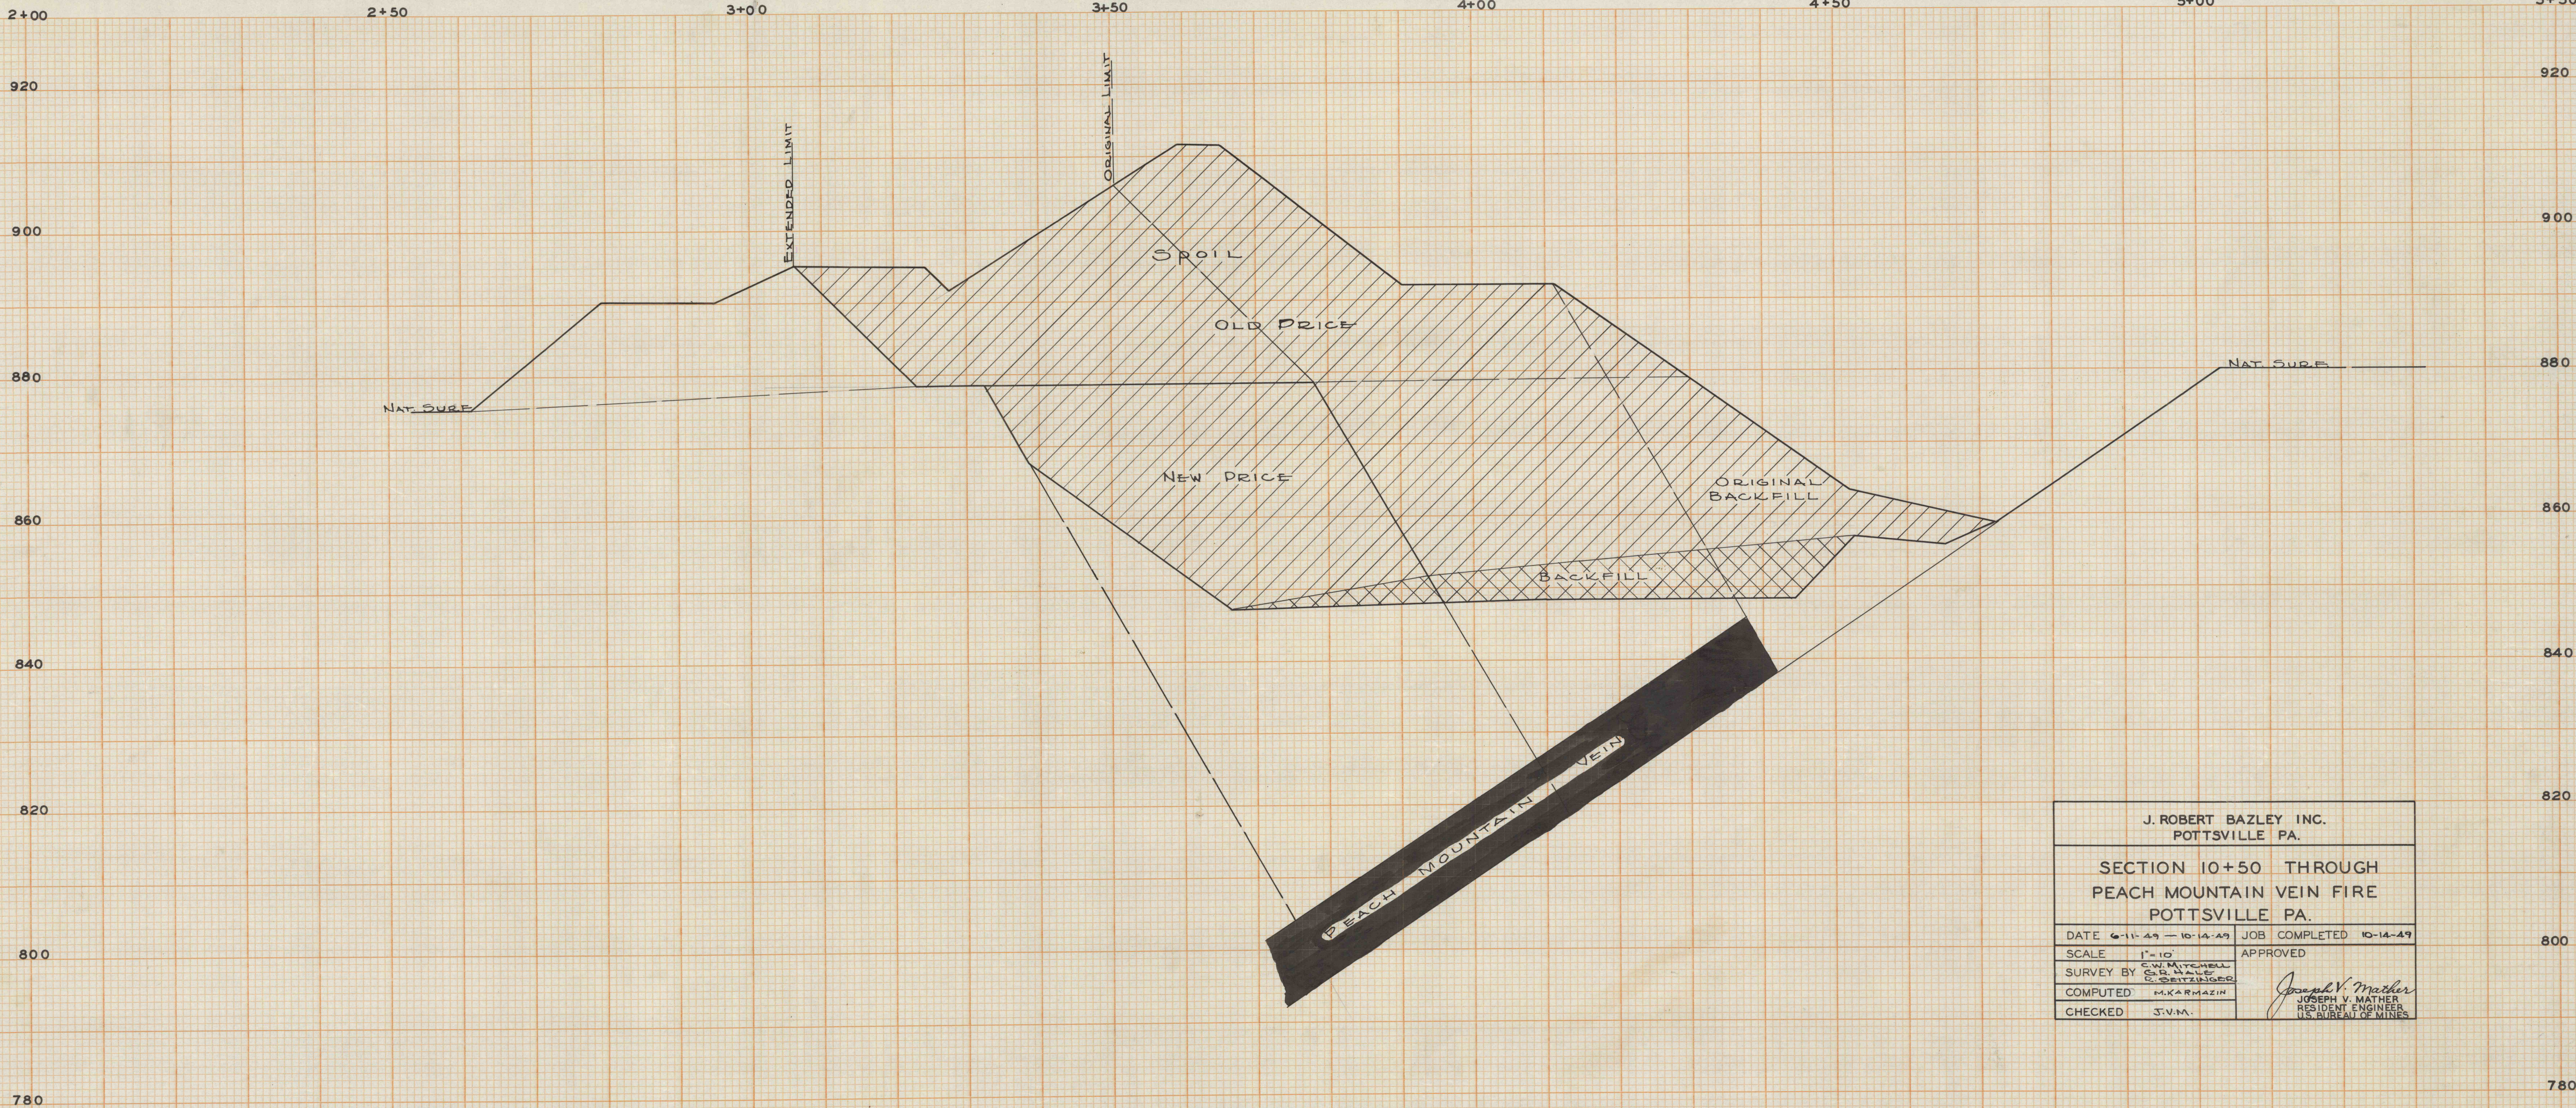

J. ROBERT BAZLEY INC. POTTSVILLE PA.	
SECTION 10+50 THROUGH PEACH MOUNTAIN VEIN FIRE POTTSVILLE PA.	
DATE 6-11-49 - 10-14-49	JOB COMPLETED 10-14-49
SCALE 1" = 10'	APPROVED
SURVEY BY C.W. MITCHELL C.B. HAYES C. DETZEN	<i>Joseph V. Mather</i> JOSEPH V. MATHER RESIDENT ENGINEER U.S. BUREAU OF MINES
COMPUTED M.K. RMAZIN	
CHECKED J.V.M.	