
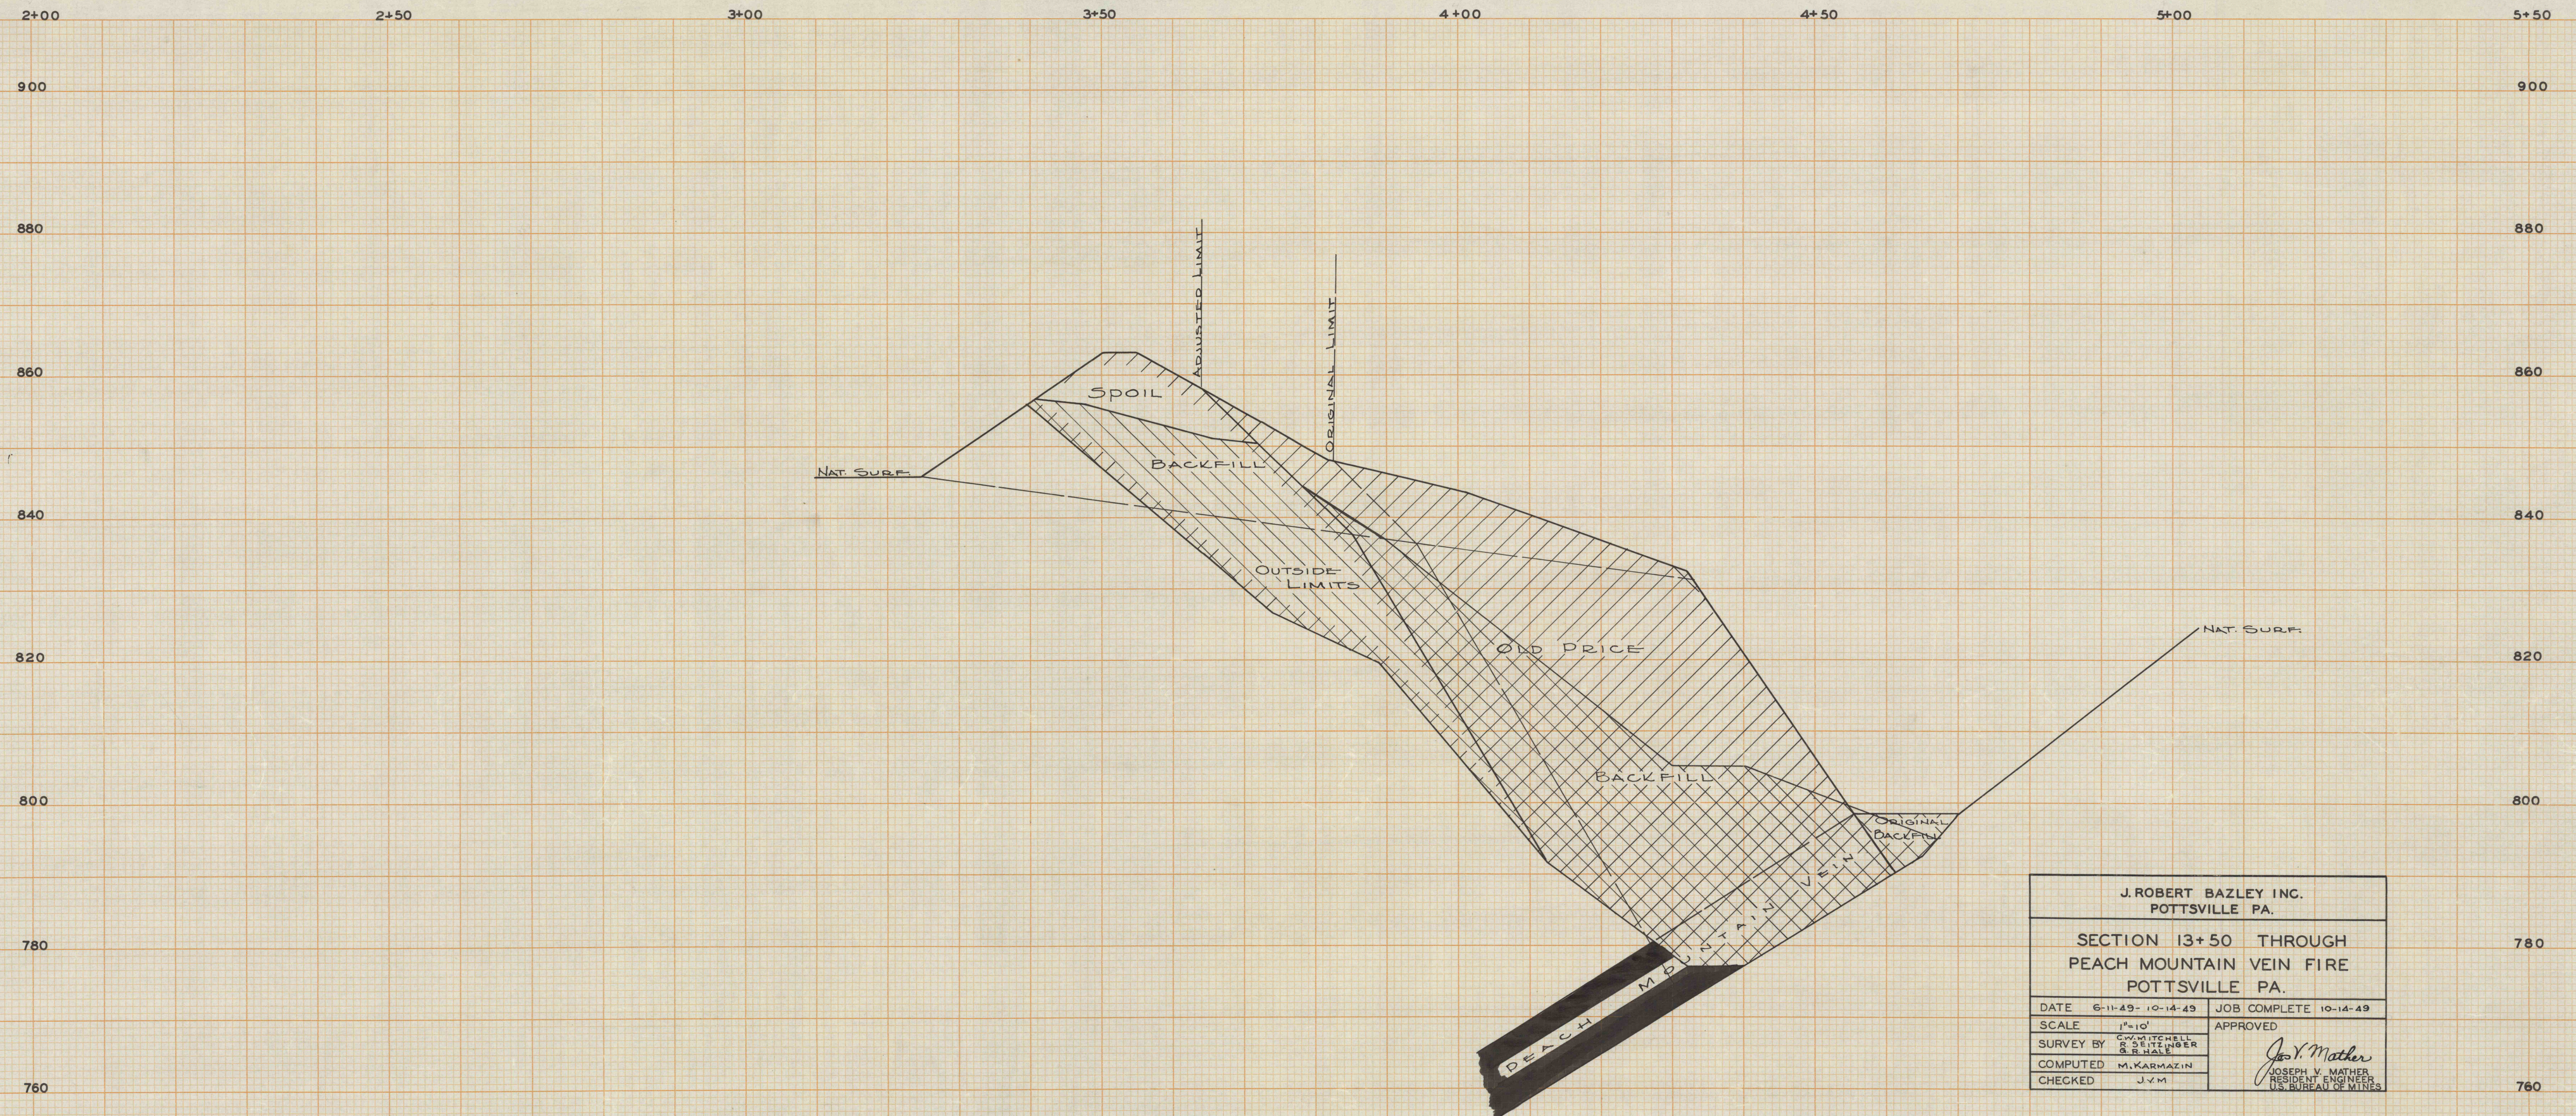


SECTION 13+50

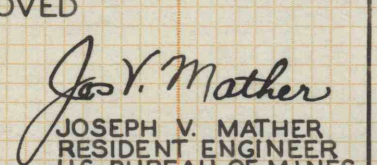

J. ROBERT BAZLEY INC. POTTSVILLE PA.			
SECTION 13+50 THROUGH PEACH MOUNTAIN VEIN FIRE POTTSVILLE PA.			
DATE	6-11-49-10-14-49	JOB COMPLETE	10-14-49
SCALE	1"=10'	APPROVED	
SURVEY BY	C. W. MITCHELL & S. EITZINGER & R. HALE	 JOSEPH V. MATHER RESIDENT ENGINEER U.S. BUREAU OF MINES	
COMPUTED	M. KARMAZIN		
CHECKED	J. V. M.		