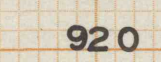


$2 + 00$ $2 + 50$

3+00

 $3+50$ $4+00$ $4 + 50$ $5 + 00$ $5 + 50$ 

900

880

860

840

820

800

920

900


880

860

840

820

800

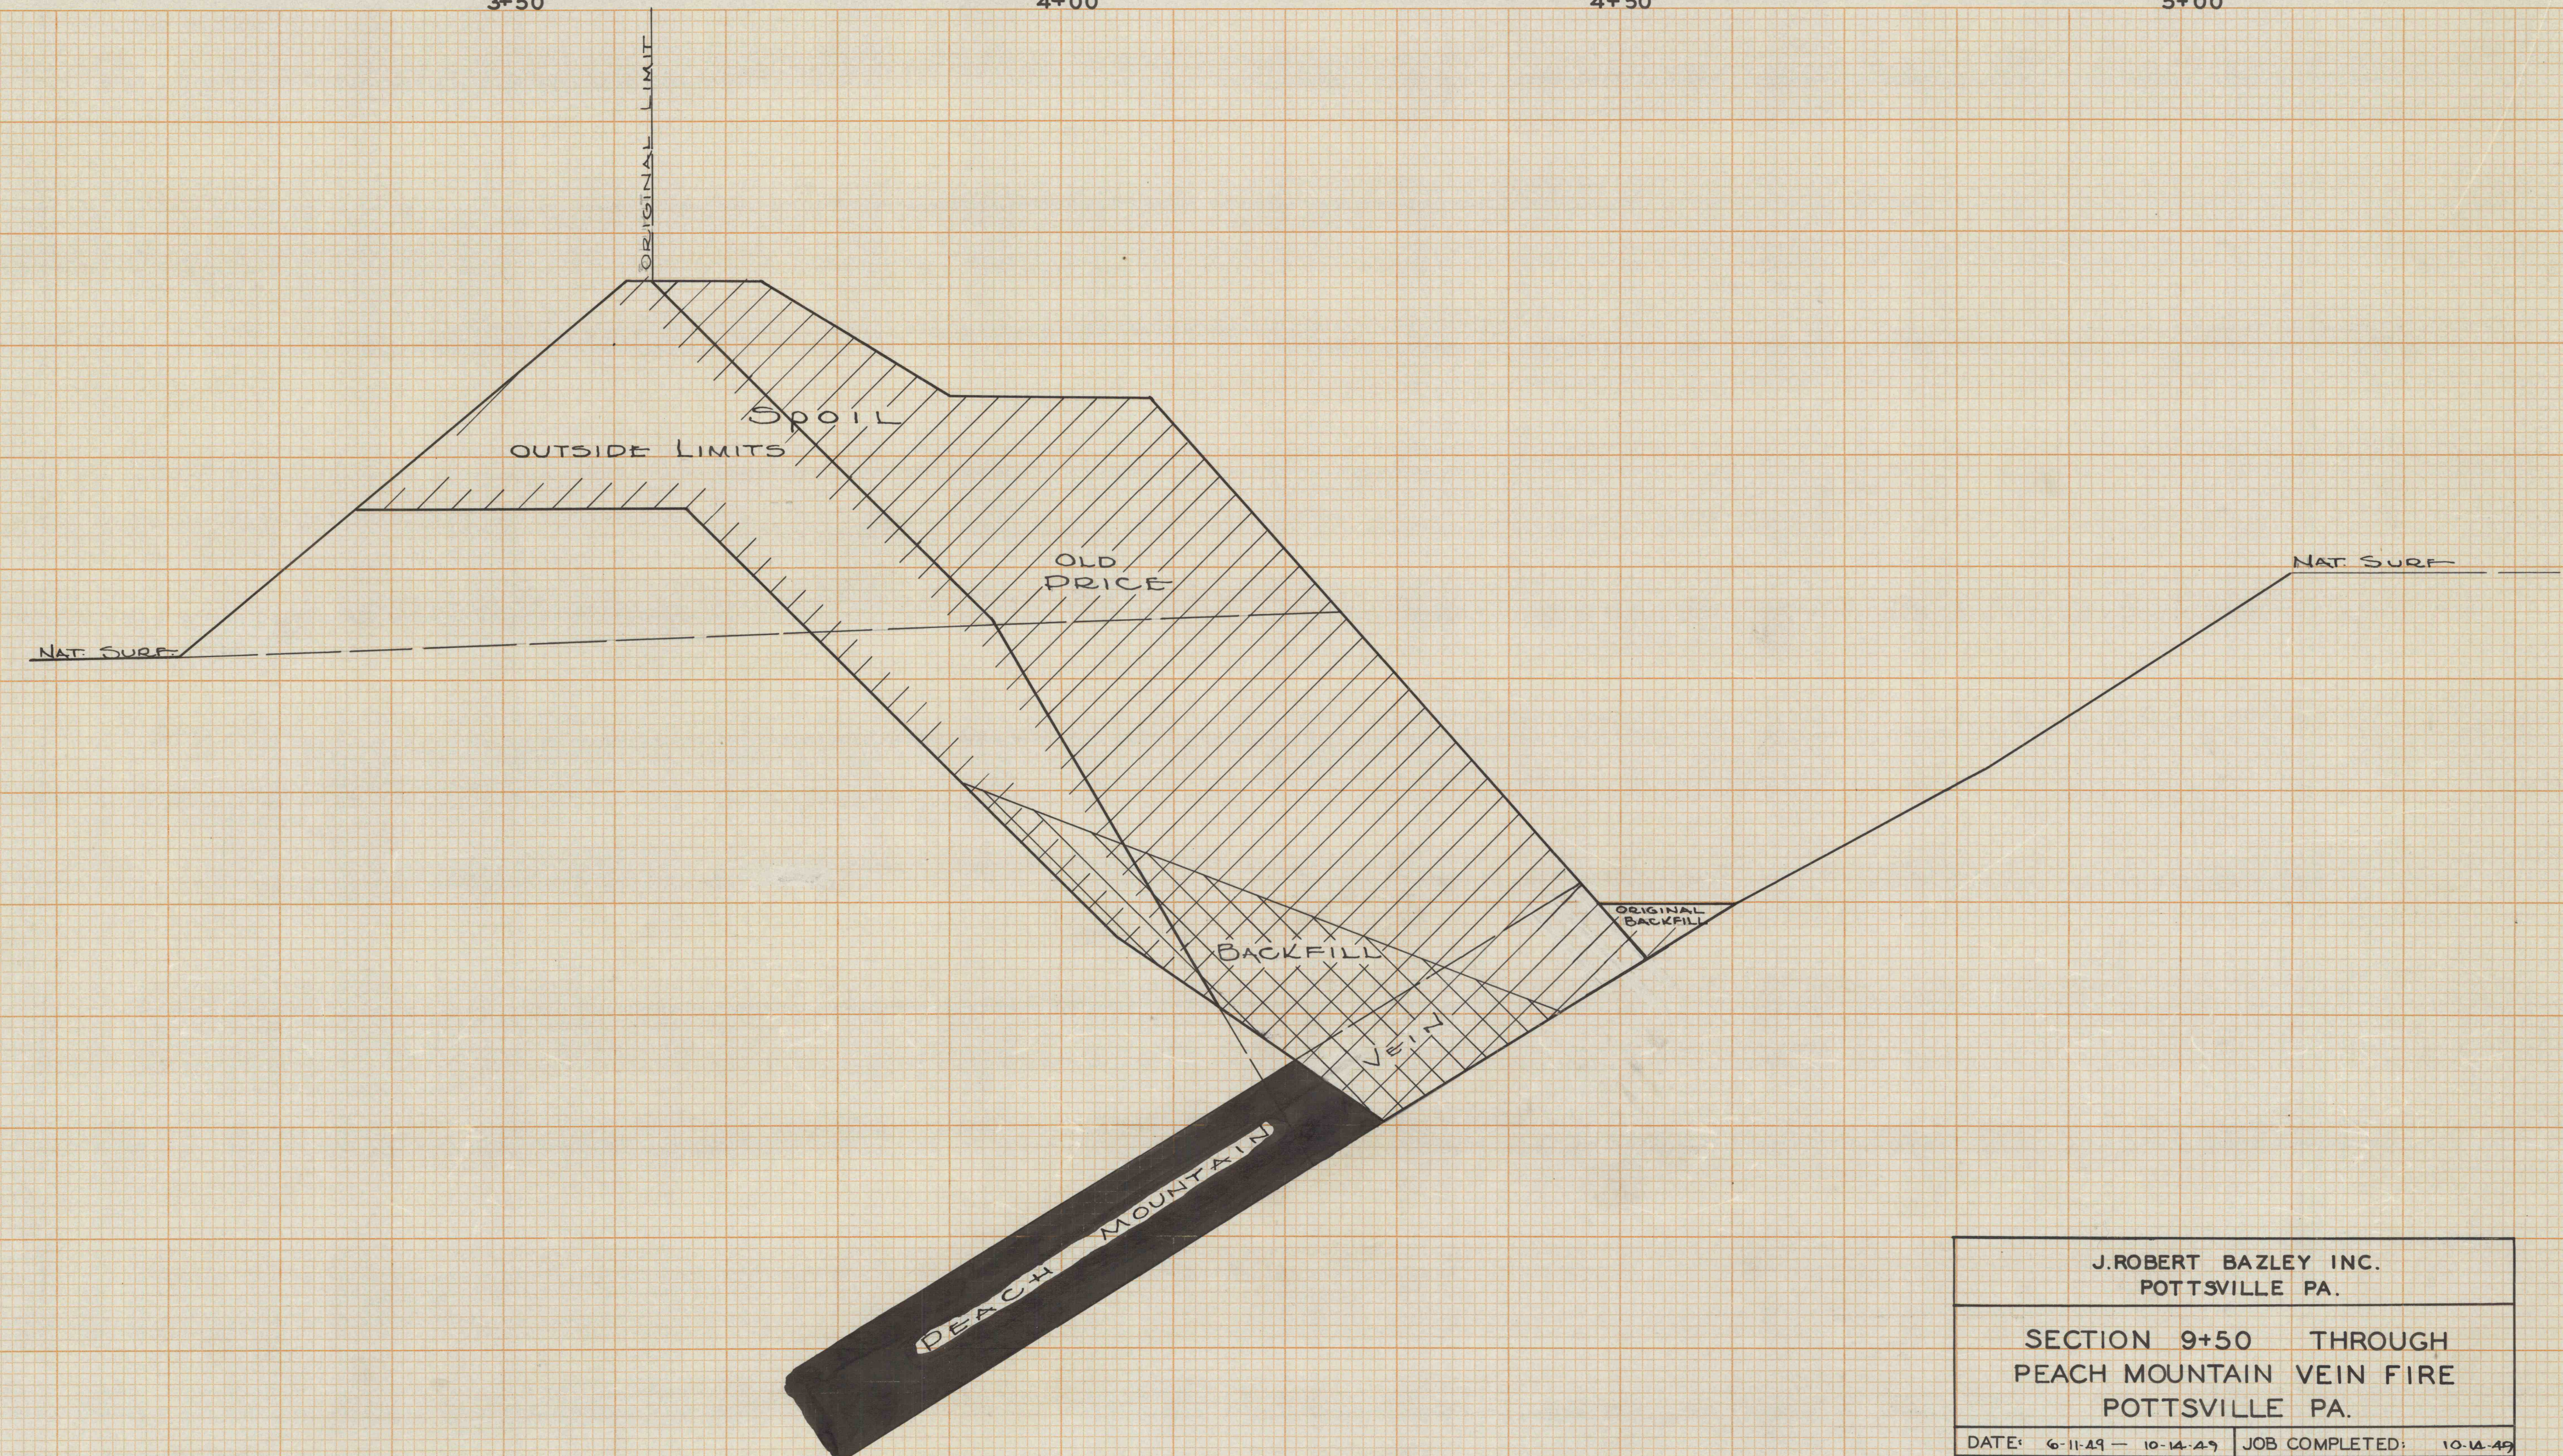

J.ROBERT BAZLEY INC.
POTTSVILLE PA.

SECTION 9+50 THROUGH
PEACH MOUNTAIN VEIN FIRE
POTTSVILLE PA.

DATE: 6-11-49 — 10-14-49

9 JOB COMPLETED: 10-12-49

SCALE: = 1" = 10' - 0"

SURVEYS BY C.W. MITCHELL
G.R. HALE

APPROVED:

COMPUTED: M. KARMAZIN

JOSEPH V. MATHER
RESIDENT ENGINEER
U.S. BUREAU OF MINES

CHECKED:	J.V.M.
----------	--------

"PERFECT" CROSS SECTION

"PERFECT" CROSS SECTION
10 X 10 = ONE INCH