


SECTION 12+50

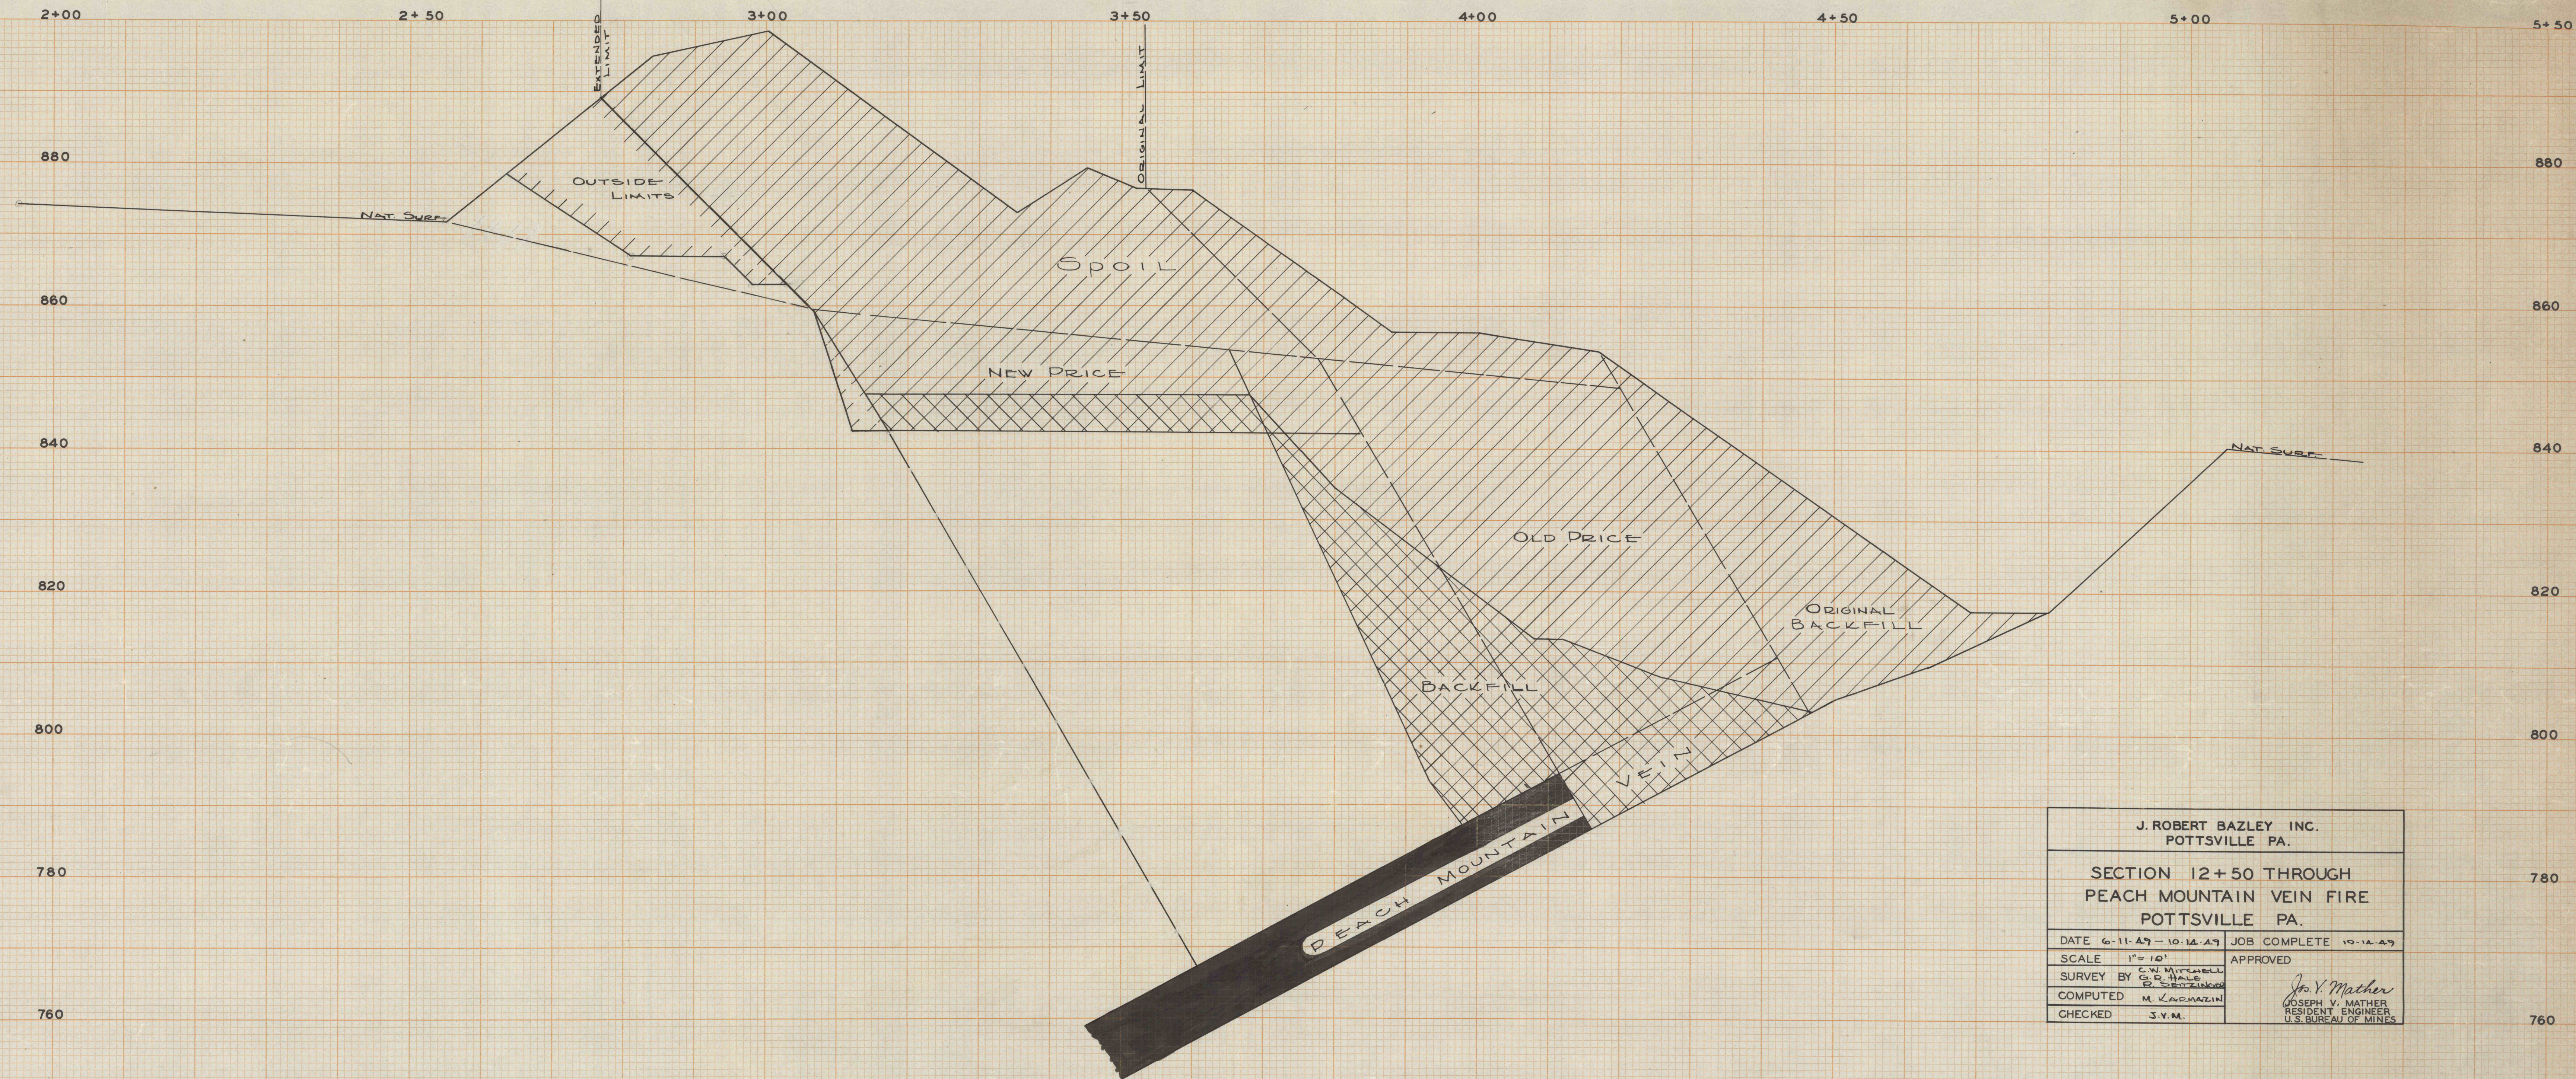

J. ROBERT BAZLEY, INC. POTTSVILLE PA.	
SECTION 12+50 THROUGH PEACH MOUNTAIN VEIN FIRE POTTSVILLE PA.	
DATE 6-11-29 - 10-12-29	JOB COMPLETE 10-12-29
SCALE 1" = 10'	APPROVED
SURVEY BY C.W. MITCHELL G.D. HALE B. STICKLER	<i>Joseph V. Mather</i> JOSEPH V. MATHER RESIDENT ENGINEER U.S. BUREAU OF MINES
COMPUTED M. LACHARIN	
CHECKED J.V.M.	