


2+00 2+50 3+00 3+50 SECTION 8+ 50 4+00 4+ 50 5+00 5+50

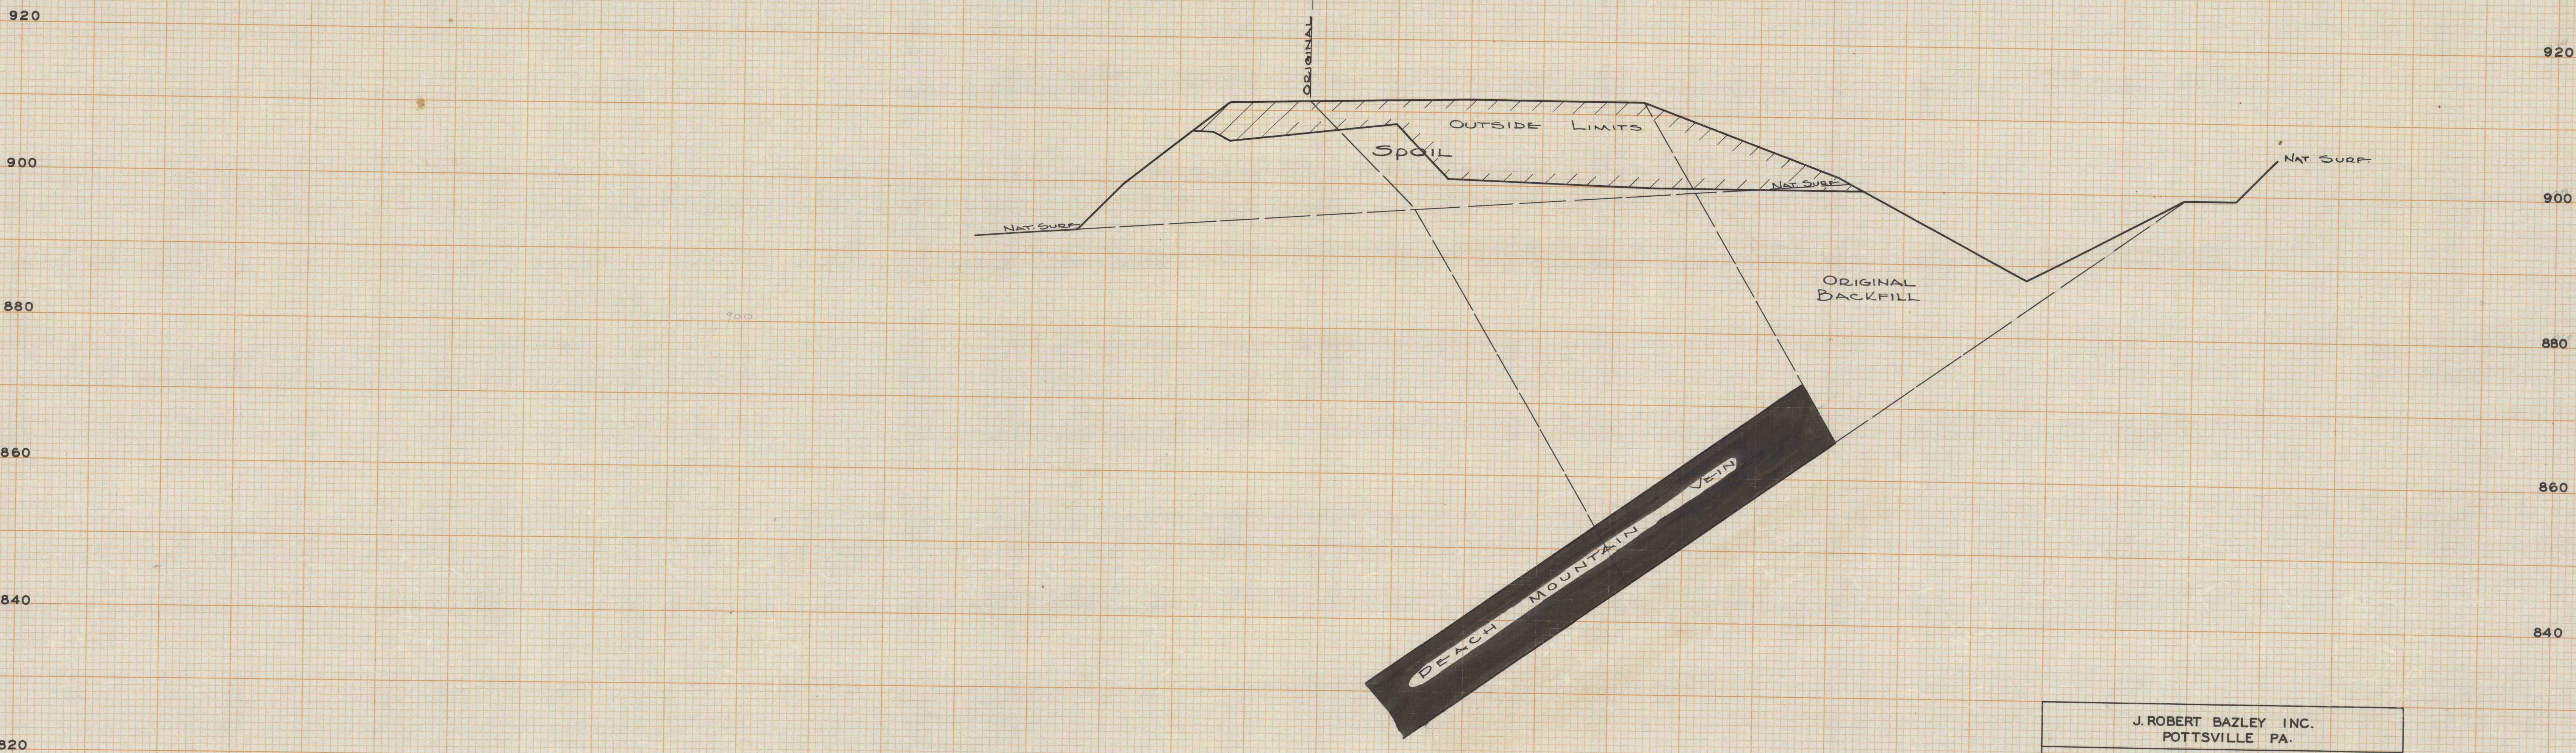

J. ROBERT BAZLEY INC. POTTSVILLE PA.	
SECTION 8+ 50 THROUGH PEACH MOUNTAIN VEIN FIRE POTTSVILLE PA.	
DATE 6-11-49 — 10-14-49	JOB COMPLETED: 10-14-49
SCALE 1"=10'	APPROVED:
SURVEY BY E.W. MITCHELL G.D. HALL R. BEITZINGER	J.V. Mather JOSEPH V. MATHER RESIDENT ENGINEER U.S. BUREAU OF MINES
COMPUTED M. KARMAZIN	
CHECKED J.V.M.	