


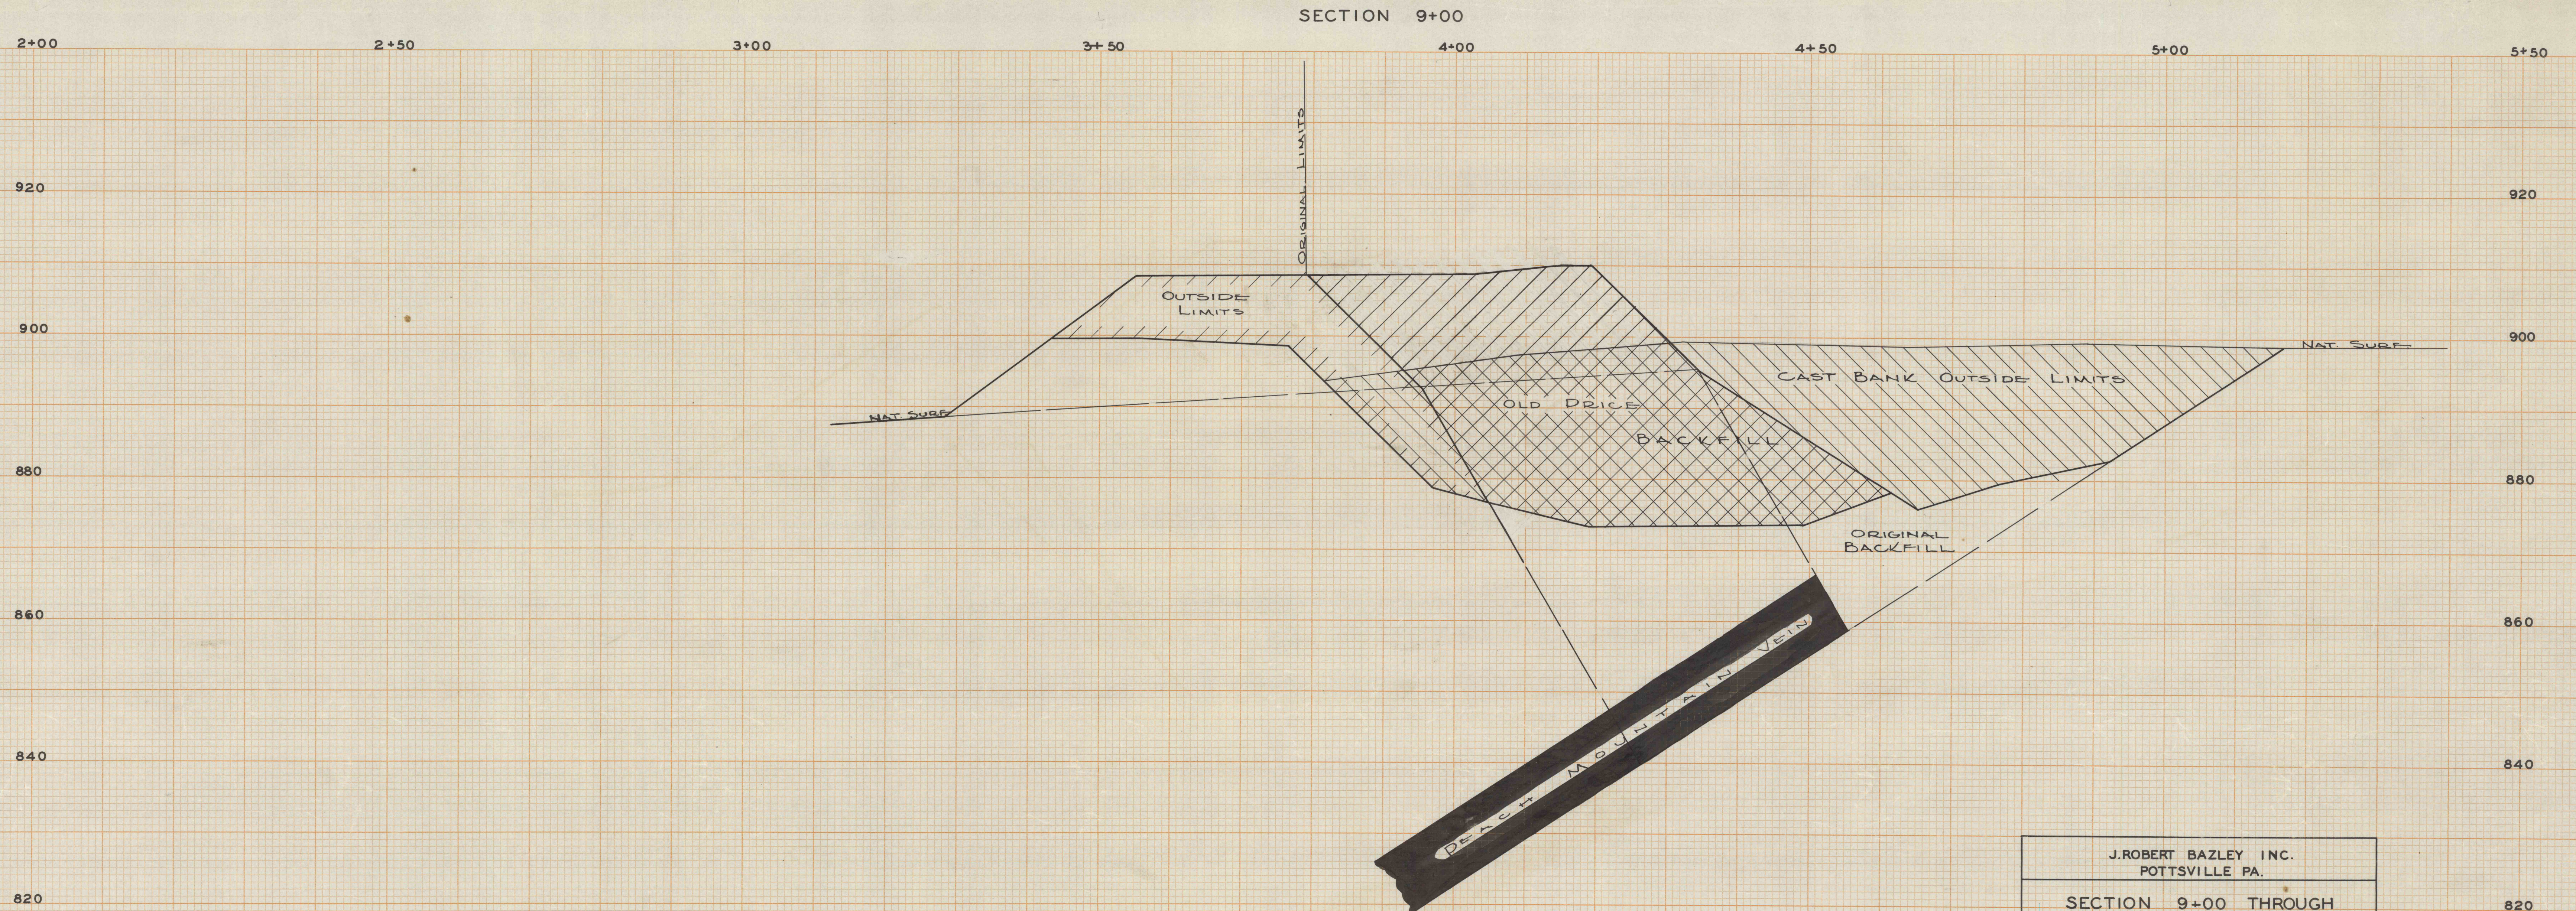

J. ROBERT BAZLEY INC. POTTSVILLE PA.	
SECTION 9+00 THROUGH PEACH MOUNTAIN VEIN FIRE POTTSVILLE PA.	
DATE 6-11-49 — 10-14-49	JOB COMPLETED 10-14-49
SCALE 1"=10'	APPROVED:
SURVEY BY C.W. MITCHELL G.D. HALE R. DETZINGER	JOSEPH V. MATHER RESIDENT ENGINEER U.S. BUREAU OF MINES
COMPUTED M. KARMAN	
CHECKED S.V.M.	