

SECTION 10+00

2+00

2+50

3+00

3+50

4+00

4+50

5+00

5+50

920

900

880

860

840

820

800

920

900


880

860

840

820

800

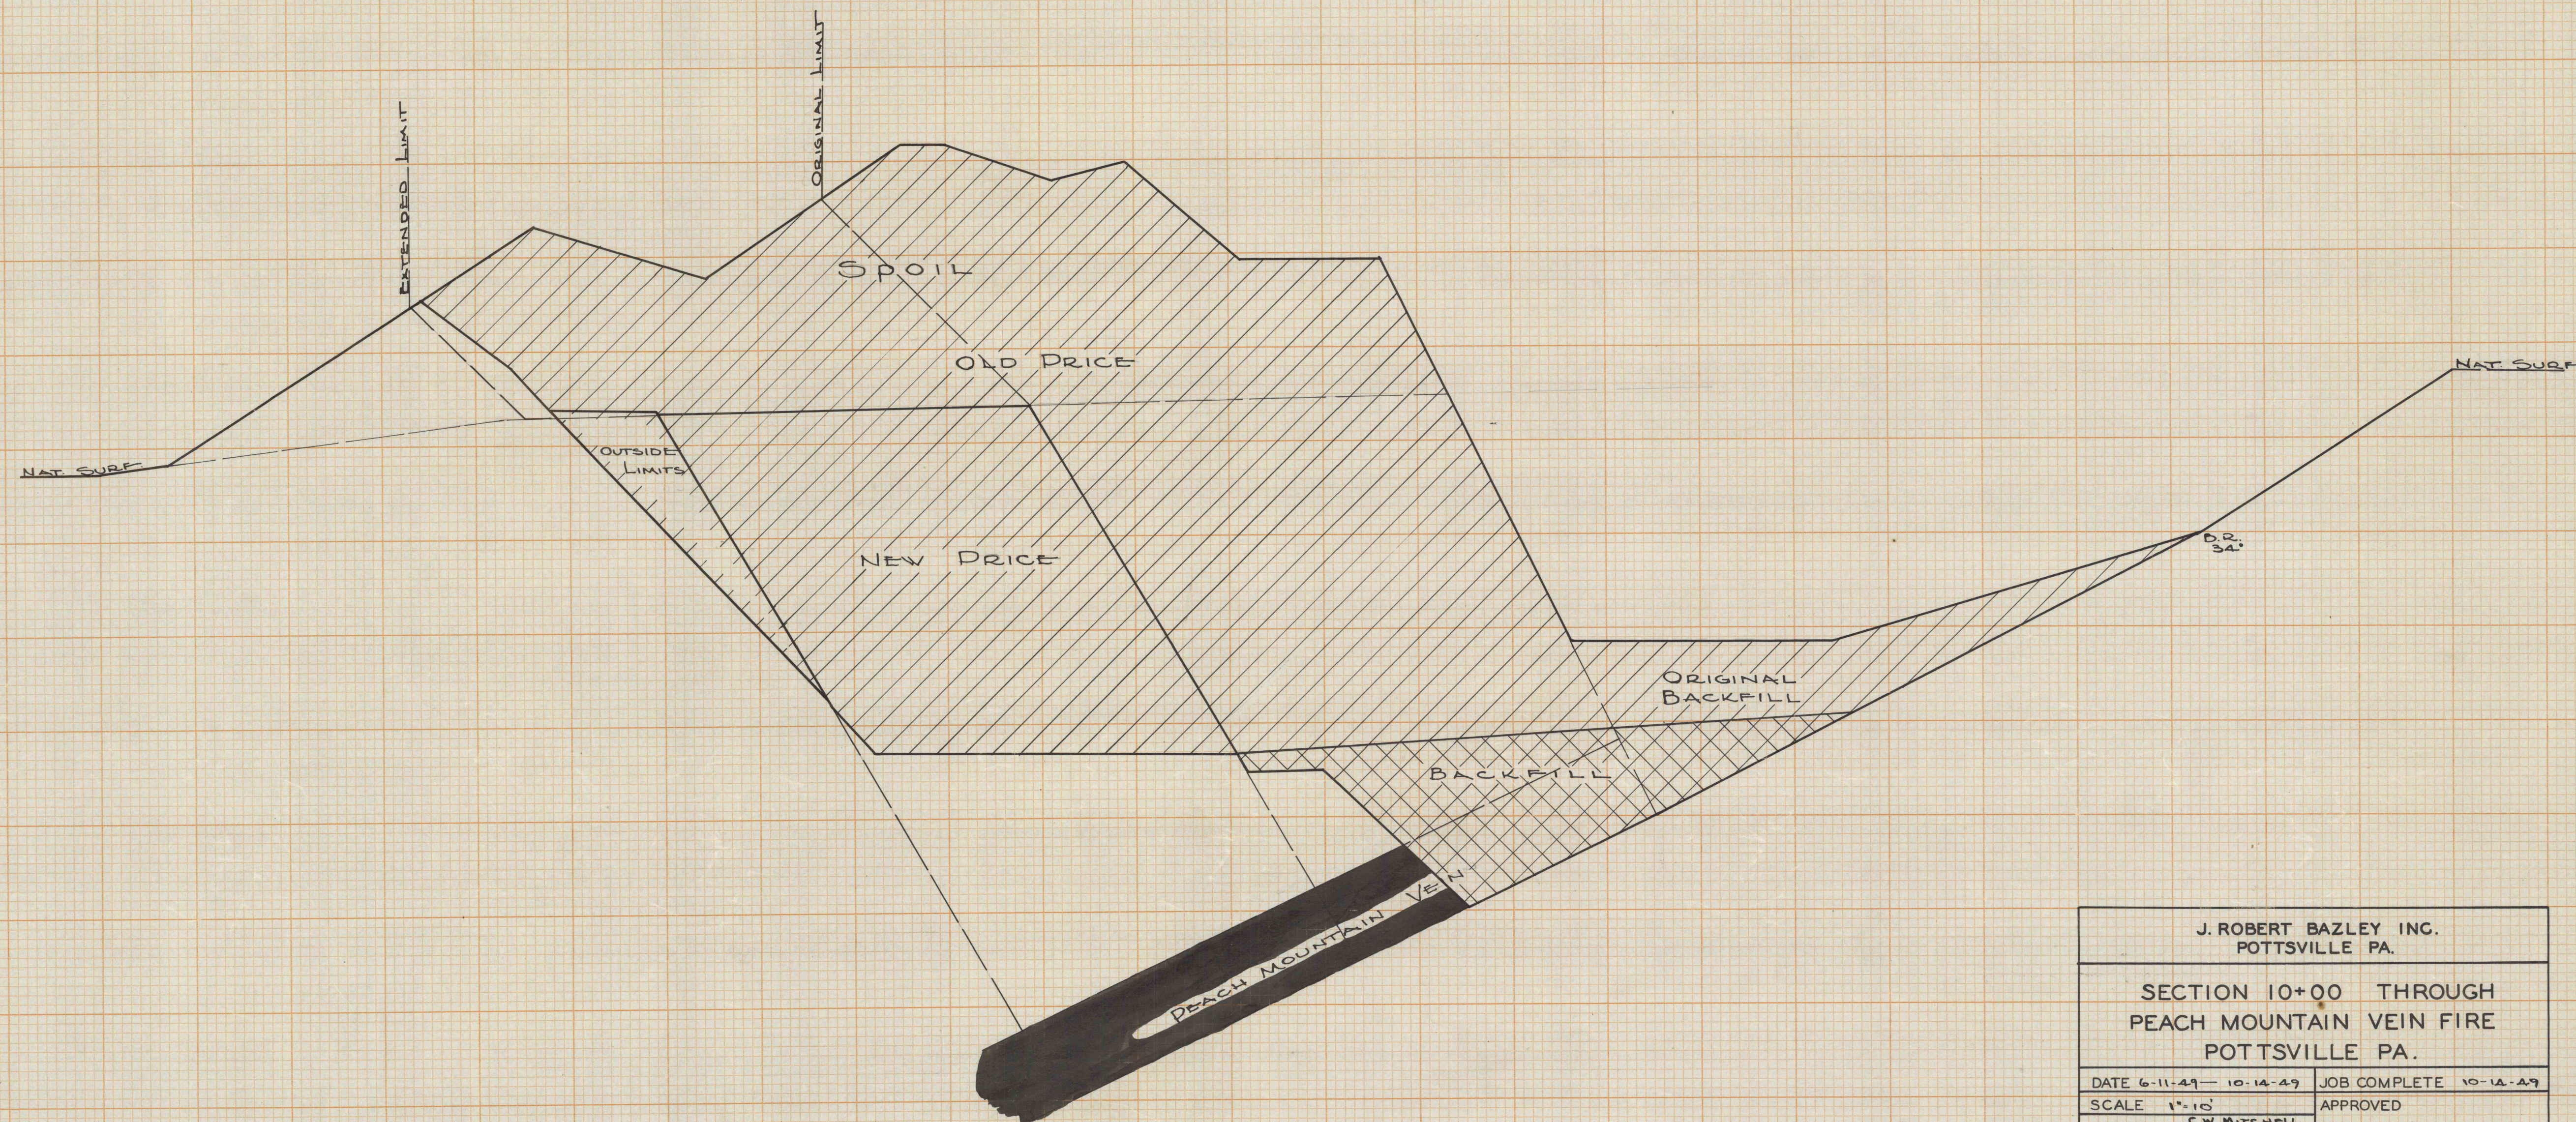

J. ROBERT BAZLEY INC. POTTSVILLE PA.	
SECTION 10+00 THROUGH PEACH MOUNTAIN VEIN FIRE POTTSVILLE PA.	
DATE 6-11-49 - 10-12-49	JOB COMPLETE 10-12-49
SCALE 1"=10'	APPROVED
SURVEY BY E.W. MITCHELL G.S. HALL B. EITZINGER	JOSEPH V. MATHER RESIDENT ENGINEER U.S. BUREAU OF MINES
COMPUTED M. KORMAZIN	
CHECKED J.V.M.	