

SECTION 9 + 50

2+00

2+50

3+00

3+50

4+00

4+50

5+00

5+50

920

900

880

860

840

820

800

920

900


880

860

840

820

800

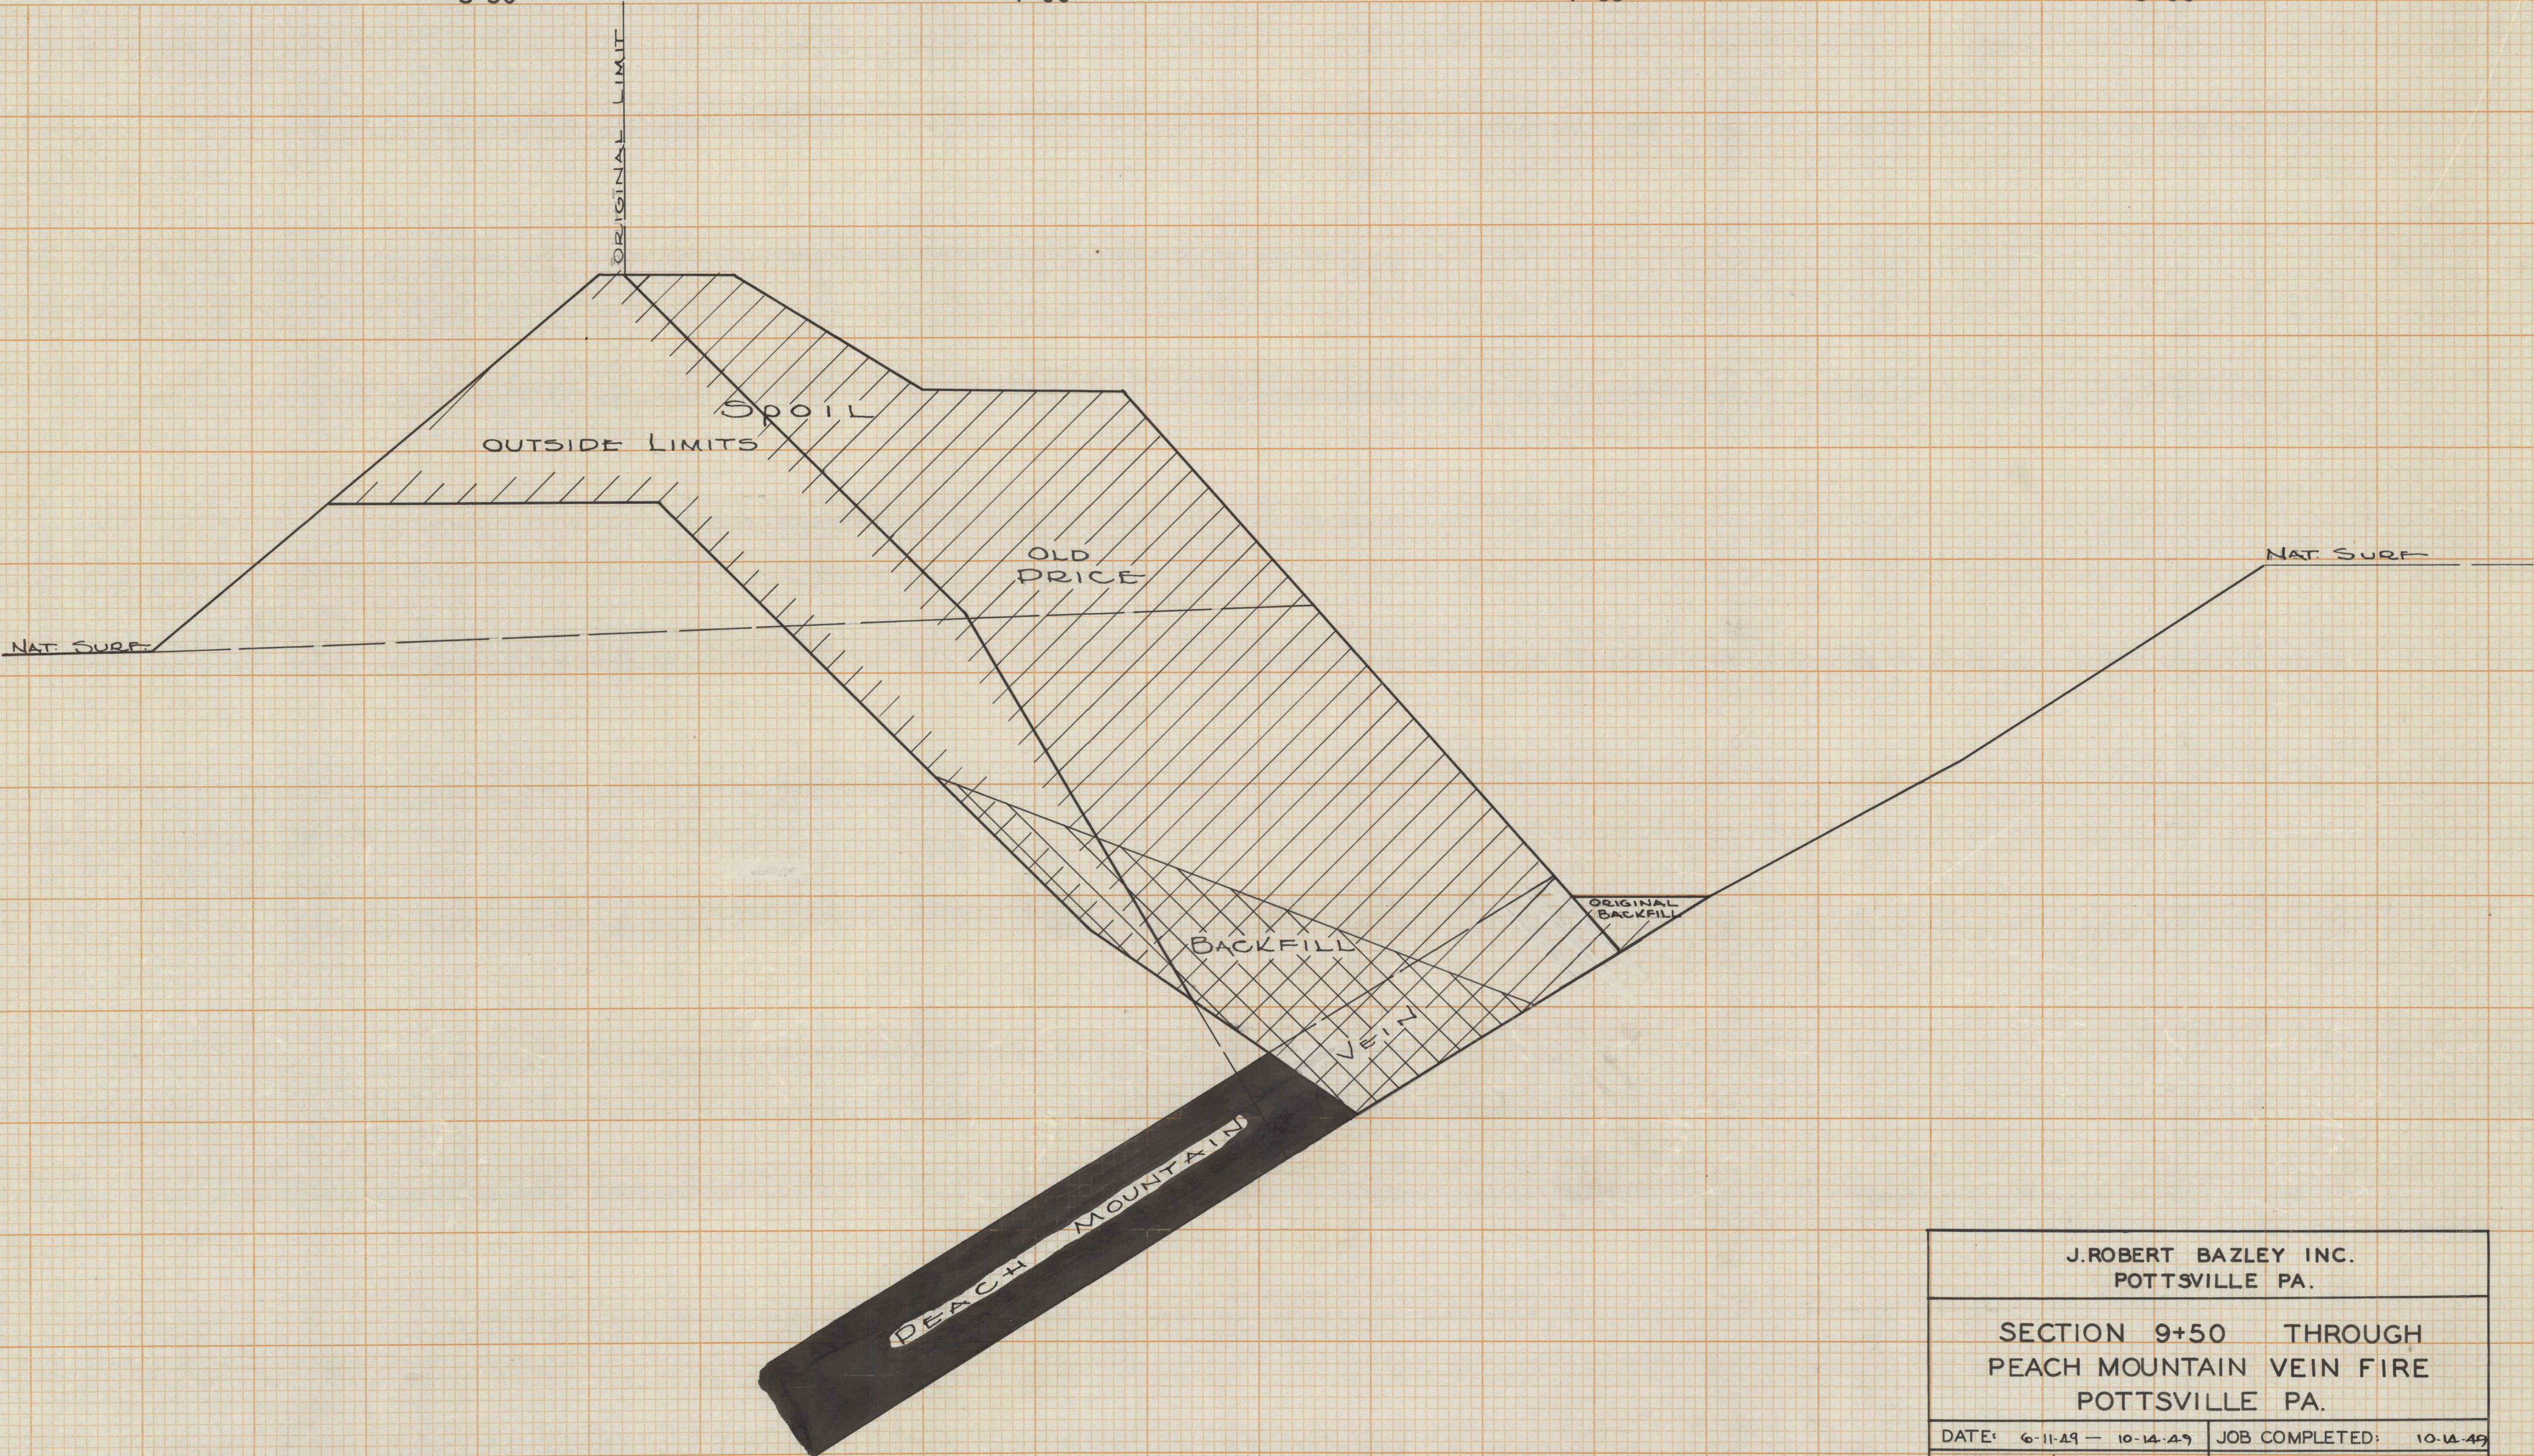

J. ROBERT BAZLEY INC. POTTSVILLE PA.	
SECTION 9+50 THROUGH PEACH MOUNTAIN VEIN FIRE POTTSVILLE PA.	
DATE: 6-11-49 - 10-14-49	JOB COMPLETED: 10-14-49
SCALE: 1" = 10'-0"	APPROVED:
SURVEYS BY: C.W. MITCHELL G.D. HALE P. SEITZINGER	<i>Joseph V. Mather</i> JOSEPH V. MATHER RESIDENT ENGINEER U.S. BUREAU OF MINES
COMPUTED: M. KARMAZIN	
CHECKED: J.V.M.	