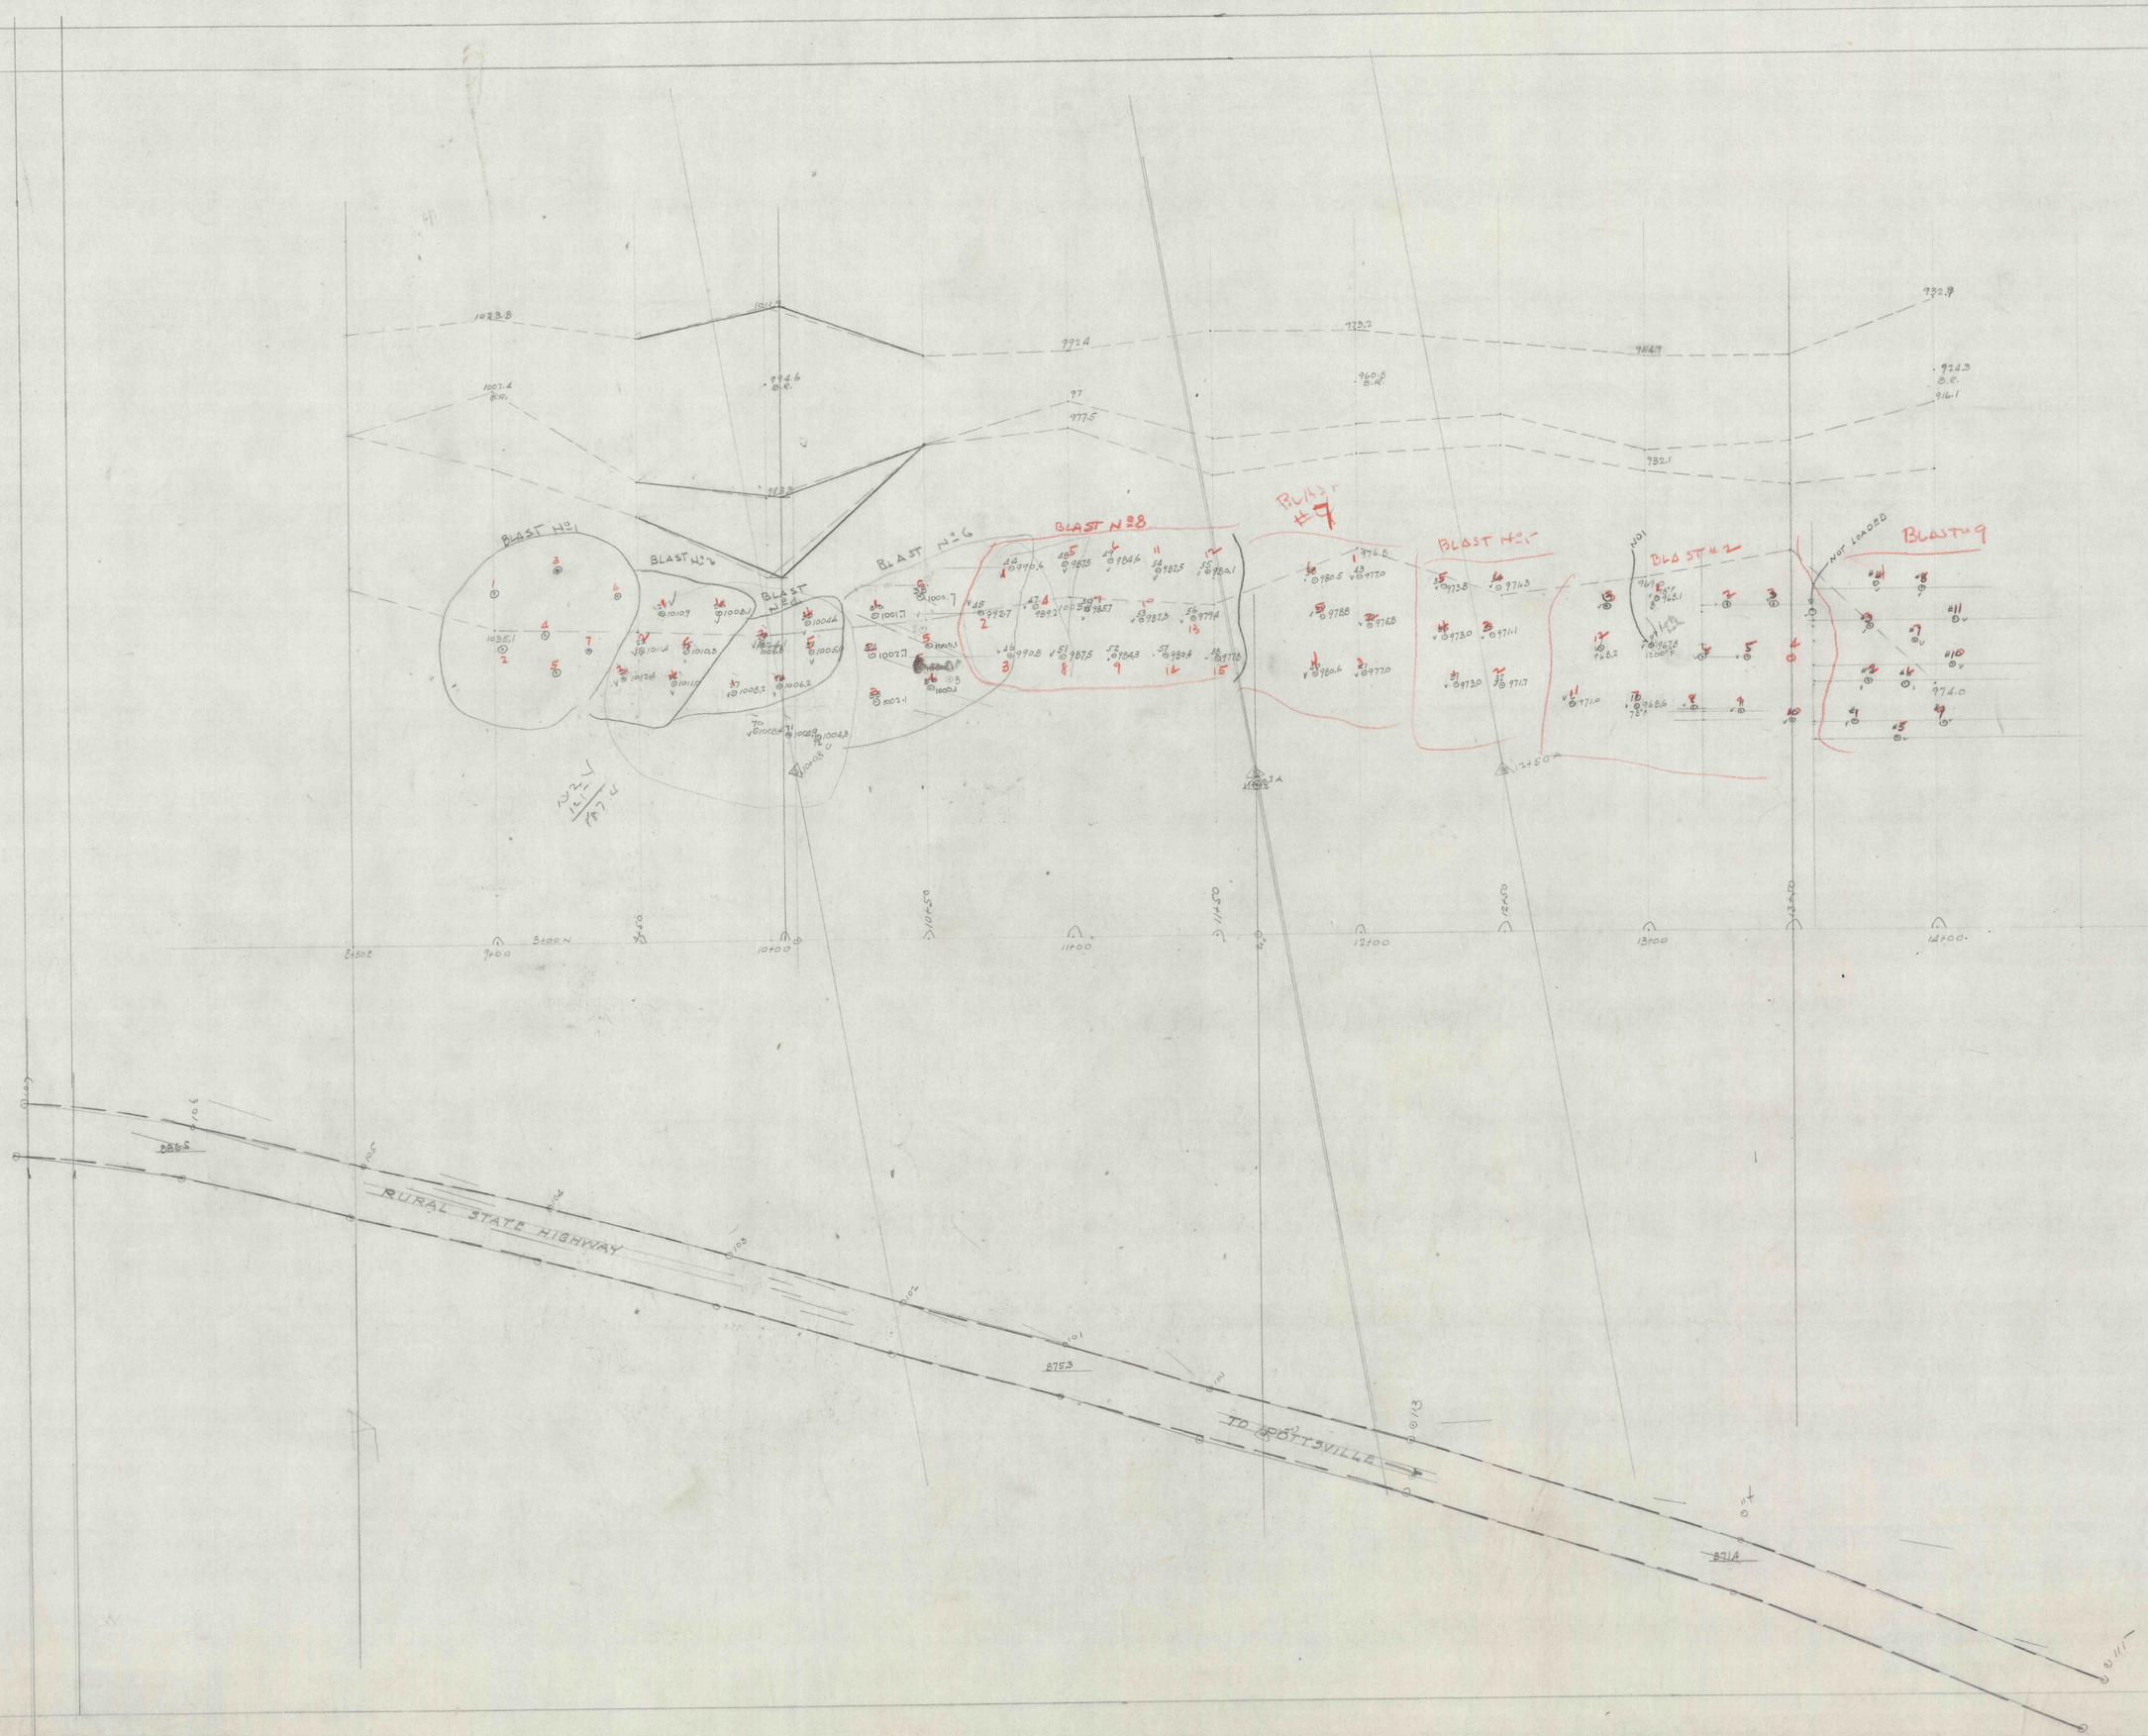
BLAST N°1
BLAST N°2
BLAST N°4
BLAST N°6
BLAST N°8
BLAST N°3
BLAST #2
NOT LOADED
BLAST N°9
RURAL STATE HIGHWAY
TO SPOTSVILLE
2753
2886
2718
9+00
10+00
11+00
12+00
13+00
14+00
3+00 N