


PEACH Mtn. FIRE JOB
J.R. BAZLEY CONT.
SCALE-1"=20'
AMERICAN CYANAMID COMPANY

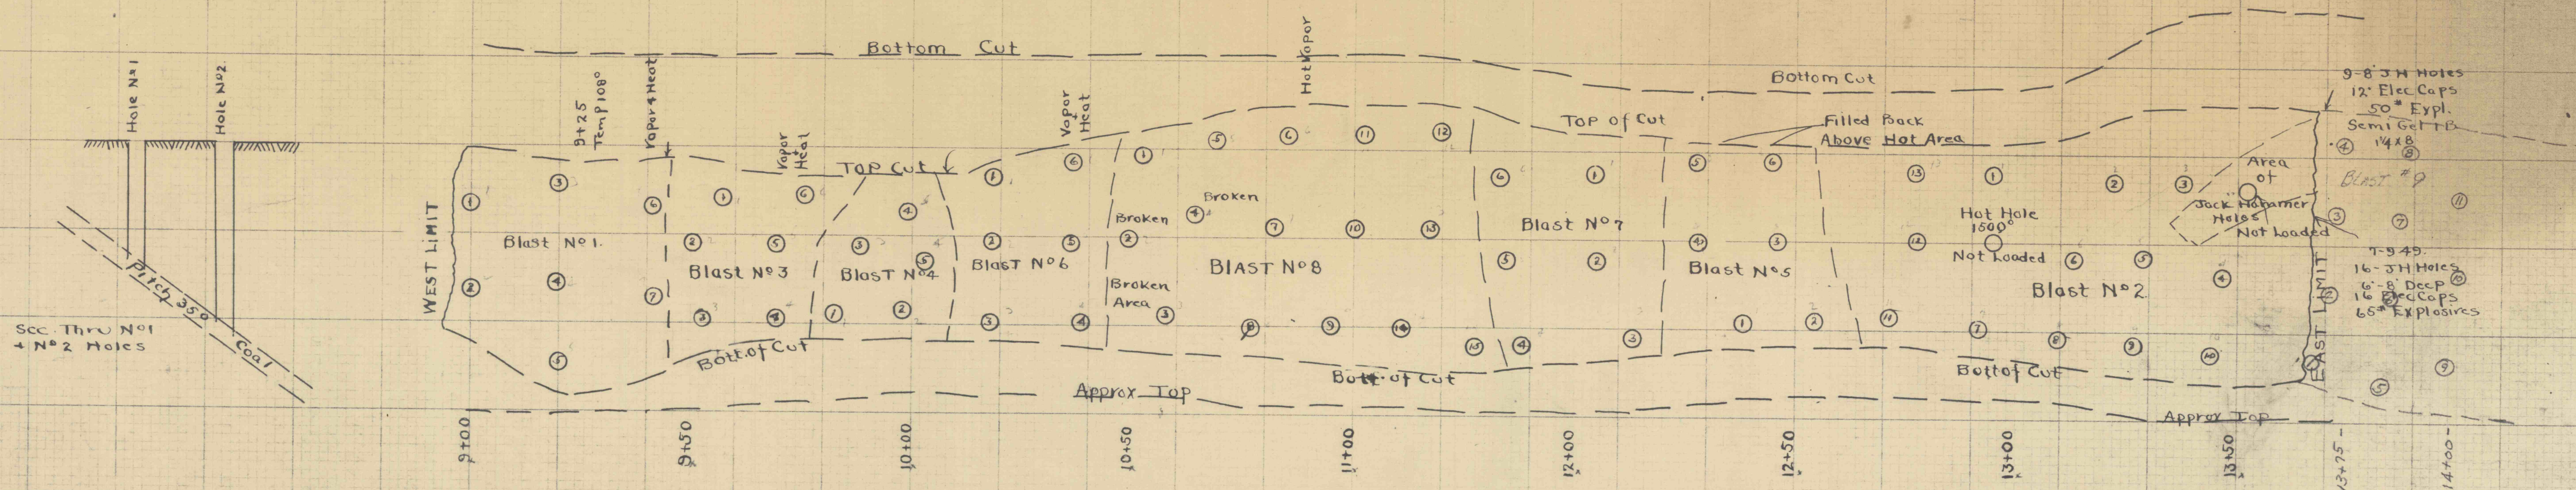


Blast No 1

Hole	Depth	Dyn	Cover	Temp
1	34	400	20	Less than 75°
2	42	500	23	
3	33	350	22	
4	39	450	21	
5	32	300	18	
6	38	450	18	
7	39	450	22	
247	2900			

Broken to +39'

270 Wire Bound Prima Cord
150' Reinforced for Trunk Line
Fired Electrically with 12' EBC
500' #14 Lead Wire, 10 Hole Twist
Battery 6-22-49 11:30 AM
Loaded Wertz Lorell-Morgan

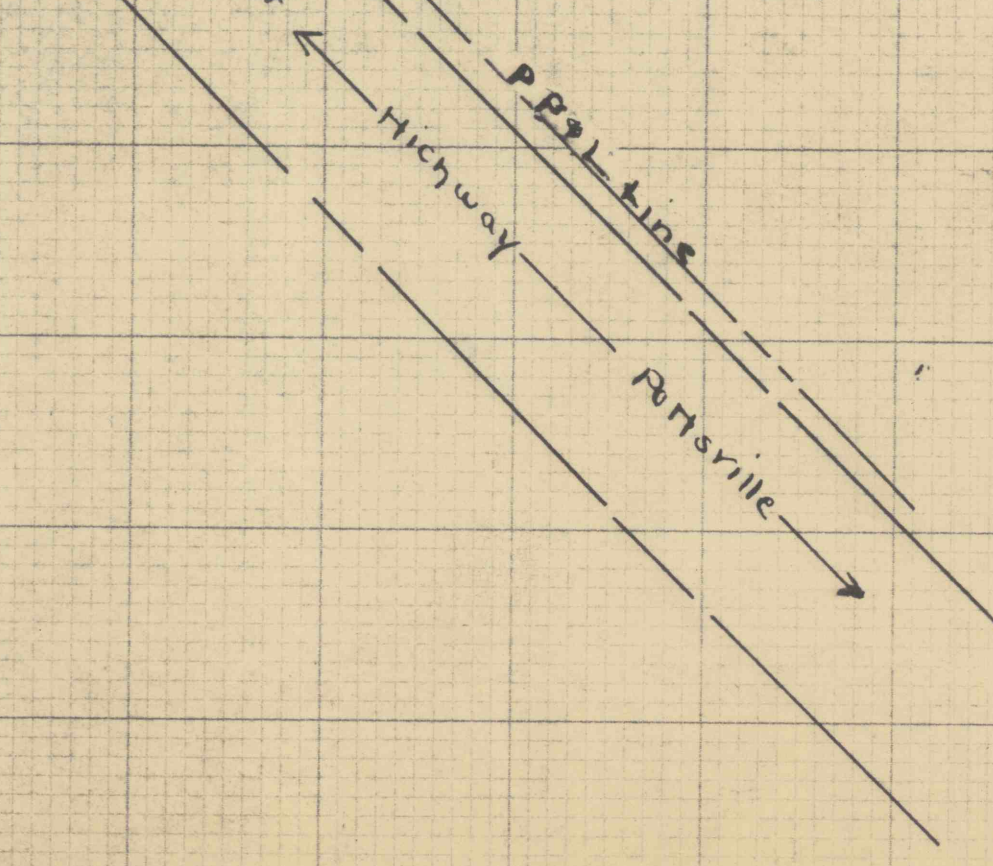

Blast No 3

Hole	Depth	Dyn	Cover	Temp
1	36	300	20	70°
2	36	350	21	90°
3	33	300	19	50°
4	37	350	19	65°
5	45	500	20	70°
6	38	400	18	180° at +38'
225	2200			115° at +38'

Blast Fired 6-24-49 - 12:55 PM
Loaded By Morgan
Wire Bound + Reinf Prima Cord

Blast No 4

Hole	Depth	Dyn	Cover	Temp
1	34	300	18	100°
2	30	250	18	100°
3	38	400	19	180°
4	31	250	18	210°
5	38	400	18	130°
171	1600			

Blast Fired 6-30-49 - 12:20 PM
Loaded By Morgan
Wire Bound + Reinf Prima Cord

Blast No 6 - 7-2-49

Hole	Depth	Dyn	Cover	Temp
1	36	350	20	180°
2	42	500	18	170°
3	31	250	18	100°
4	31	250	17	130°
5	37	400	17	200°
6	34	300	19	200°
211	2050			

Blast Fired 7-2-49 Time 10:05 AM
Loaded By Lorell-Morgan
Wire Bound + Reinf Prima Cord

Blast No 7

Hole	Depth	Dyn	Cover	Temp
1	39	400	19	200°
2	47	600	17	200°
3	36	350	18	135°
4	35	350	18	150°
5	47	550	19	175°
6	44	550	18	200°

Blast Fired 9-5-49
Time 12:30 PM
Wire Bound + Reinf
Loaded Wertz Lorell
1 Elec Cap Used
248' Depth 2800' Expl.

Blast No 8

Hole	Depth	Dyn	Cover	Temp
1	36	350	19	160°
2	42	500	18	150°
3	30	250	17	160°
4	48	400	18	75°
5	34	300	19	130°
6	32	300	18	140°
7	43	550	18	120°
8	30	250	19	100°
9	30	200	18	100°
10	41	550	19	90°
11	41	500	18	170°
12	40	450	17	130°
13	50	650	18	150°
14	30	200	17	80°
15	32	300	18	80°
559	5800			

Loaded By Wertz-Lorell-7-8-49
Wire Bound + Reinf Prima Cord
1 Elec Blasting Cap

Blast No 5

Hole	Depth	Dyn	Cover	Temp
1	38	400	18	50°
2	38	400	18	50°
3	40	400	20	240°
4	35	300	18	210°
5	21	150	14	220°
6	40	400	20	200°
212	2050			

Blast Fired 7-1-49 12:20 P.M.
Loaded By Morgan
Wire Bound + Reinf Prima Cord

Blast No 2

Hole	Depth	Dyn	Cover	Temp
1	52	650	20	100°
2	60	1000	20	48°
3	56	900	20	50°
4	76	1250	21	48°
5	79	1250	23	80°
6	49	1250	21.5	48°
7	45	500	20	70°
8	40	450	20	50°
9	41	450	18	50°
10	41	450	19	50°
11	42	500	20	60°
12	46	500	19	175°
13	42	450	20	100°
687	9600			

Blast Fired 6-28-49 - 2:39 PM
Loaded By Wertz Fiedorek + Morgan
Wire Bound + Reinf Prima Cord

Blast #9

Hole	Depth	Dyn	Cover	Temp
1	45	500	18	80°
2	40	400	20	80°
3	27	200	18	70°
4	18	100	15	80°
5	43	650	20	55°
6	33	400	20	60°
7	30	300	19	65°
8	21	150	15	60°
9	41	600	19	50°
10	27	250	18	55°
11	21	150	15	60°
344	3700			

Blast Fired 7-19-49 2:30 P.M.
Loaded By Wertz-Lorell-Morgan
Wire Bound + Reinf Prima Cord

Geological Log

Depth	Material	Notes
1-20'	Gr. Rock	
11-11.5'	Shale	
12'	Shale	
13'	Shale	
