


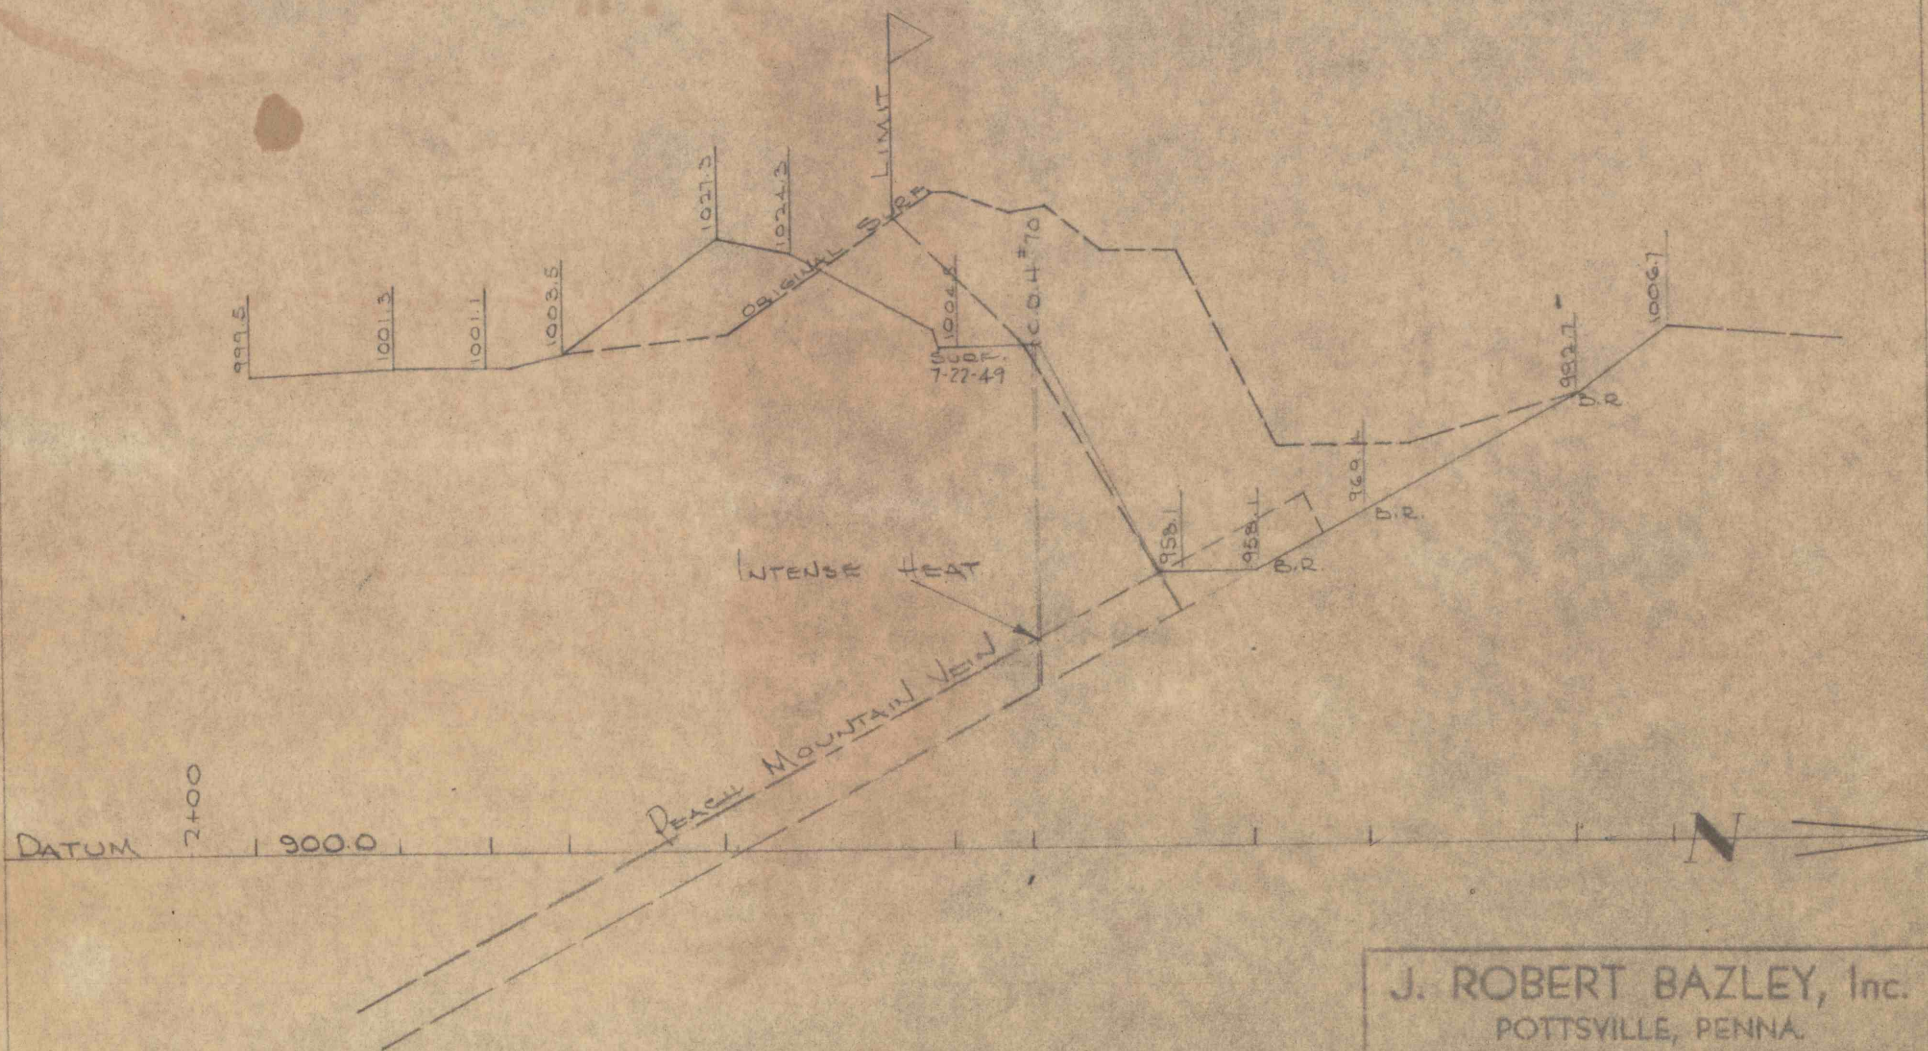

J. ROBERT BAZLEY, Inc.			
POTTSVILLE, PENNA.			
PEACH MOUNTAIN FIRE			
SECTION 10+08 ²			
DATE	SCALE	BY	
7-25-49	1"=40'		
			D-35