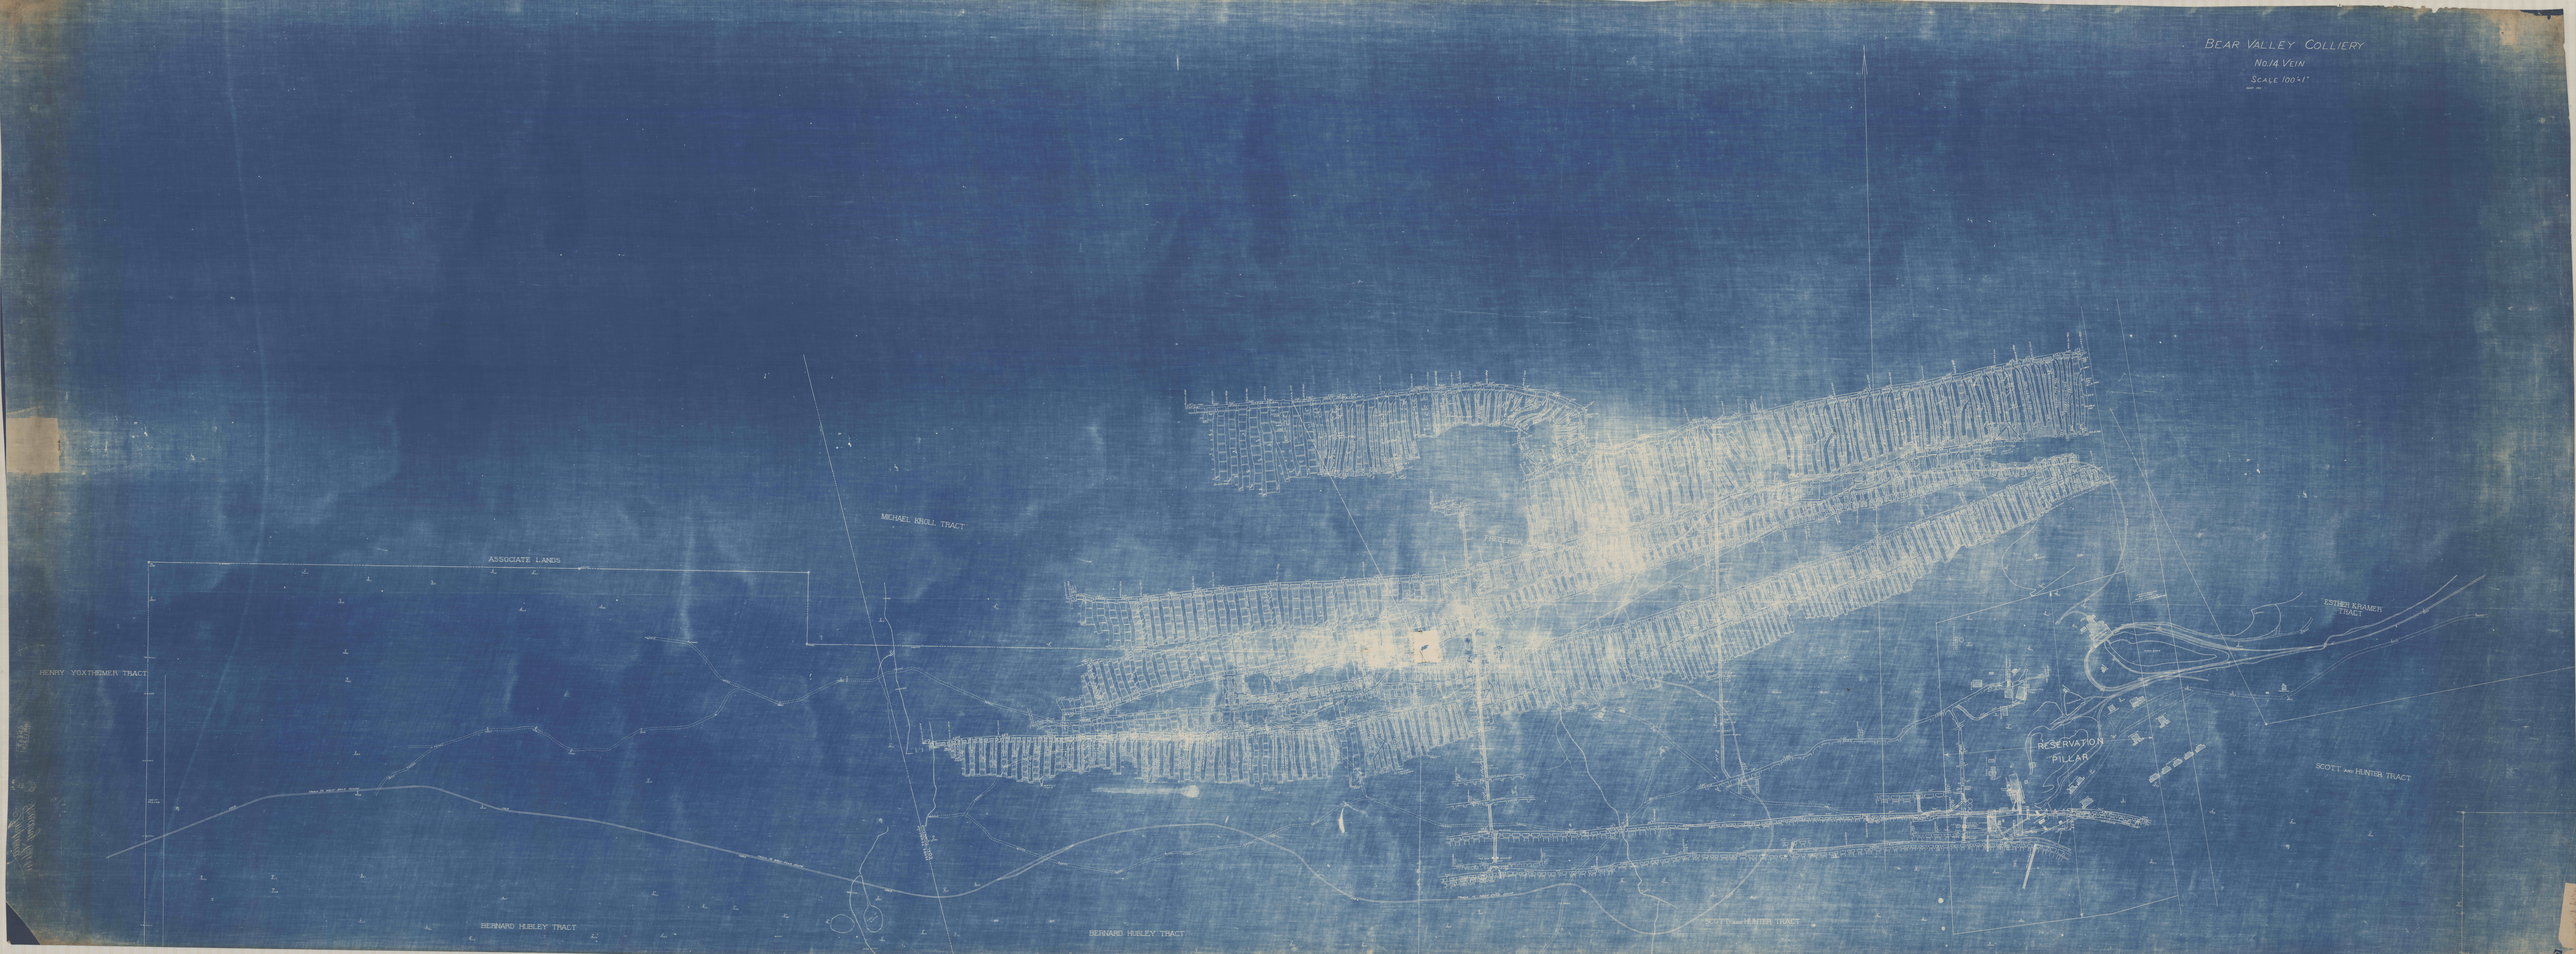
BEAR VALLEY COLLIERY
No.14 VEIN
SCALE 100=1'
ASSOCIATE LANDS
HENRY YOXTHEIMER TRACT
MICHAEL KROLL TRACT
BERNARD HUBLEY TRACT
BERNARD HUBLEY TRACT
SCOTT and HUNTER TRACT
RESERVATION PILLAR
ESTHER KRAMER TRACT
SCOTT and HUNTER TRACT