


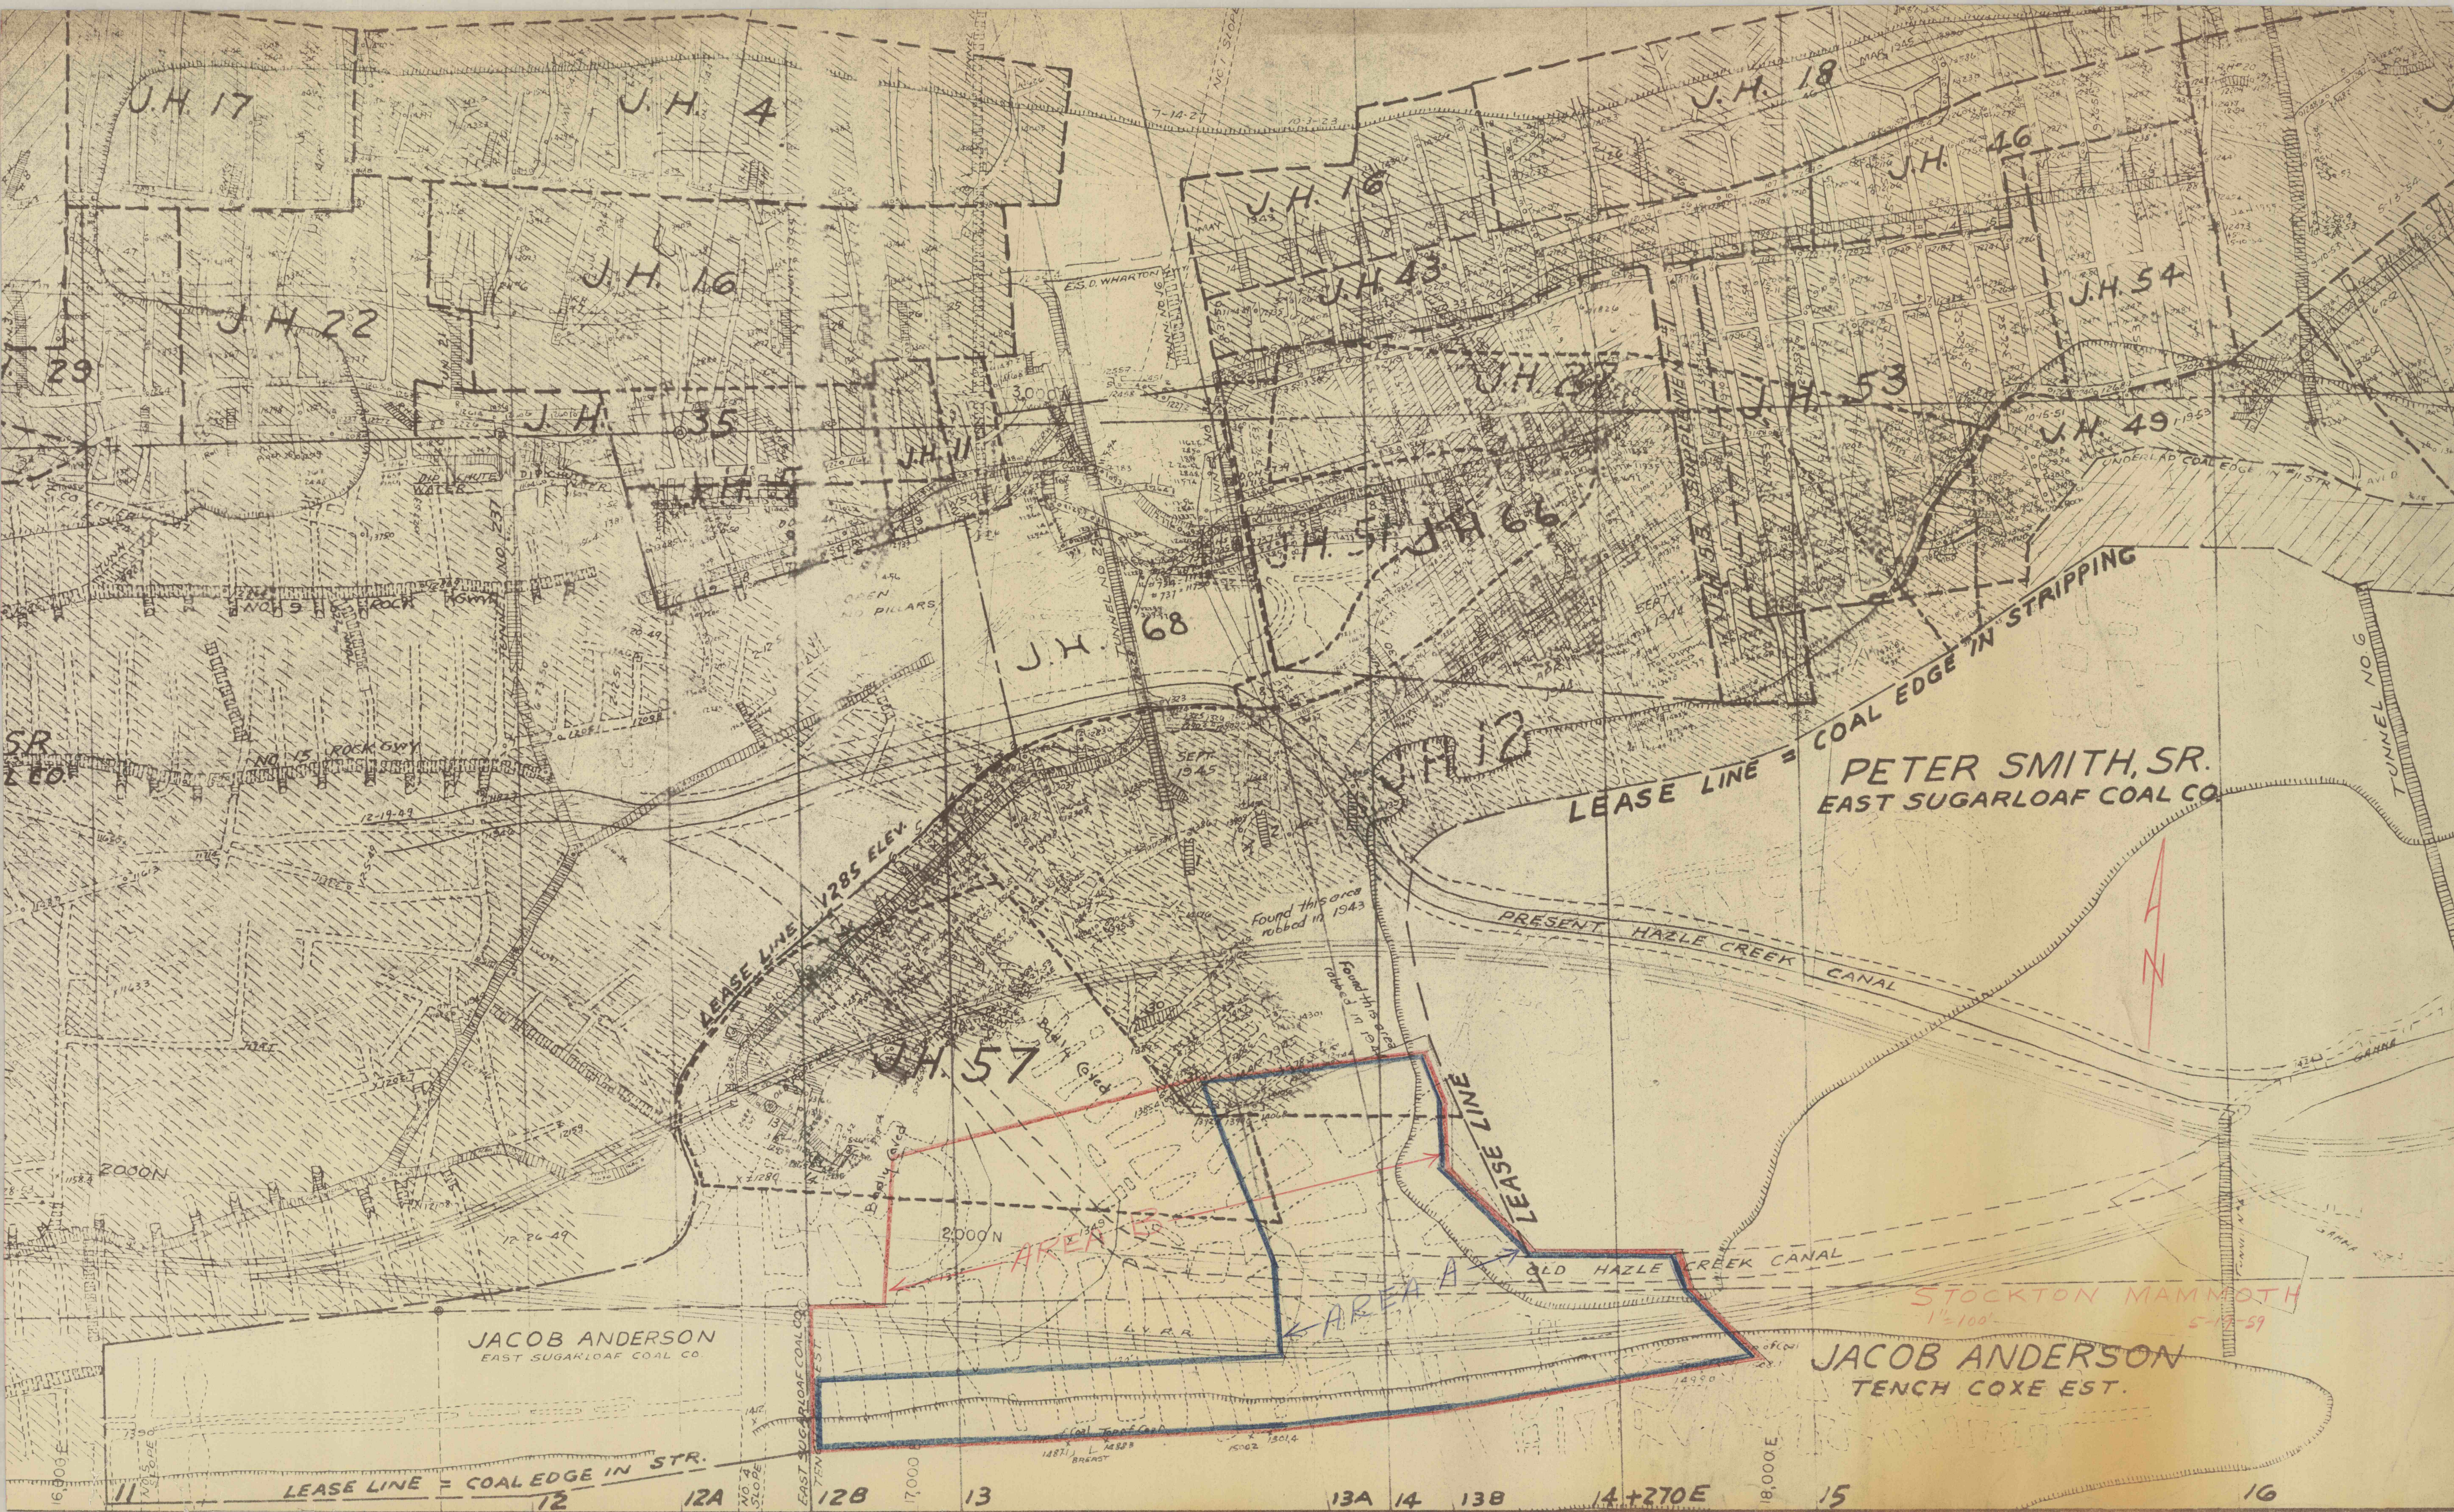

J.H. 17

J.H. 4

J.H. 18

J.H. 16

J.H. 16

J.H. 43

J.H. 46

J.H. 22

J.H. 54

J.H. 35

J.H. 11

J.H. 27

J.H. 53

J.H. 49

J.H. 57

J.H. 66

J.H. 68

J.H. 12

LEASE LINE = COAL EDGE IN STRIPPING

PETER SMITH, SR.
EAST SUGARLOAF COAL CO.

J.H. 57

LEASE LINE

JACOB ANDERSON
EAST SUGARLOAF COAL CO.

STOCKTON MAMMOTH
1"=100'
5-17-59
JACOB ANDERSON
TENCH COXE EST.

LEASE LINE = COAL EDGE IN STR.

12

12A

12B

13

13A

14

13B

14+270E

15

16