


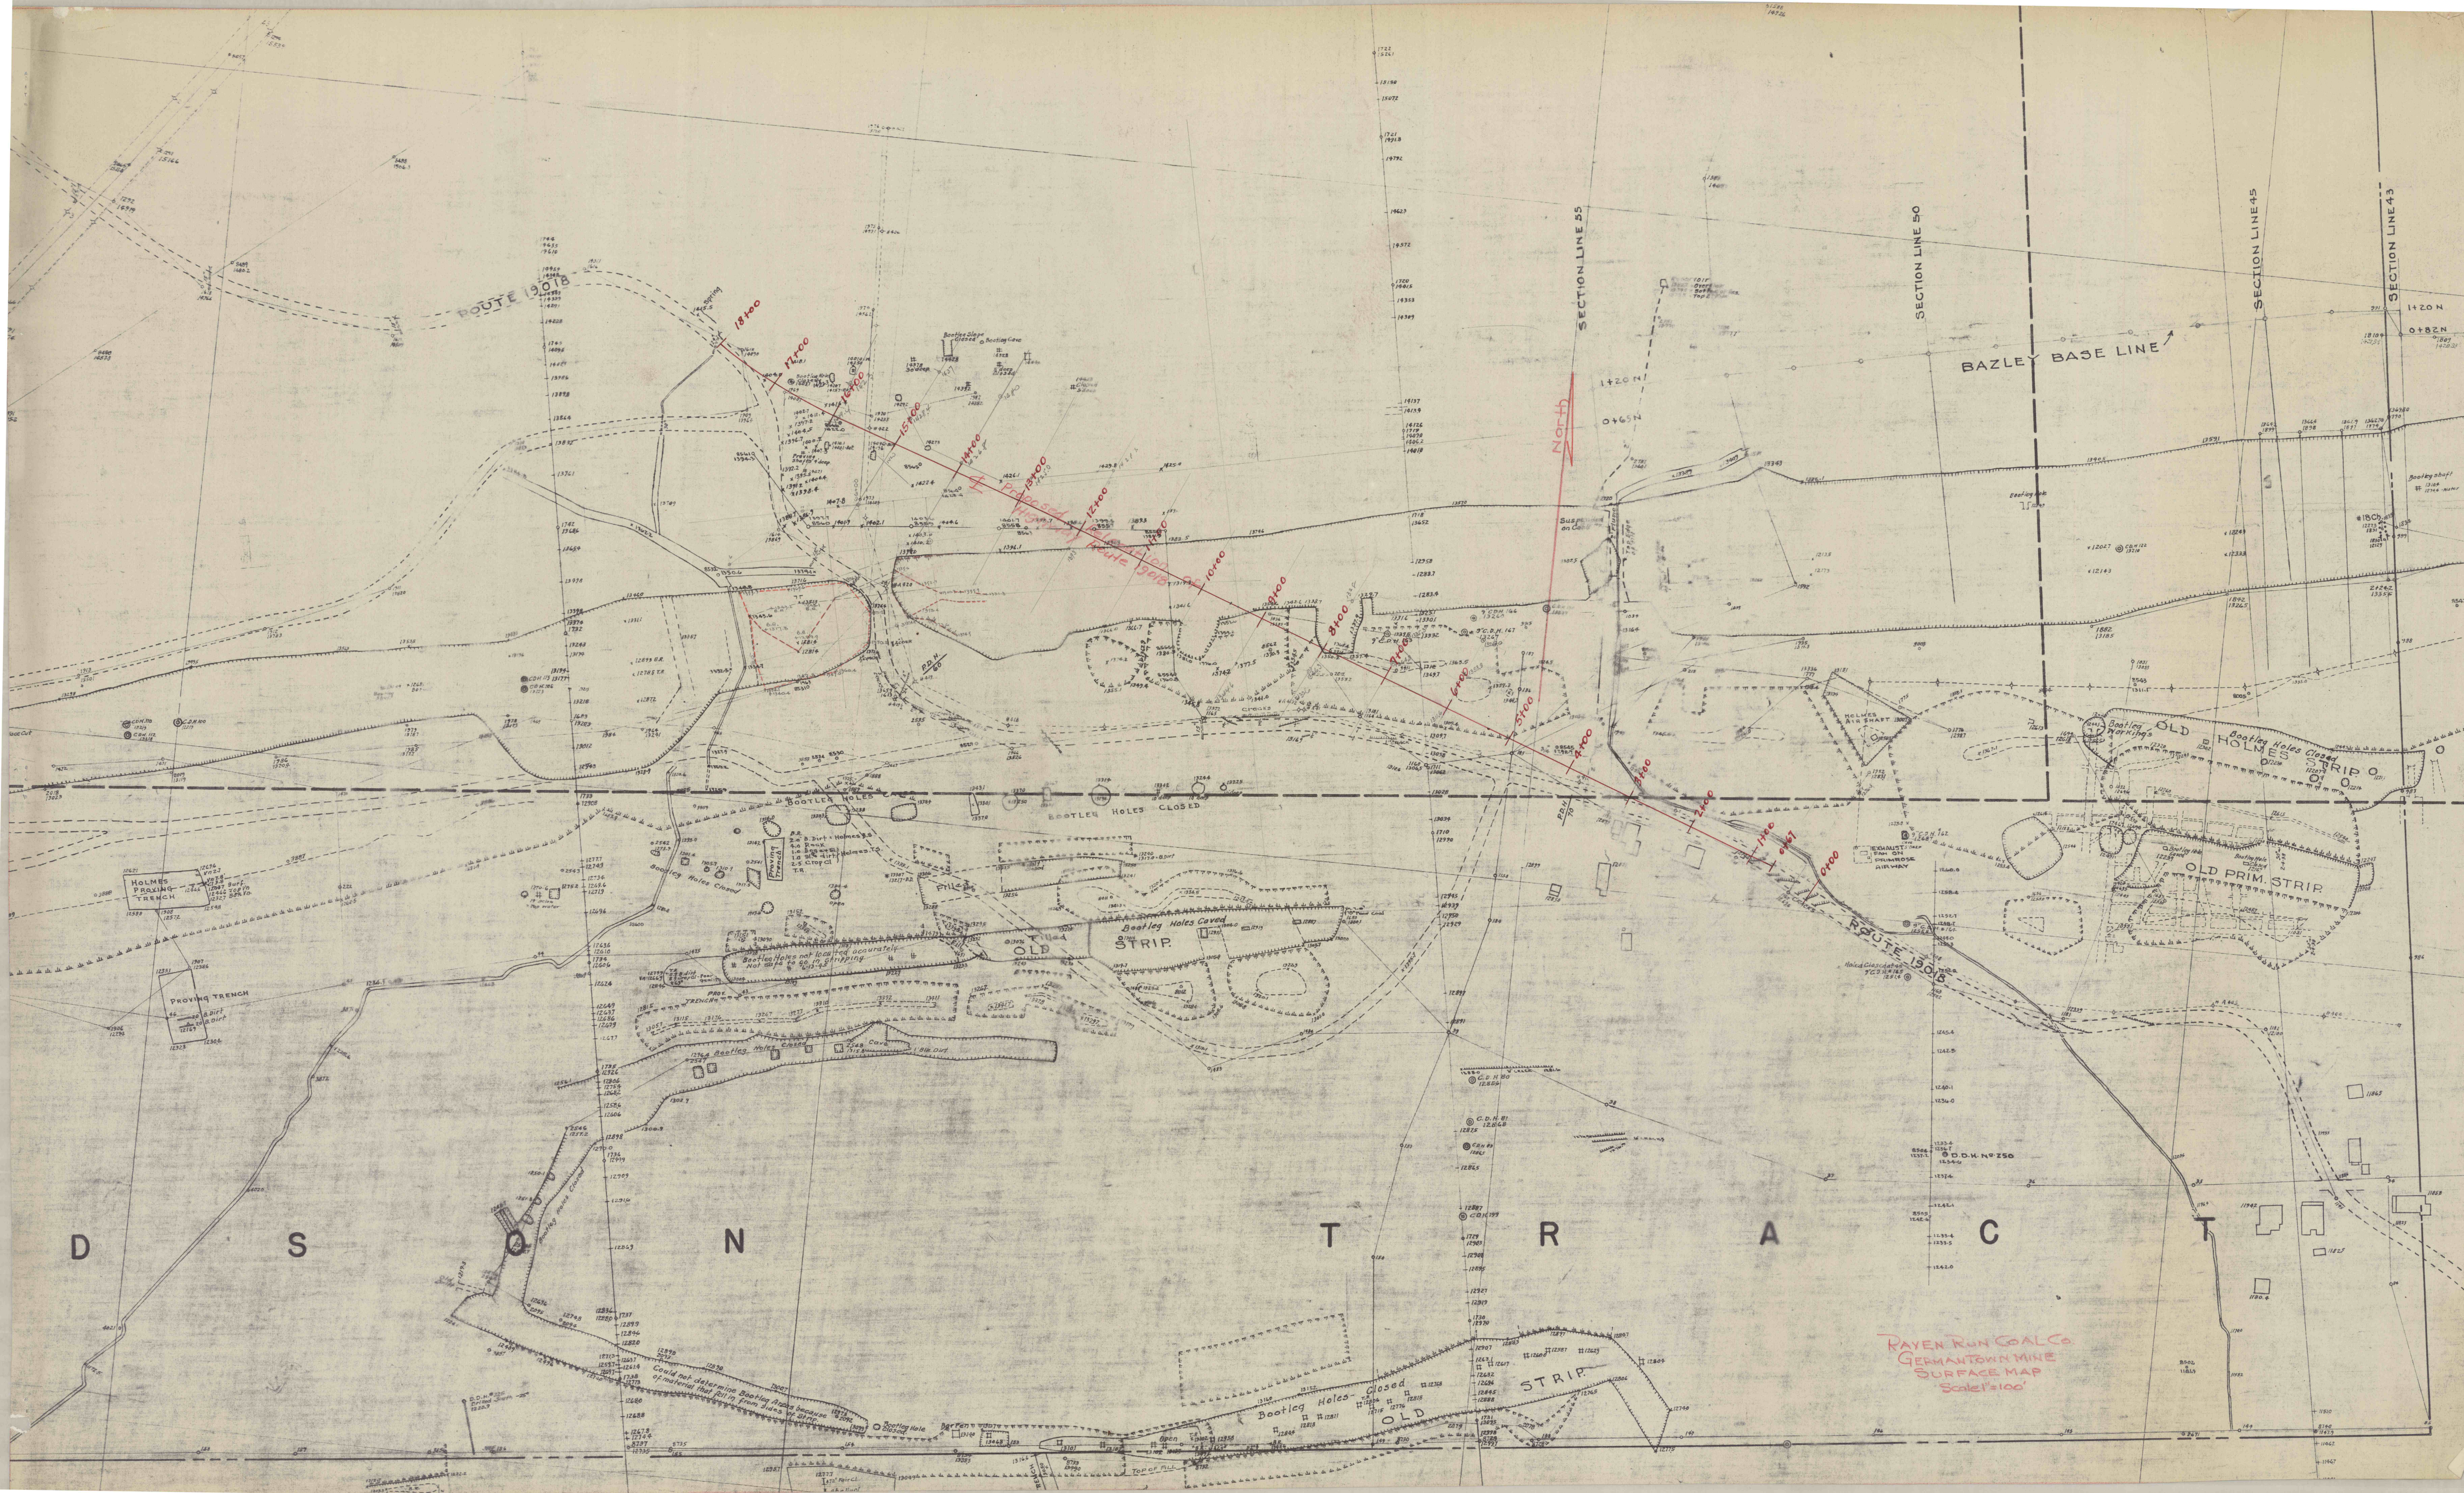

ROUTE 19018

BAZLEY BASE LINE

SECTION LINE 55

SECTION LINE 50

SECTION LINE 45

SECTION LINE 43

HOLMES
PROXING
TRENCH

PROVING
TRENCH

D

S

N

T

R

A

C

T

OLD
STRIP

OLD PRIM. STRIP

STRIP

RAVEN RUN COAL CO.
GERMAINTOWN MINE
SURFACE MAP
Scale 1"=100'