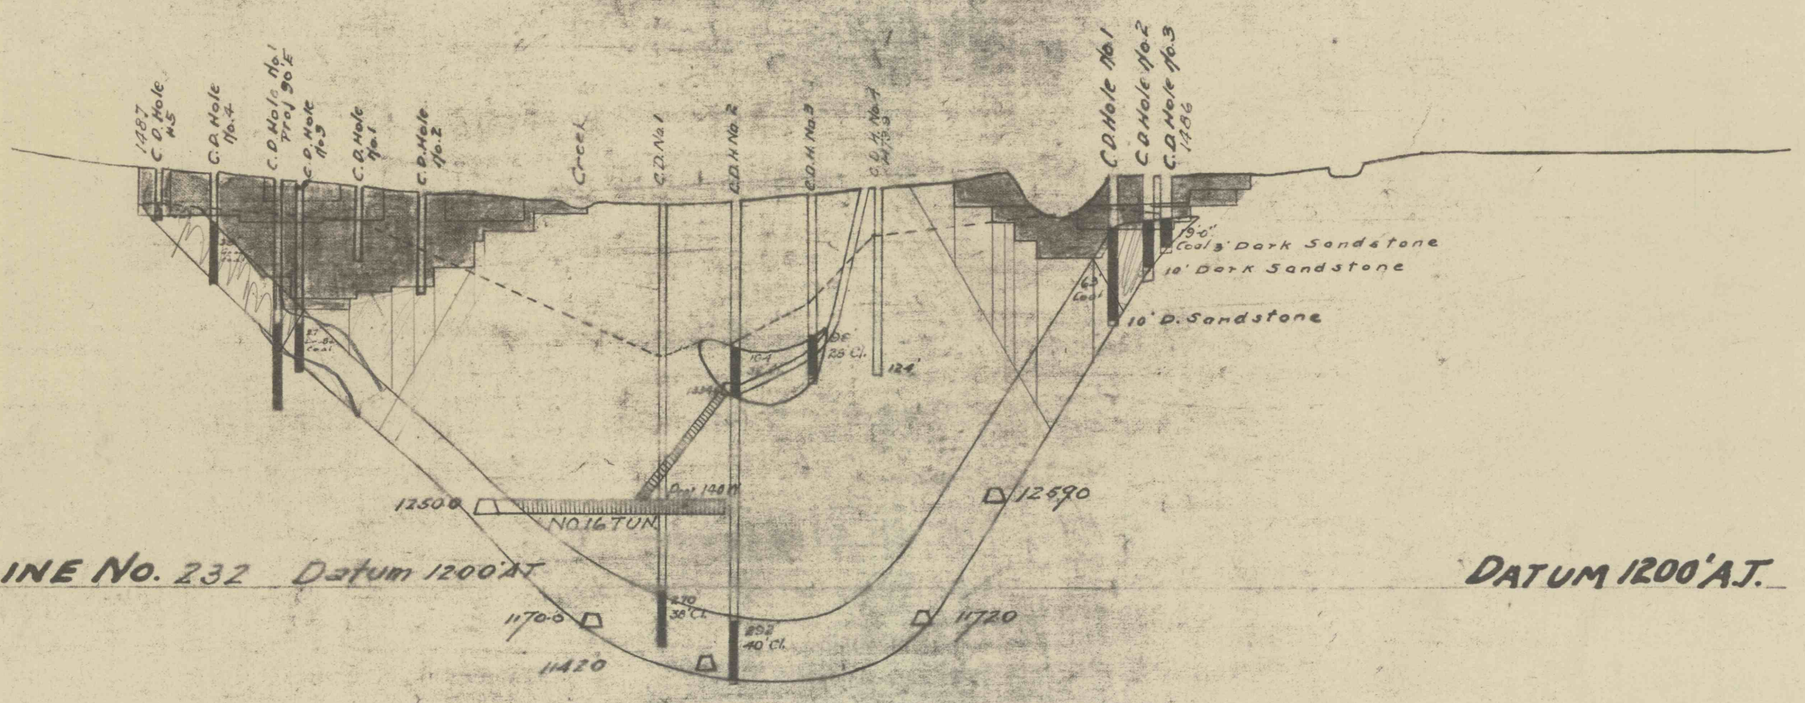

SECTION LINE No. 232 Datum 1200' A.T. DATUM 1200' A.T.

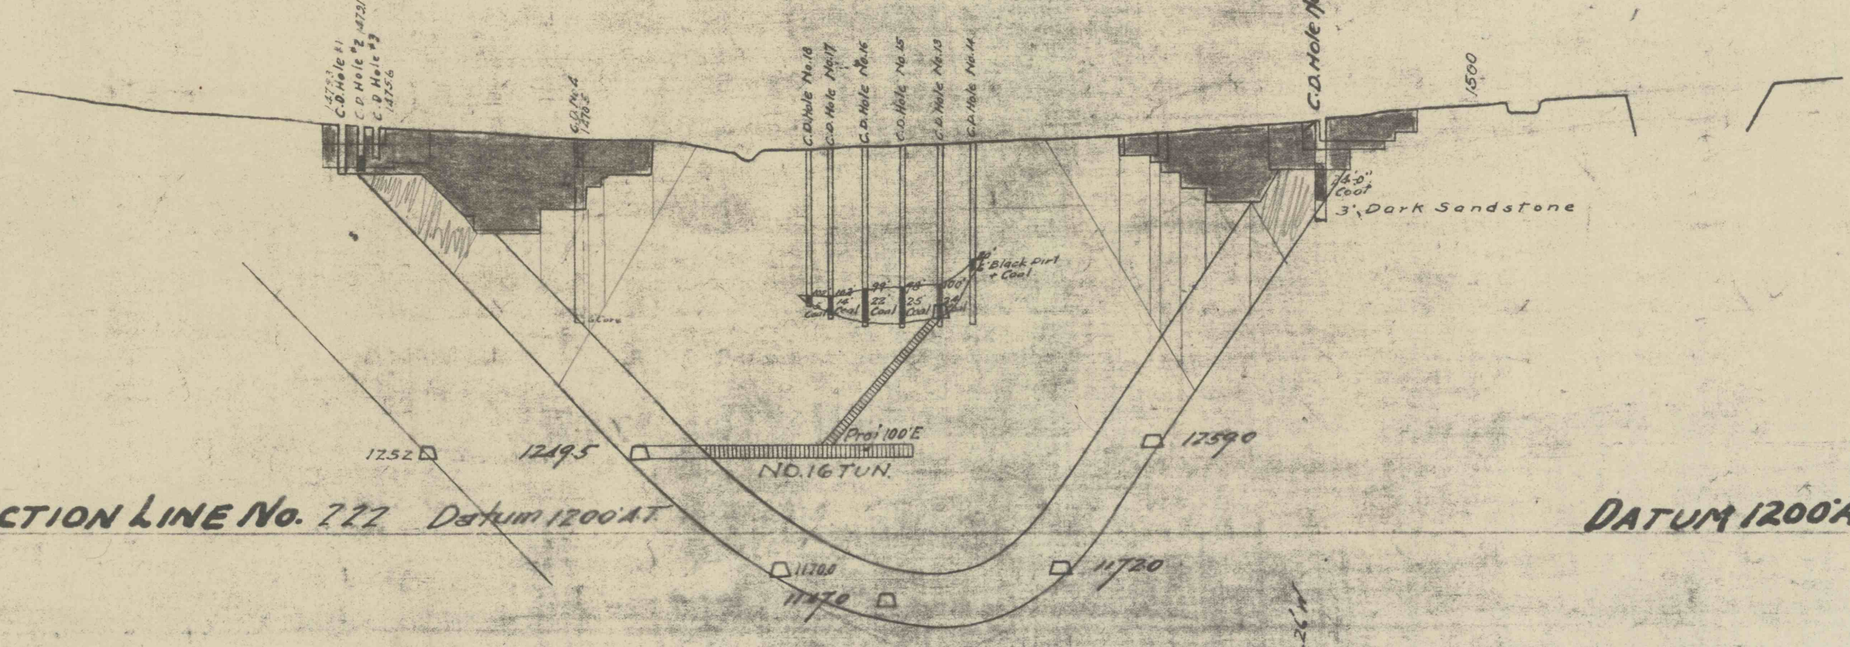

SECTION LINE No. 222 Datum 1200' A.T. DATUM 1200' A.T.

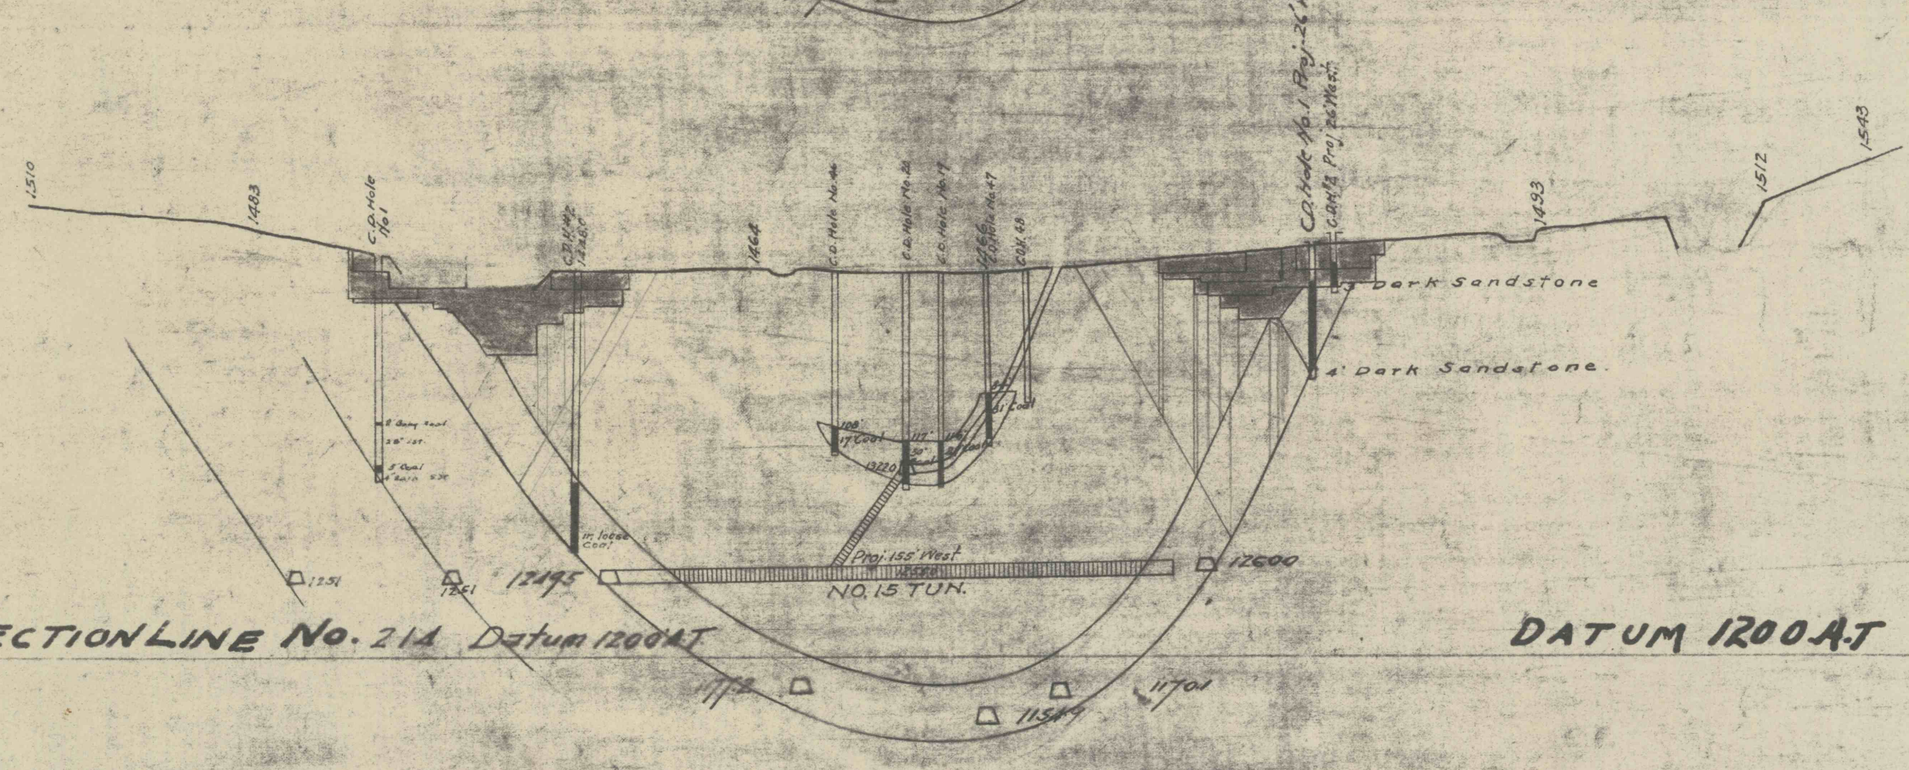

SECTION LINE No. 214 Datum 1200' A.T. DATUM 1200' A.T

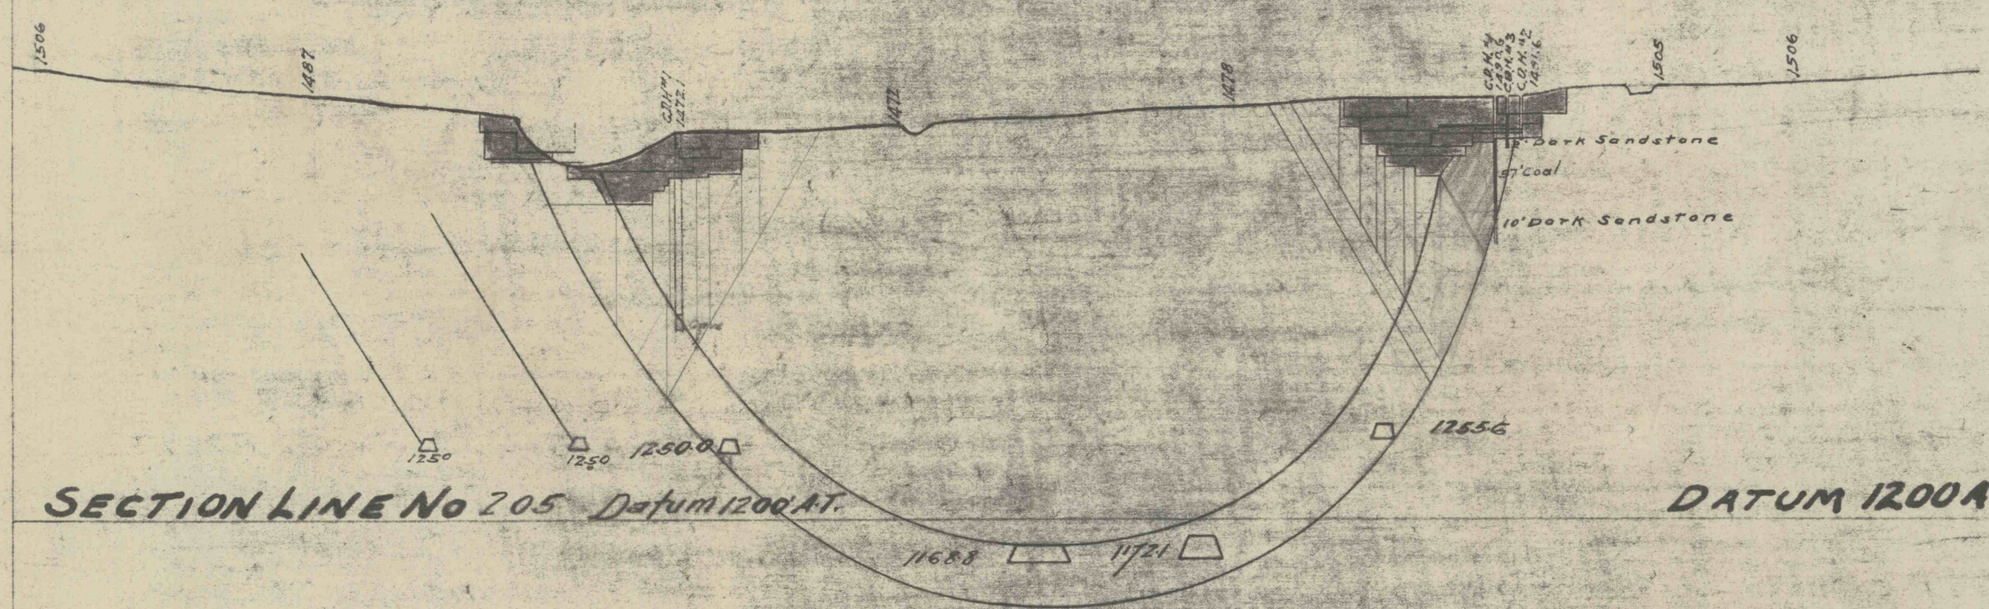

SECTION LINE No 205 Datum 1200' A.T. DATUM 1200 A.T.

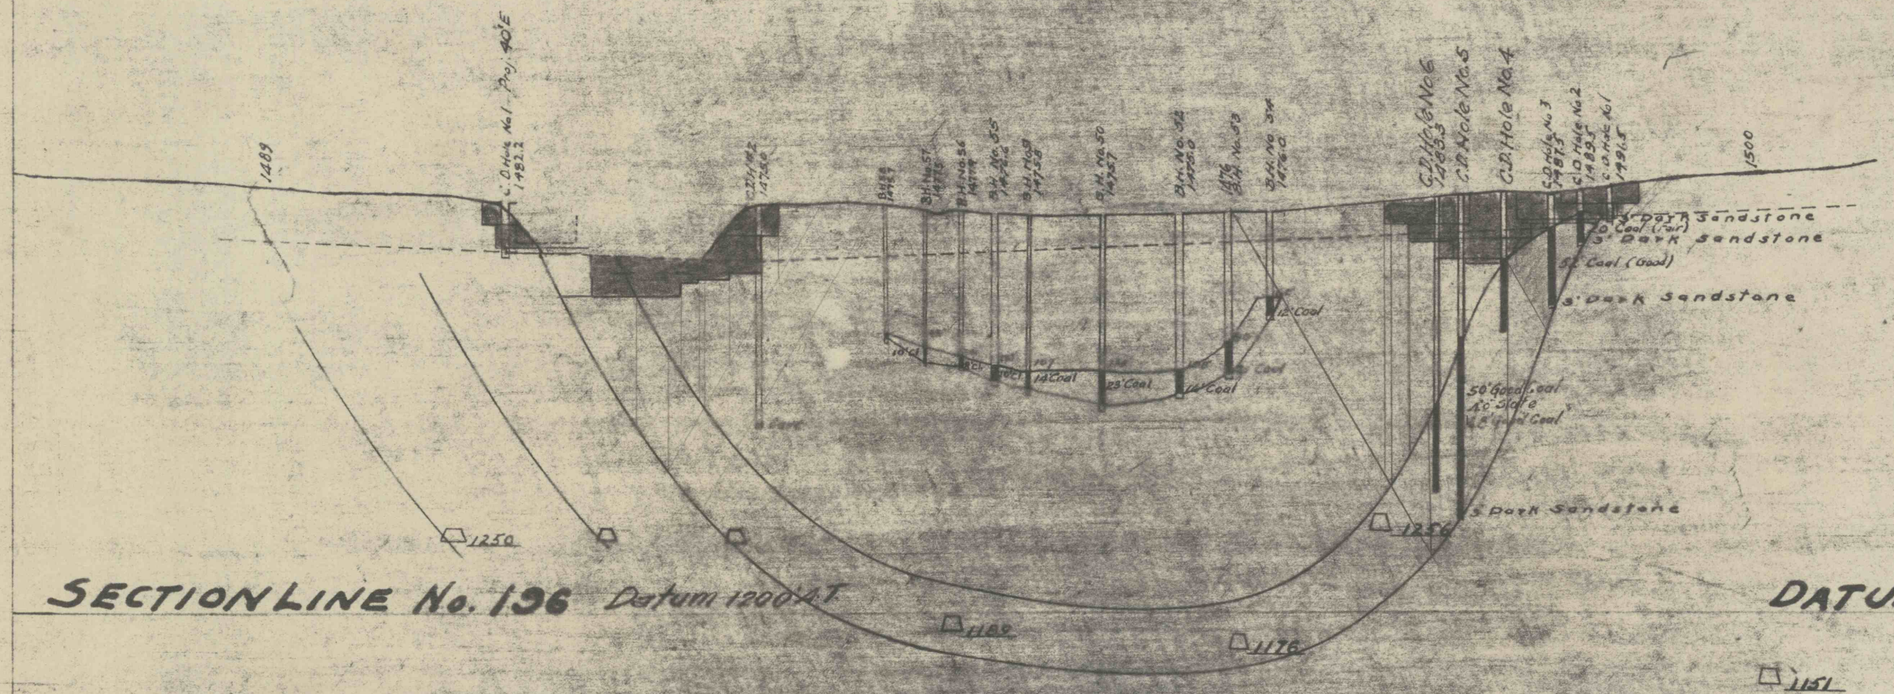

SECTION LINE No. 196 Datum 1200' A.T. DATUM 1200 A.T.

958

HAZLE BROOK COAL CO.
RAVEN RUN COLLIERY
MAMMOTH VEIN PROVING
SECTION LINES Nos. 196 to 232 INCLUSIVE
Scale 1"=100' Engr. Dept.