


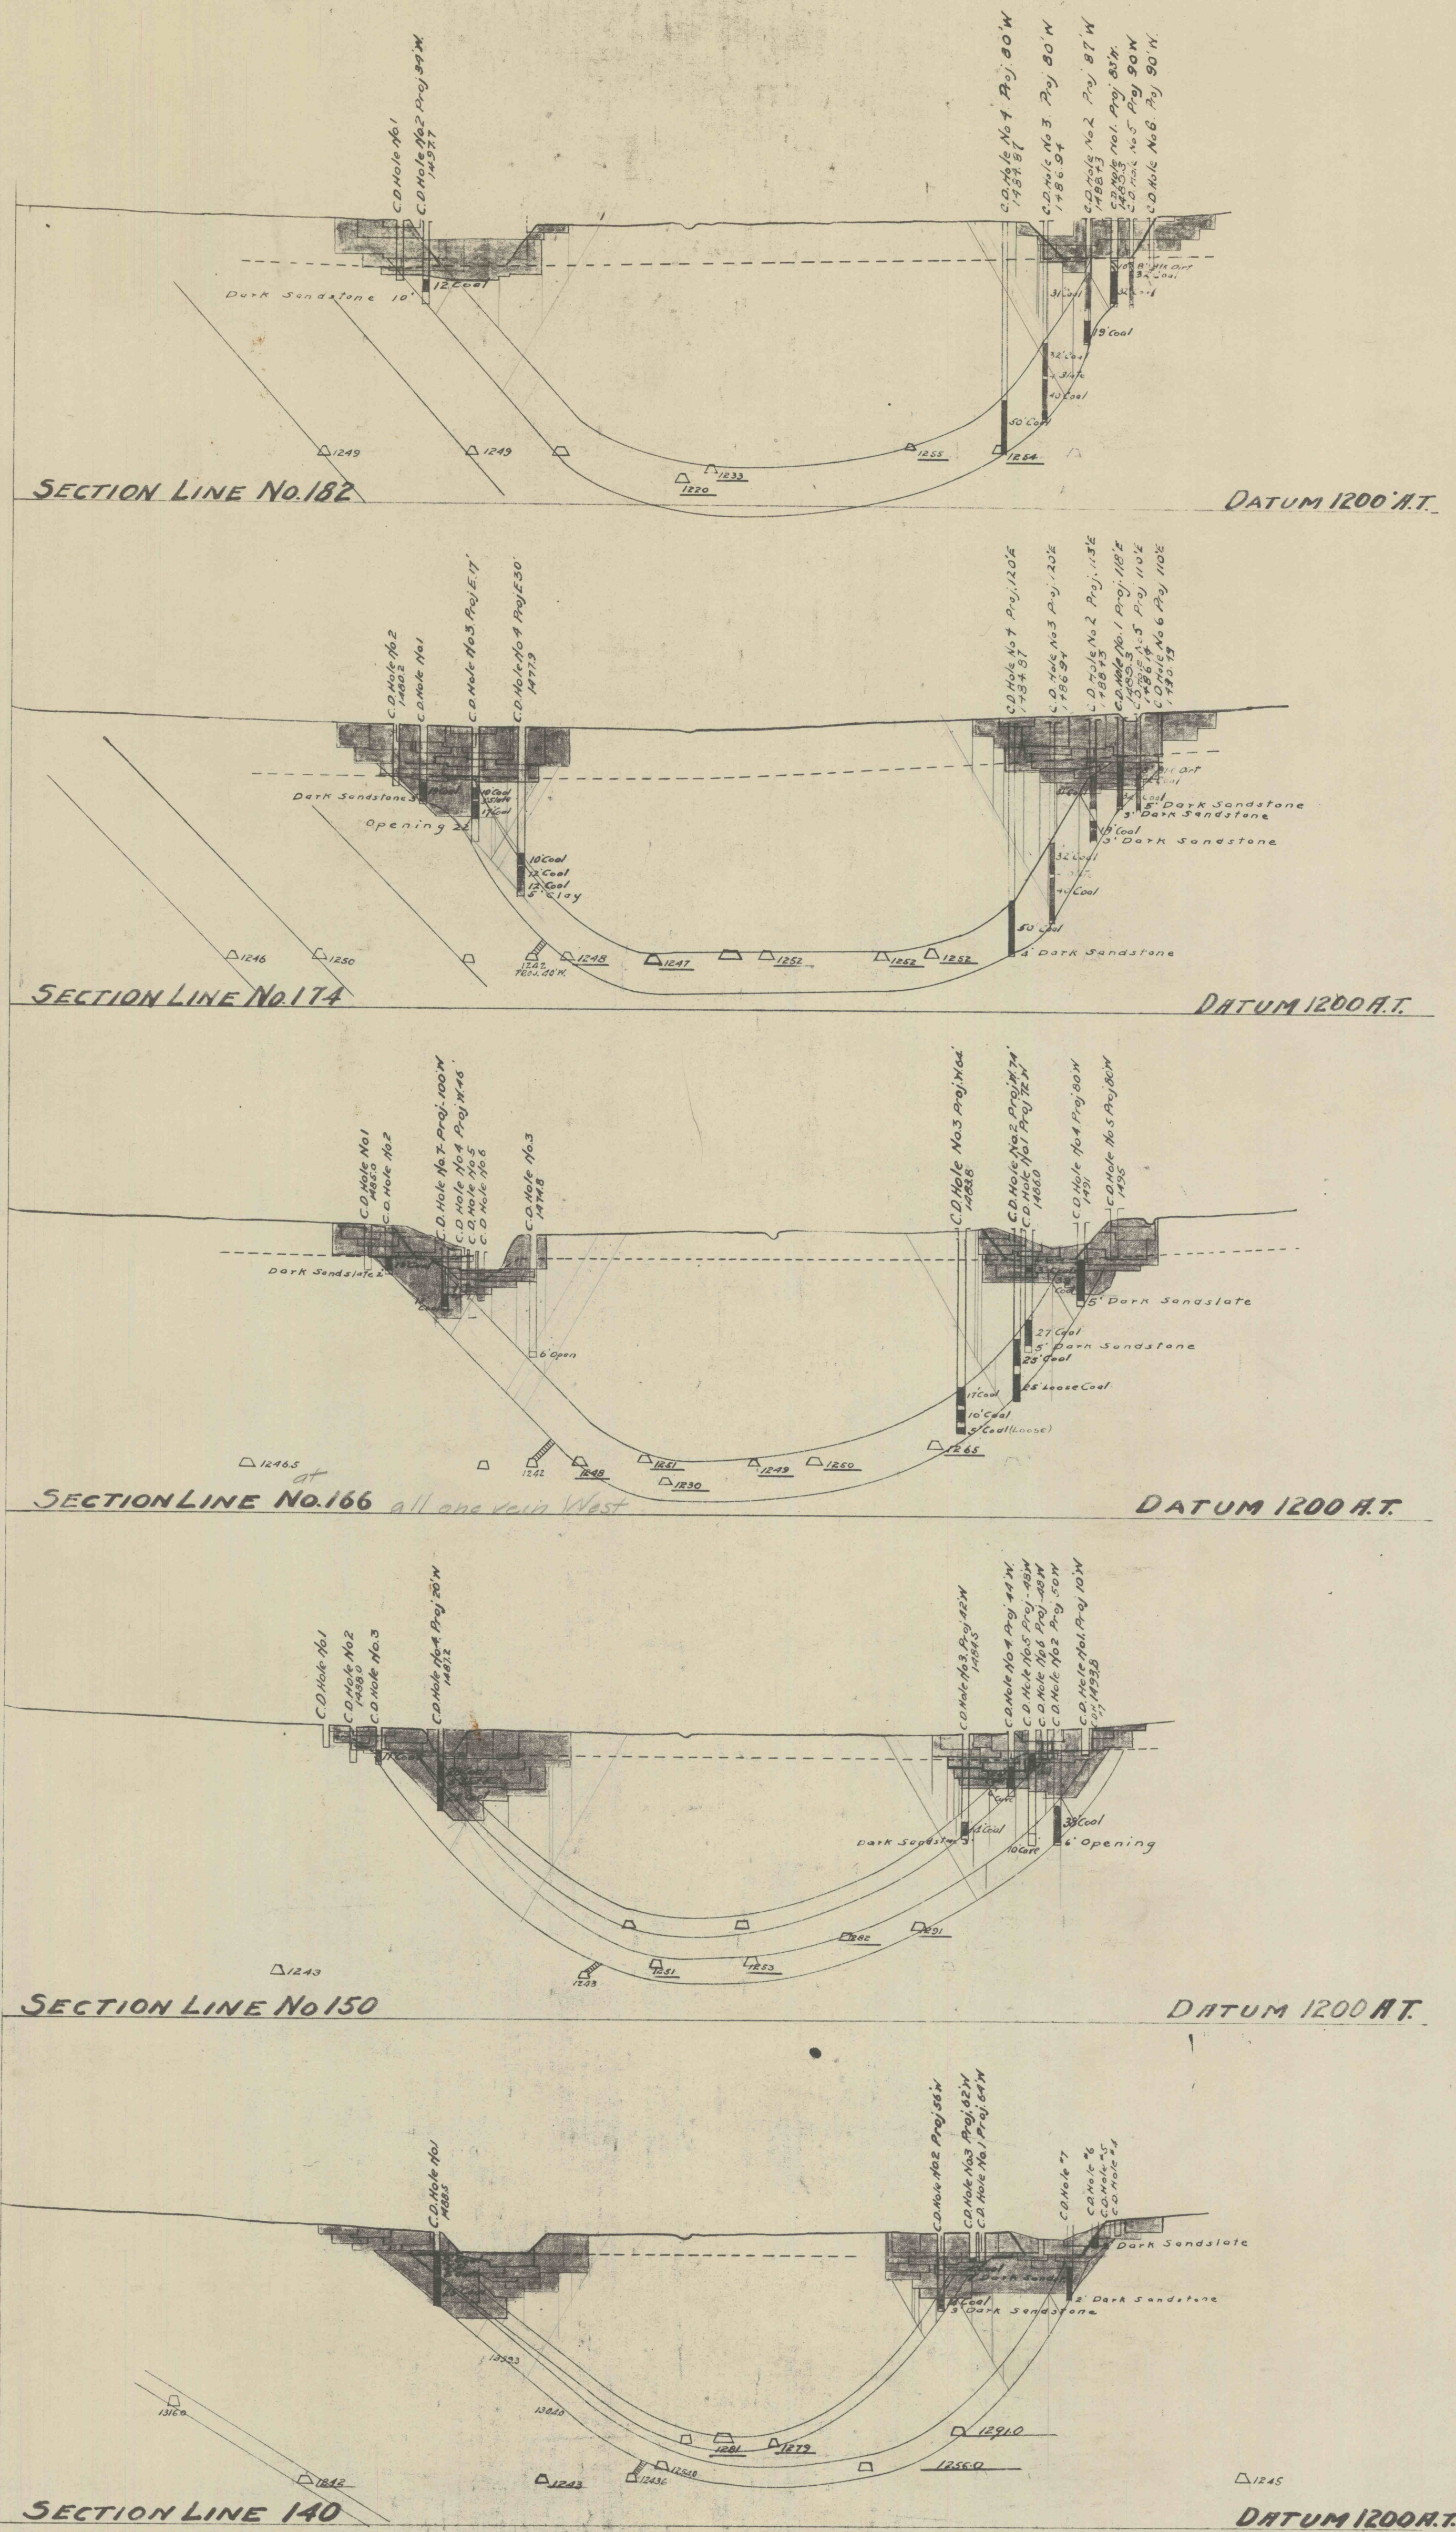

HAZLE BROOK COAL CO.
 RAVEN RUN COLLIERY
 MAMMOTH VEIN PROVING
 SECTION LINES Nos. 140 to 182 INCLUSIVE
 SCALE 1"=100' Engr. Dept. August, 7-1923
 Hazleton, Pa.