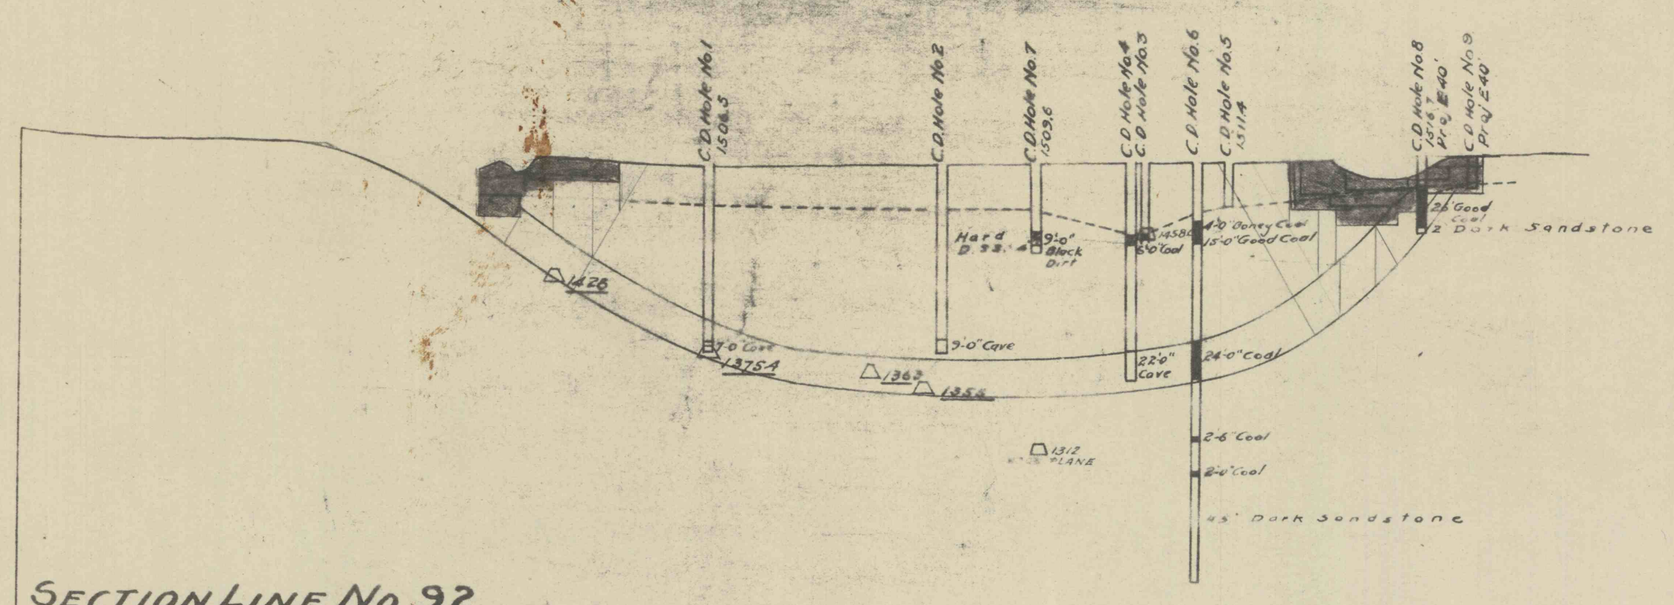

SECTION LINE No. 92 — DATUM 1200 A.T.

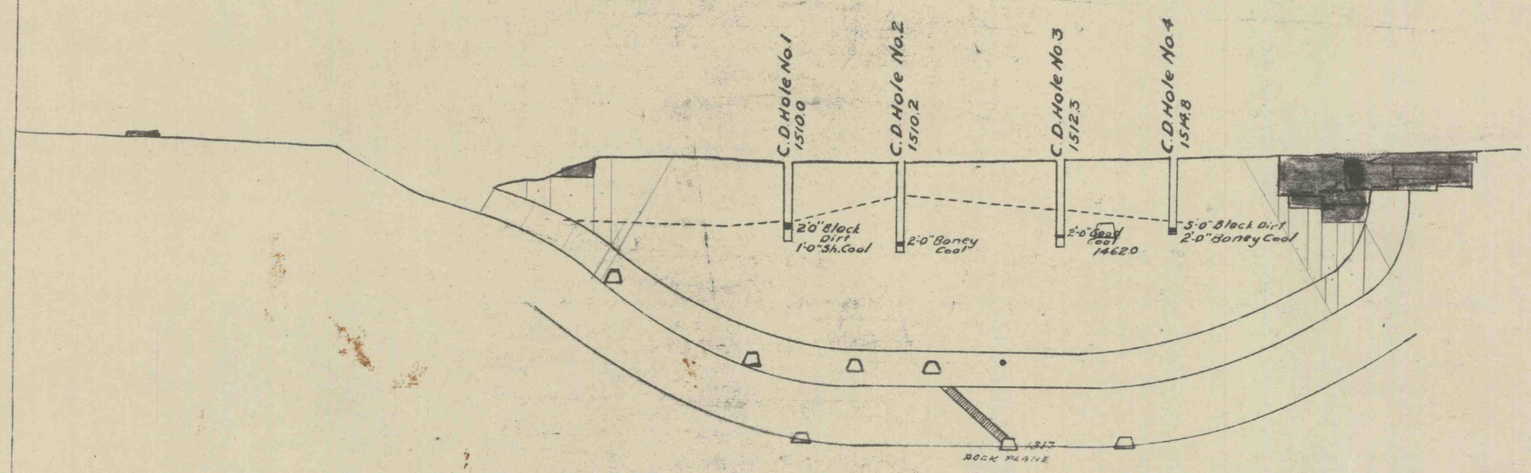

SECTION LINE No. 88 — DATUM 1200 A.T.

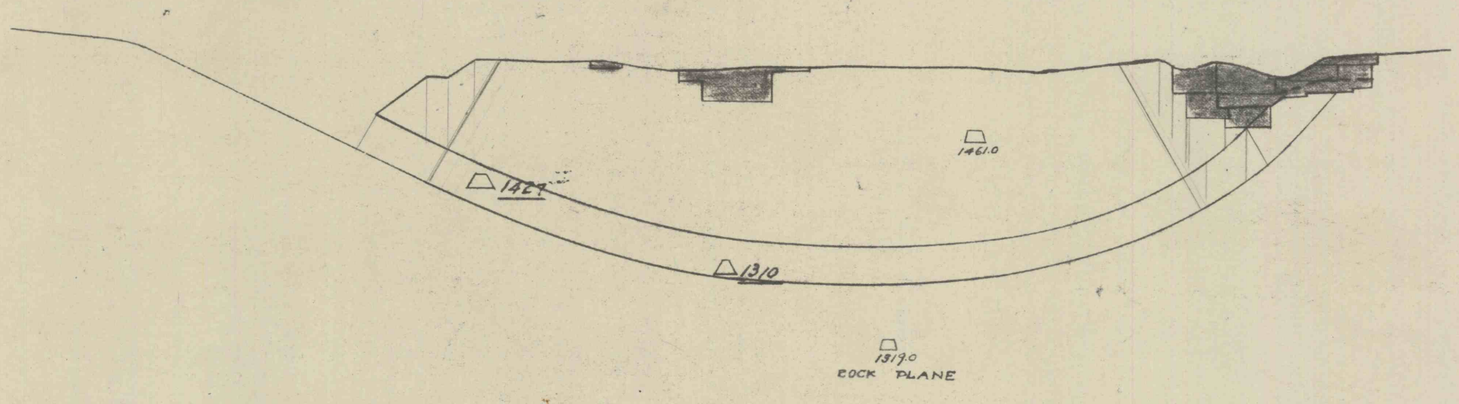

SECTION LINE No. 86 — DATUM 1200 A.T.

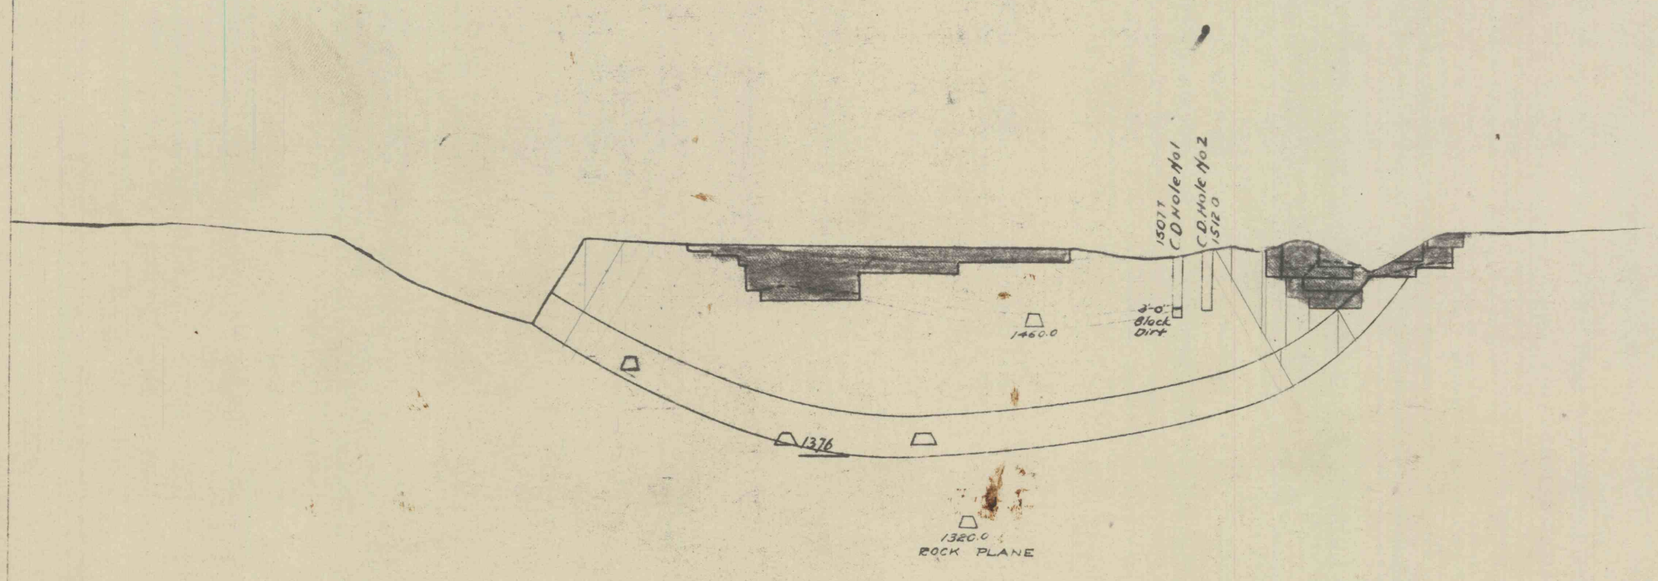

SECTION LINE No. 84 — DATUM 1200 A.T.

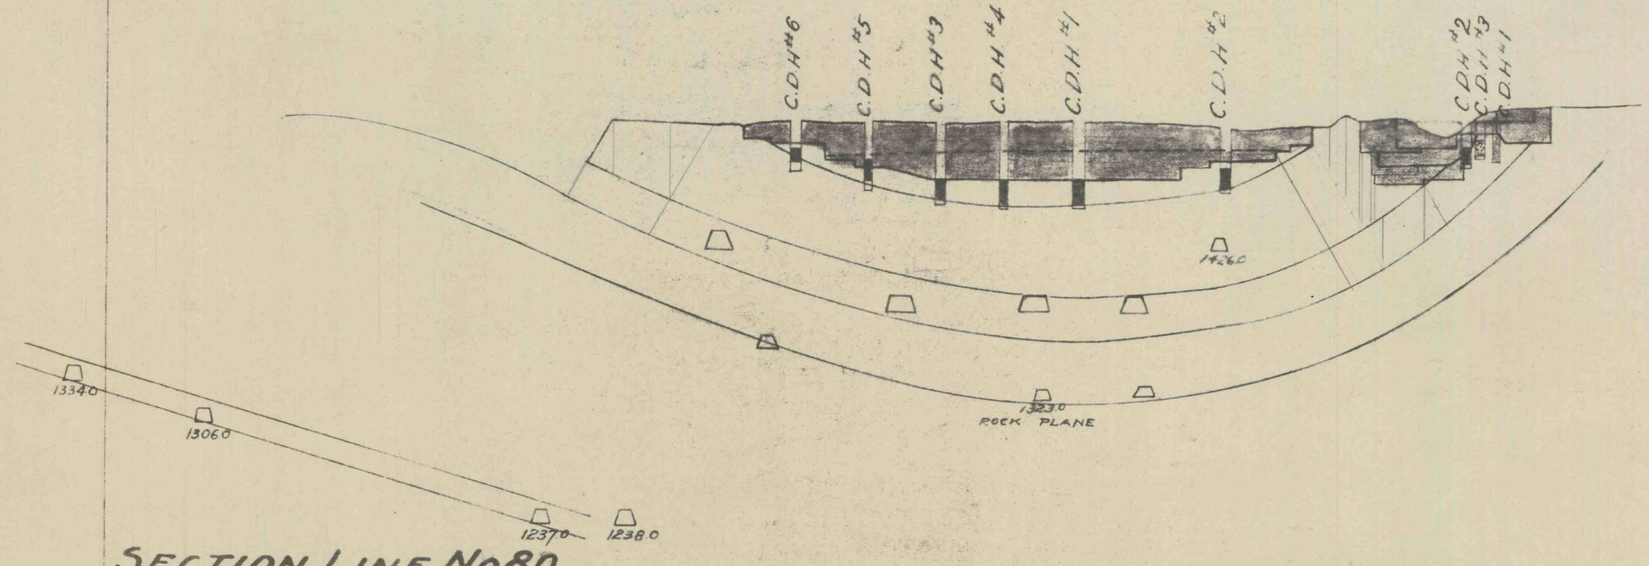

SECTION LINE No. 80 — DATUM 1200 A.T.

HAZLE BROOK COAL CO.
RAVEN RUN COLLIERY
MAMMOTH VEIN PROVING
SECTION LINES Nos. 80 [illegible]
SCALE 1/100 [illegible]