


(Bank Est
TAG. H. 114)

2100

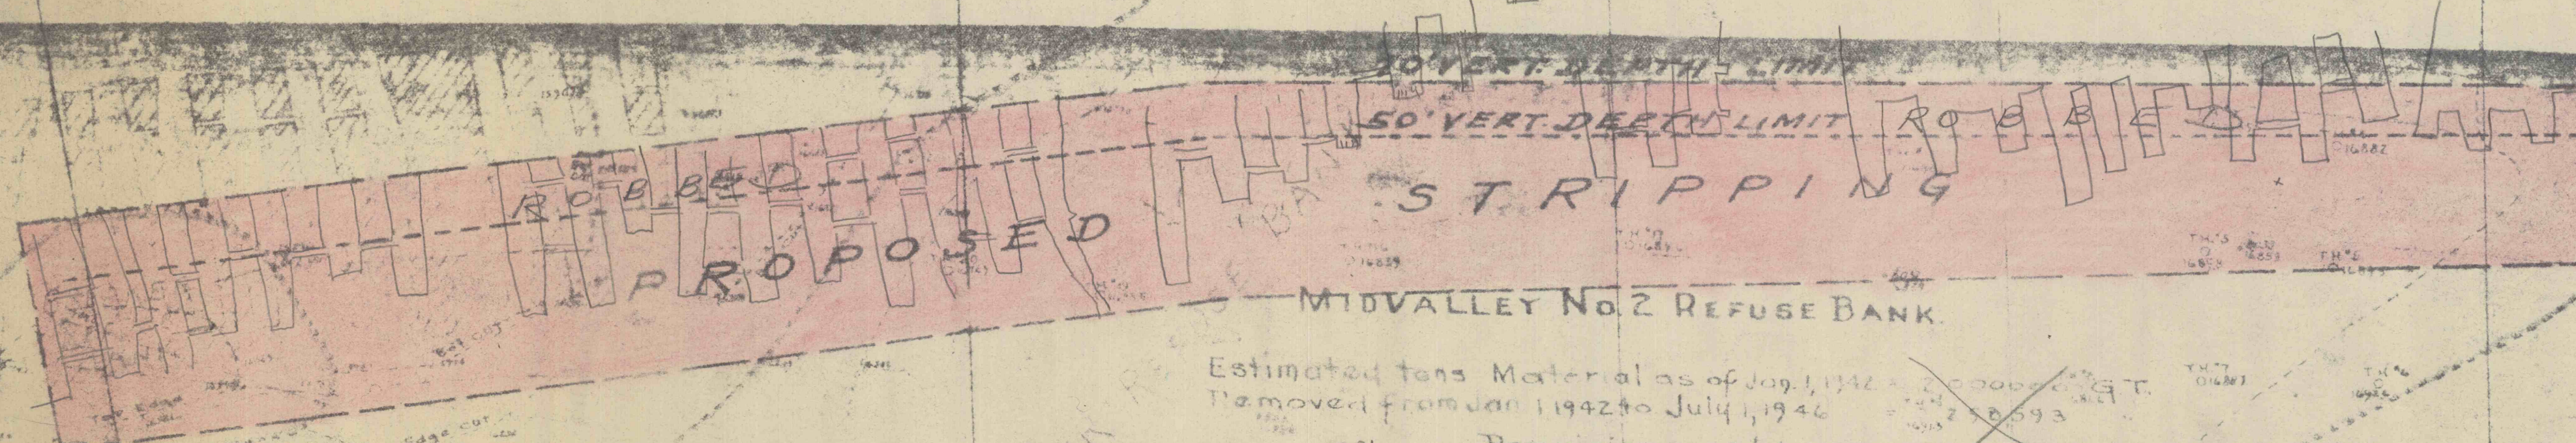

Estimated tons Material as of Jan. 1, 1942 = 2,000,000 G.T.
Removed from Jan. 1, 1942 to July 1, 1946 = 2,380,593
Remaining as of July 1, 1946 = 1,141,407
(Deposited during 1899-1924)

SEC. "C" (1)

SEC. O-P (2)

NO. 11

SEC. 3

SEC. 4

SEC. 5

SEC. 6

HAZLE BROOK COAL COMPANY
MIDVALLEY NO. 2 COLLY
Print showing Refuse Bank
Scale 1"=100'
July 10, 1946
Apr. 12, 1955