


SECTION 43

E 21,000

SECTION 44

E 22,000

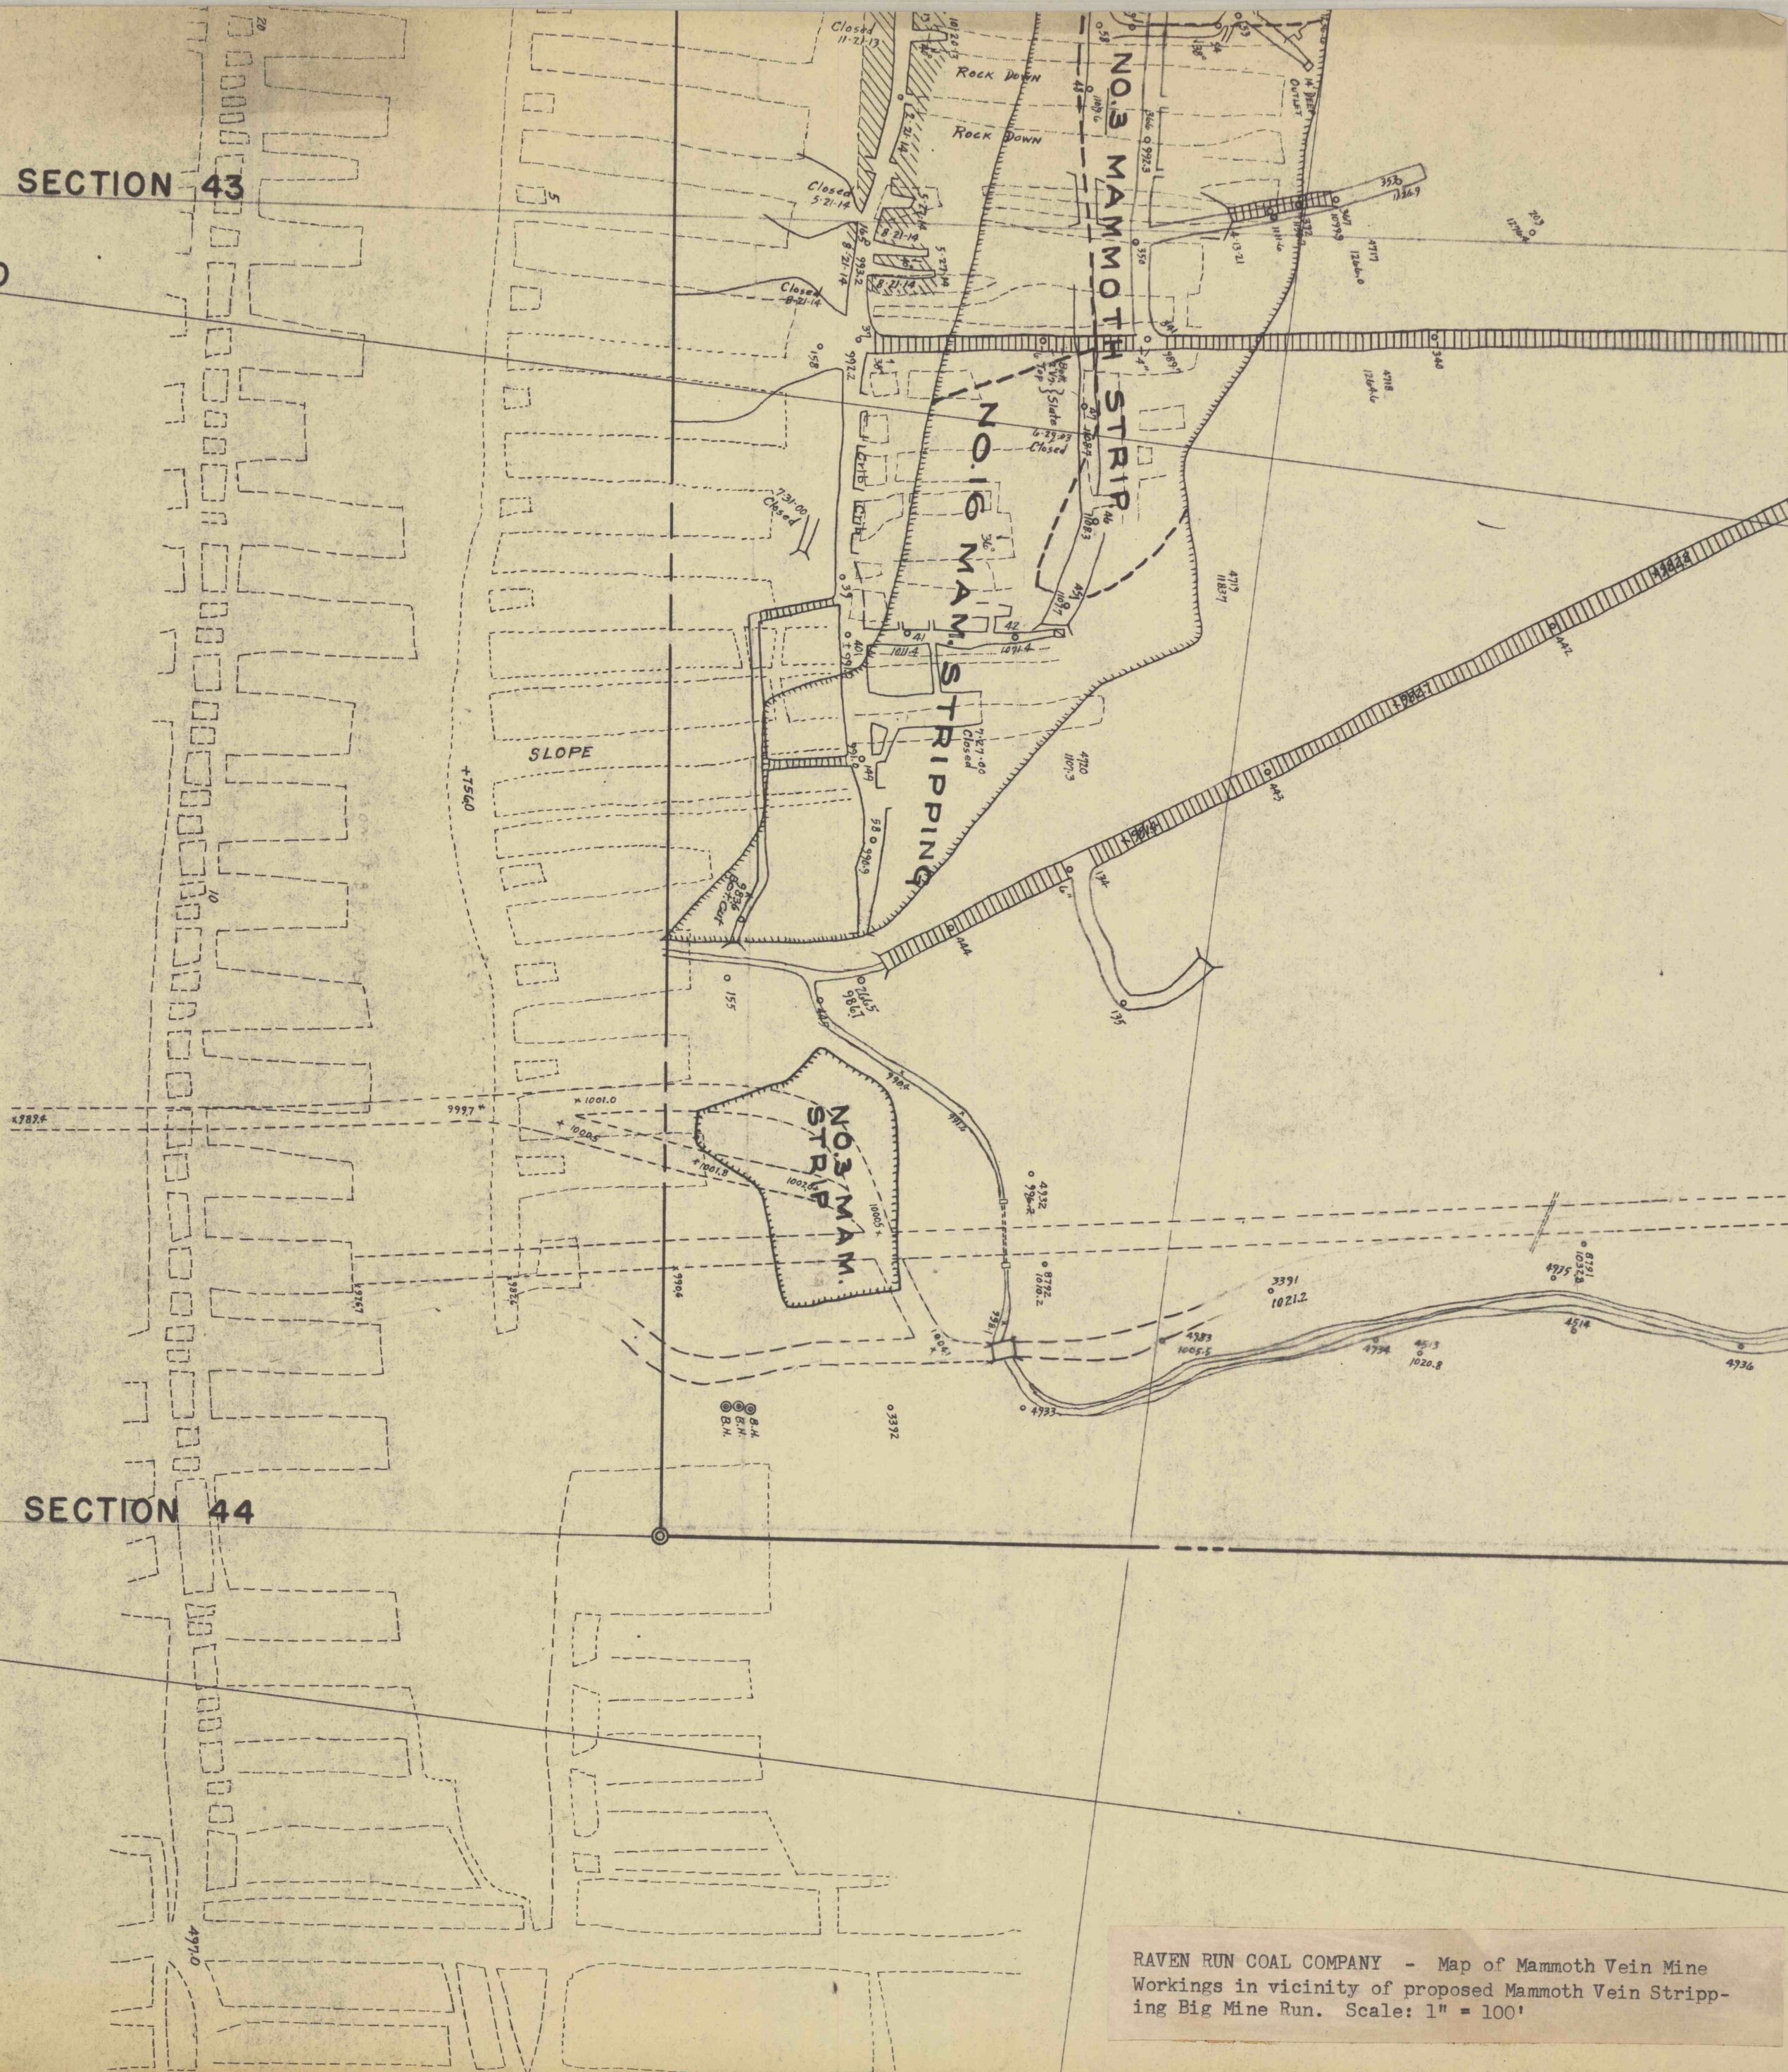

RAVEN RUN COAL COMPANY - Map of Mammoth Vein Mine Workings in vicinity of proposed Mammoth Vein Stripping Big Mine Run. Scale: 1" = 100'