


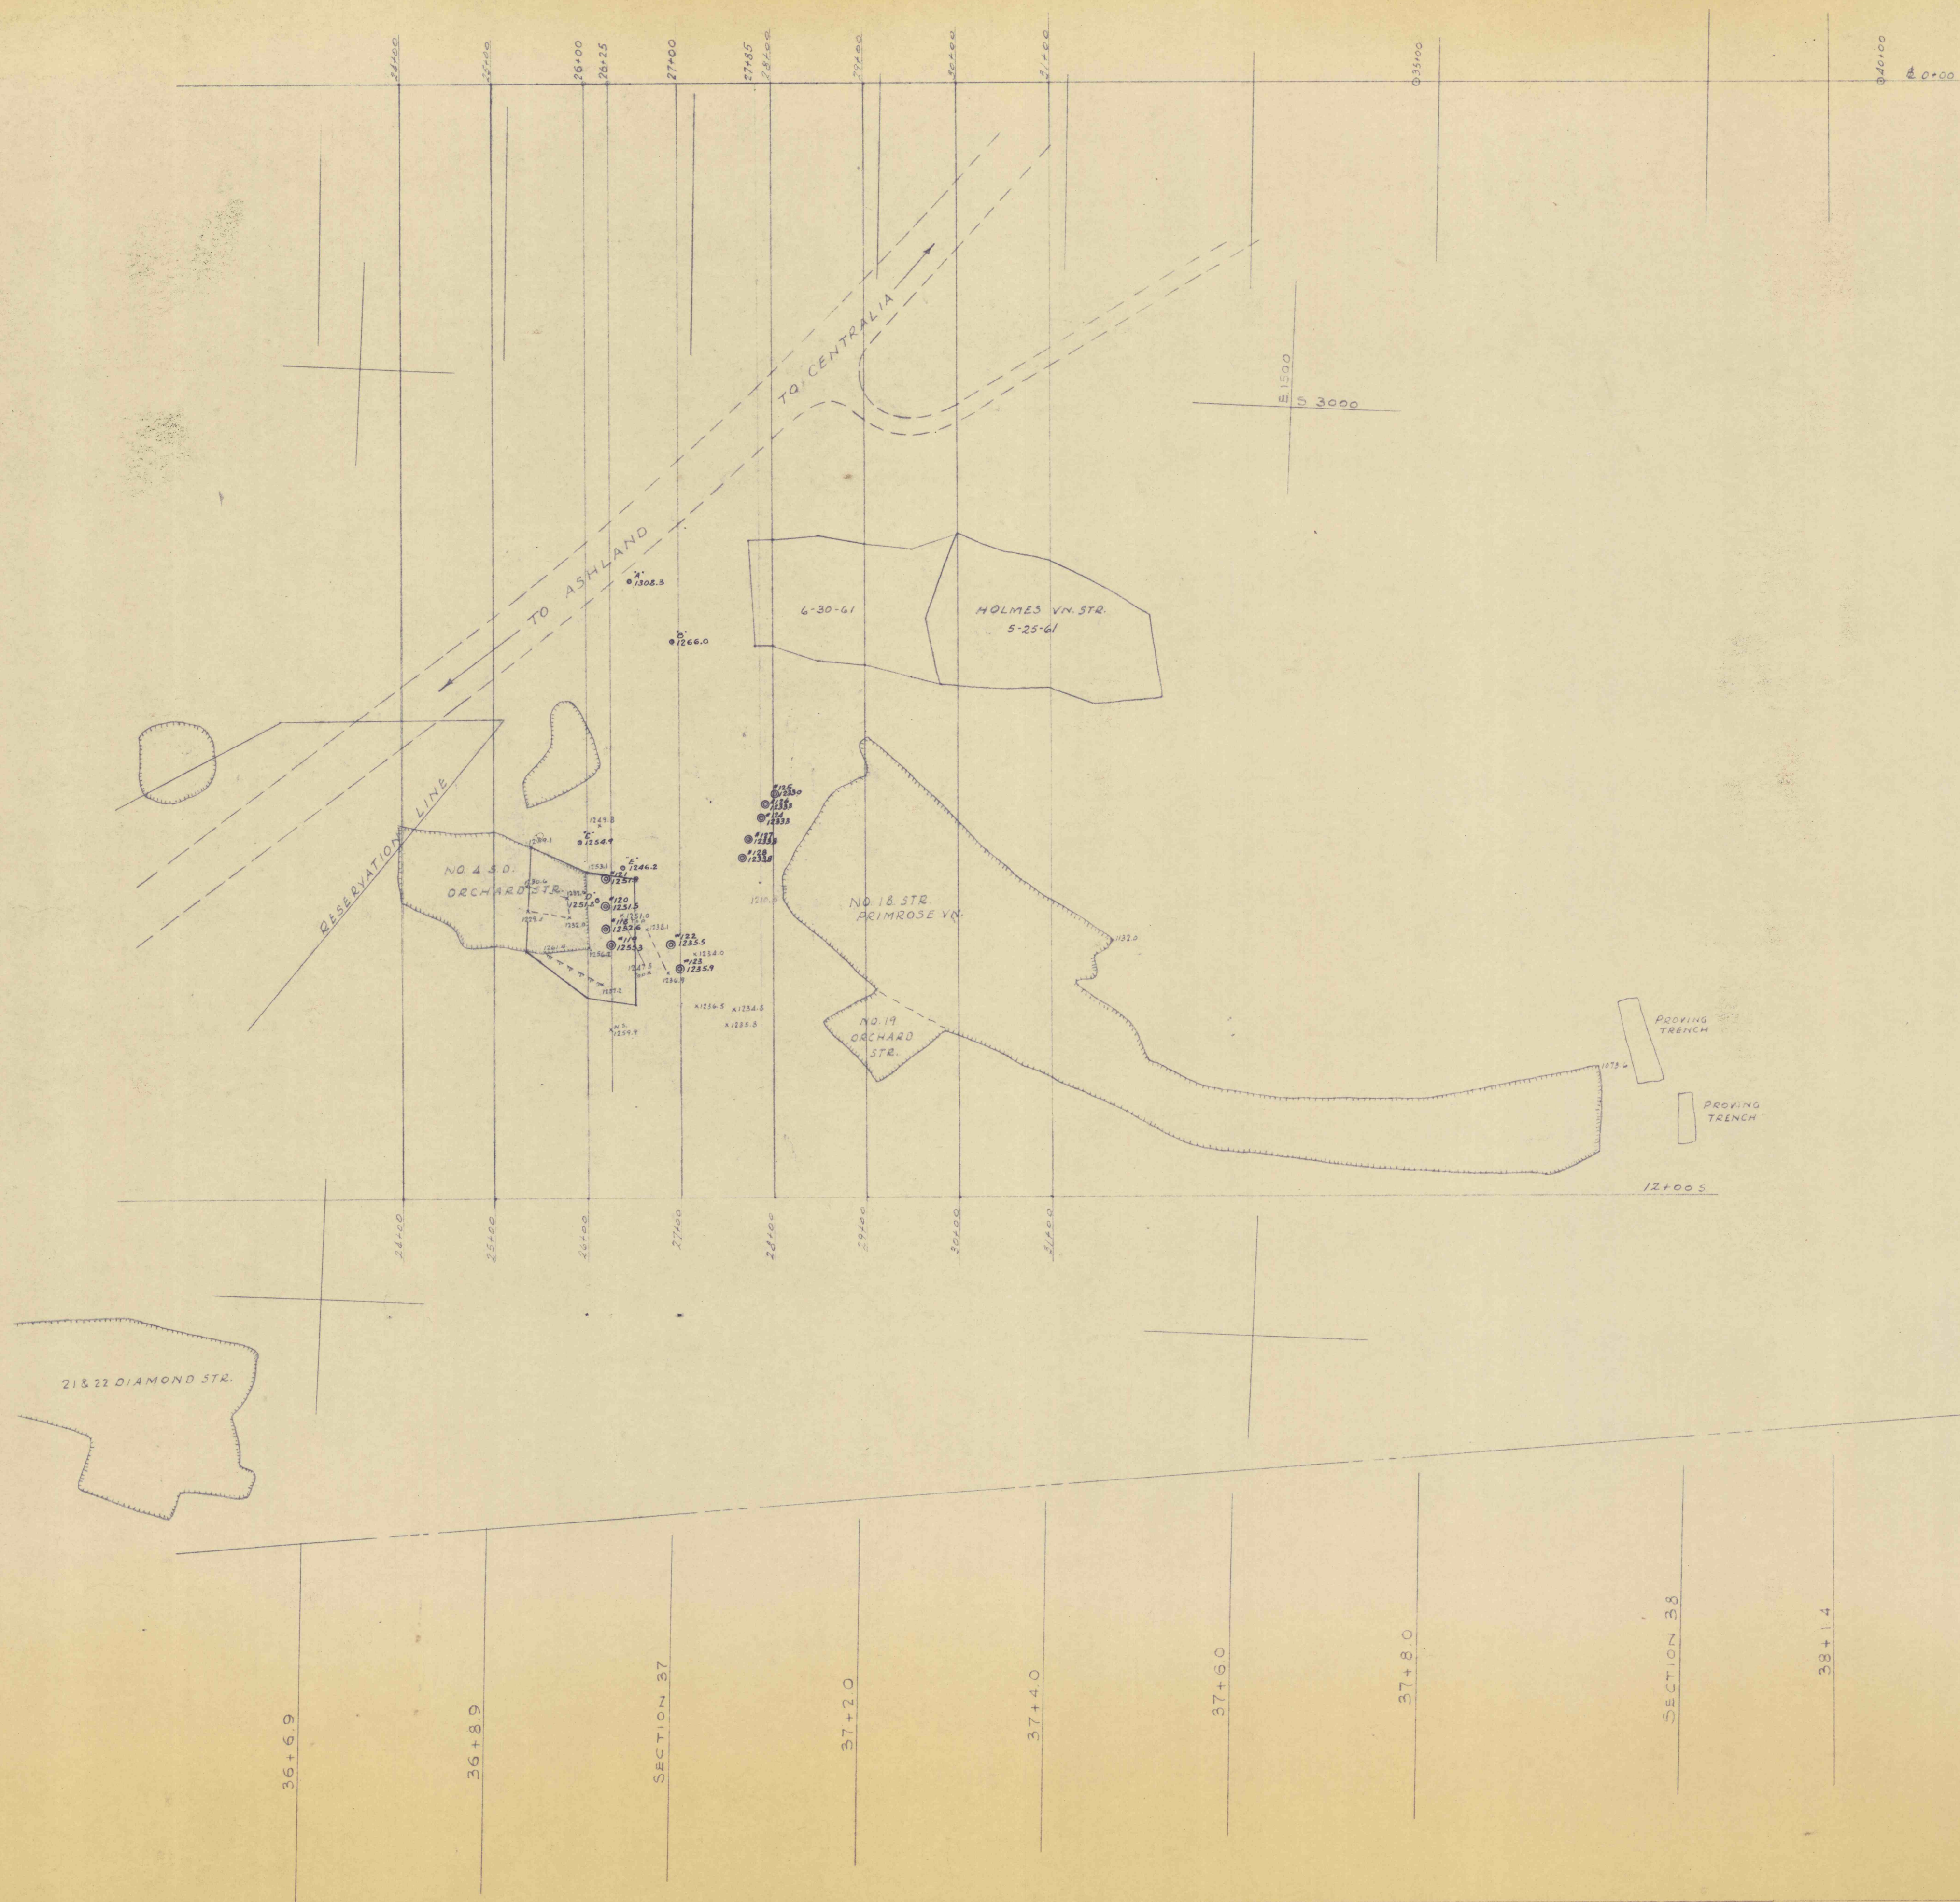

RAYEN RUN COAL CO.
LOCUST RUN STRIPING
SCALE 1"=100' 6-9-61