


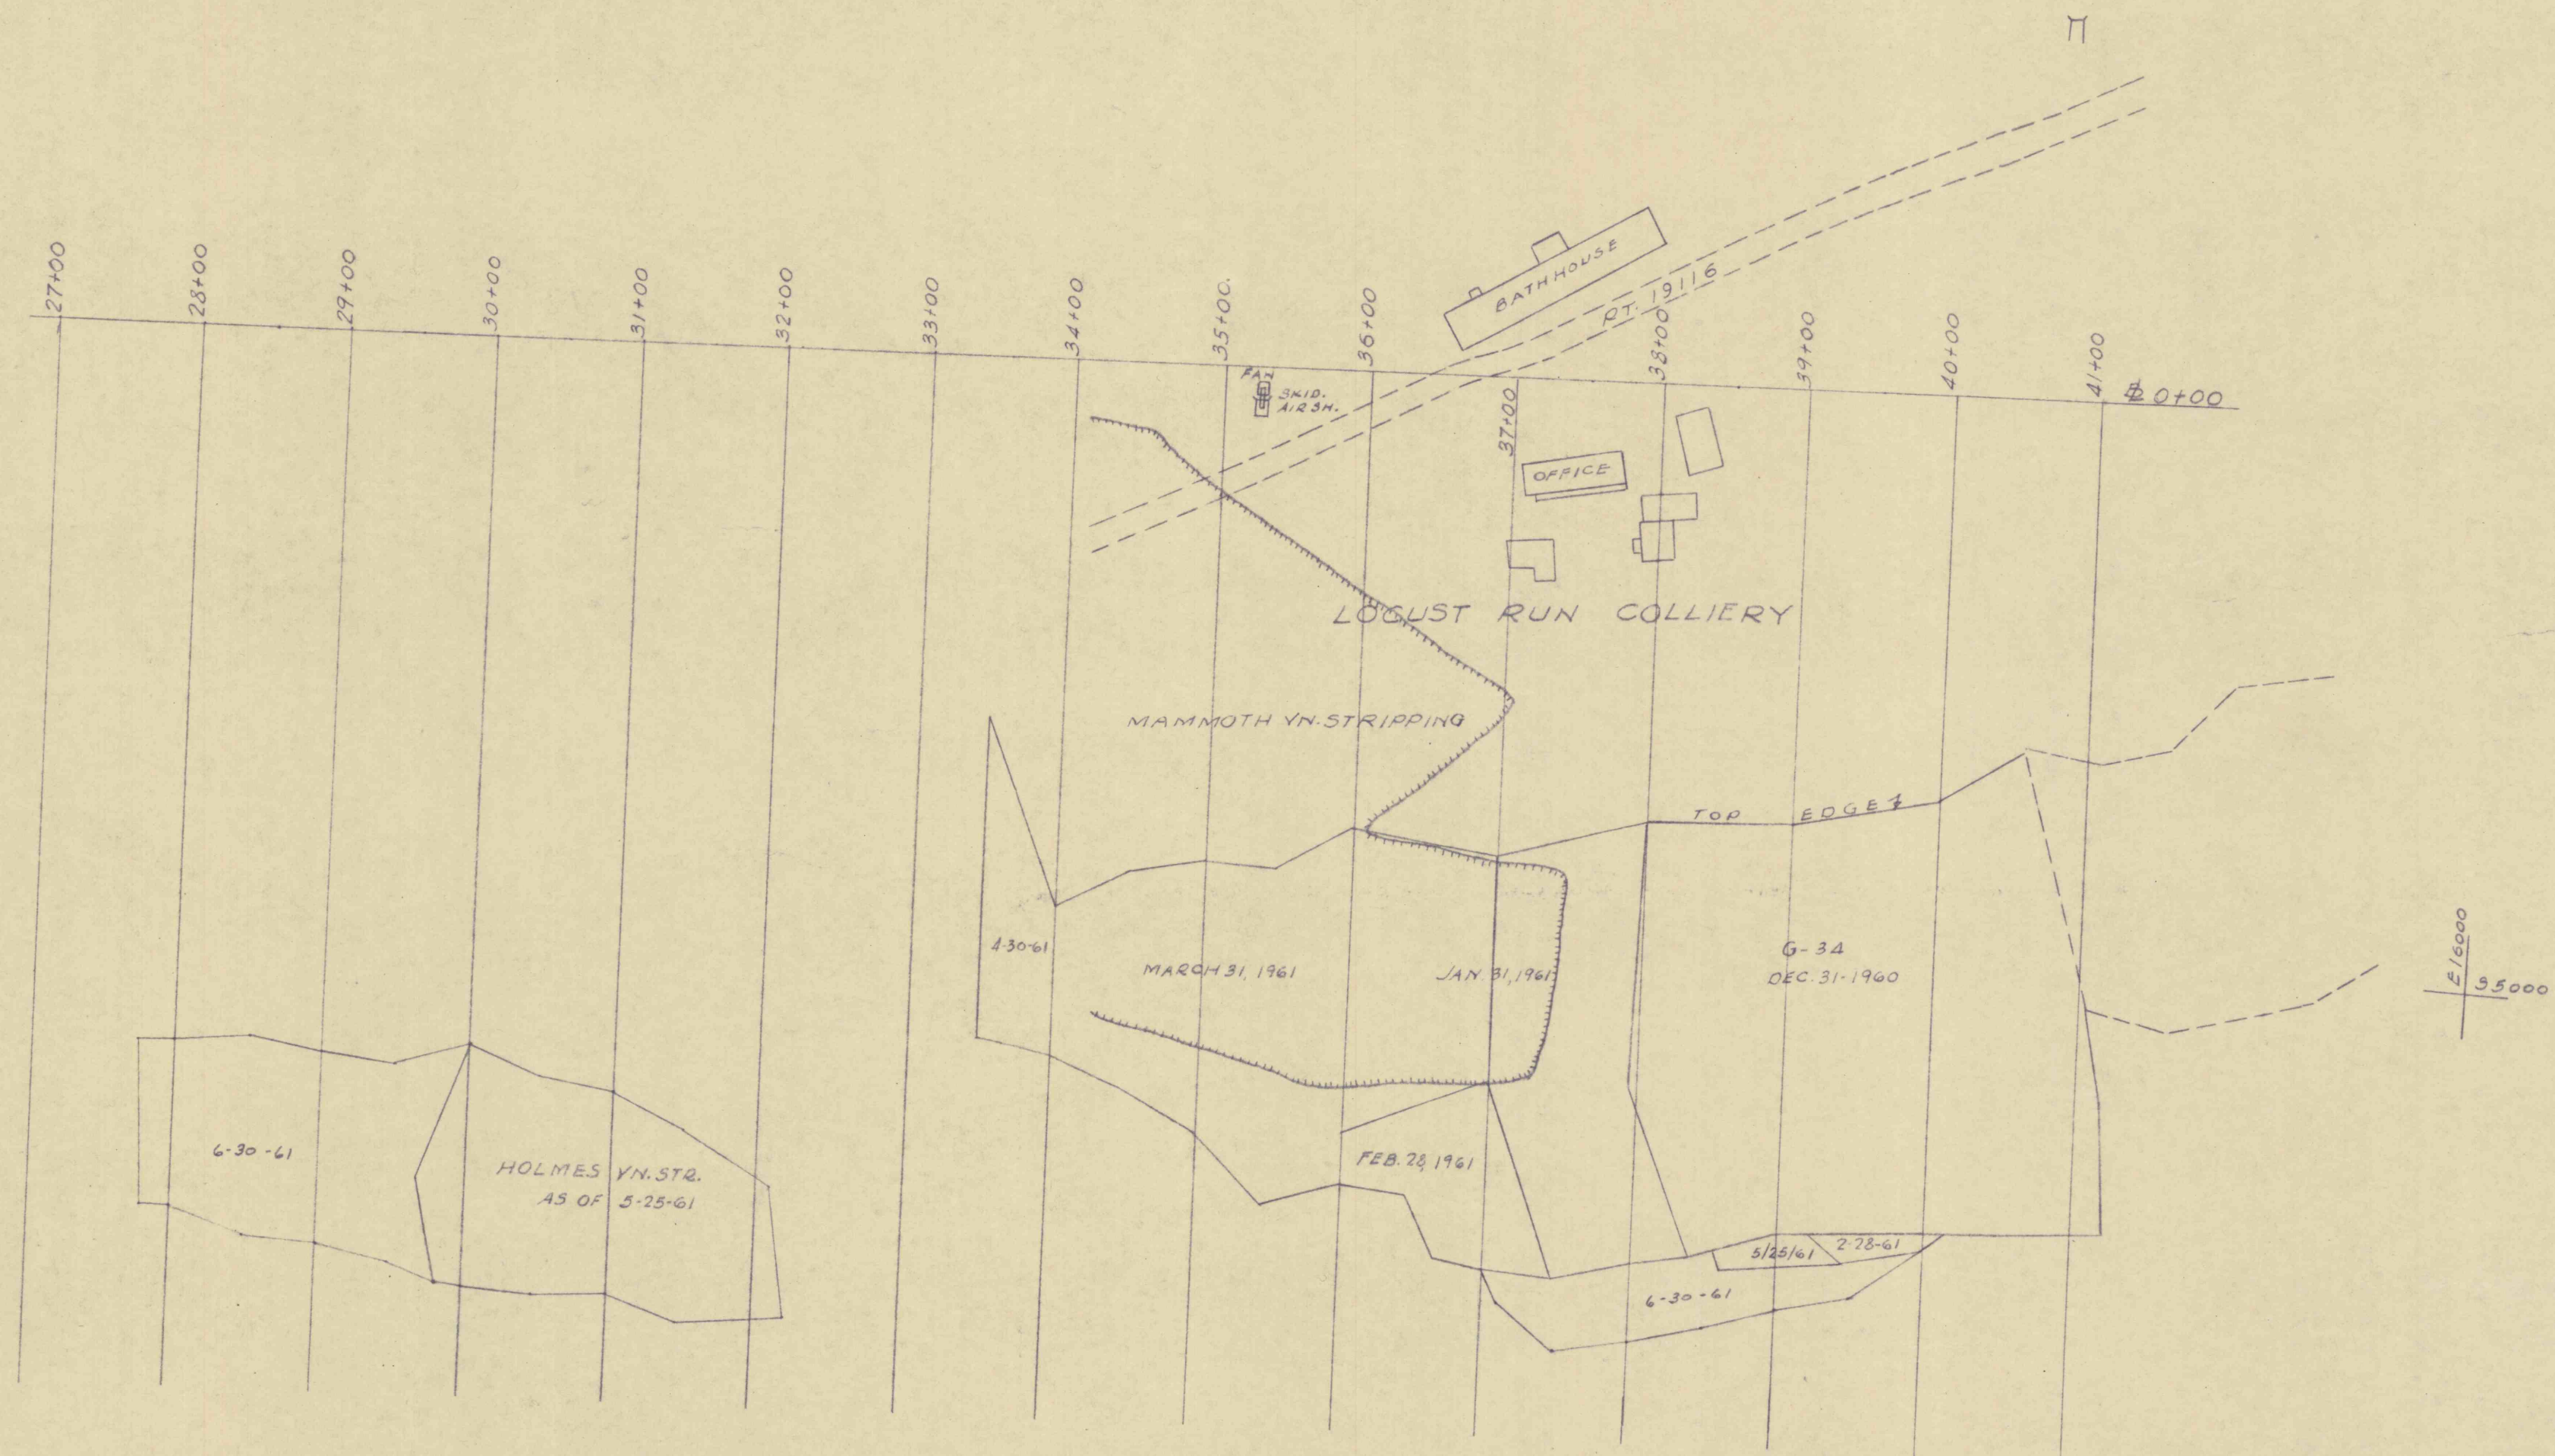

RAYEN RUN COAL CO.
 LOCUST RUN SLOPE PILLAR STRIPPING
 MAP SHOWING MAMMOTH YN. AND
 HOLMES YN. STRIPPINGS
 SCALE 1"=100' 5-31-61
 J. ROBERT BAZLEY INC.