


39 + 7.5

SECTION 39+7.5

Scale 1"=100'

NORTH

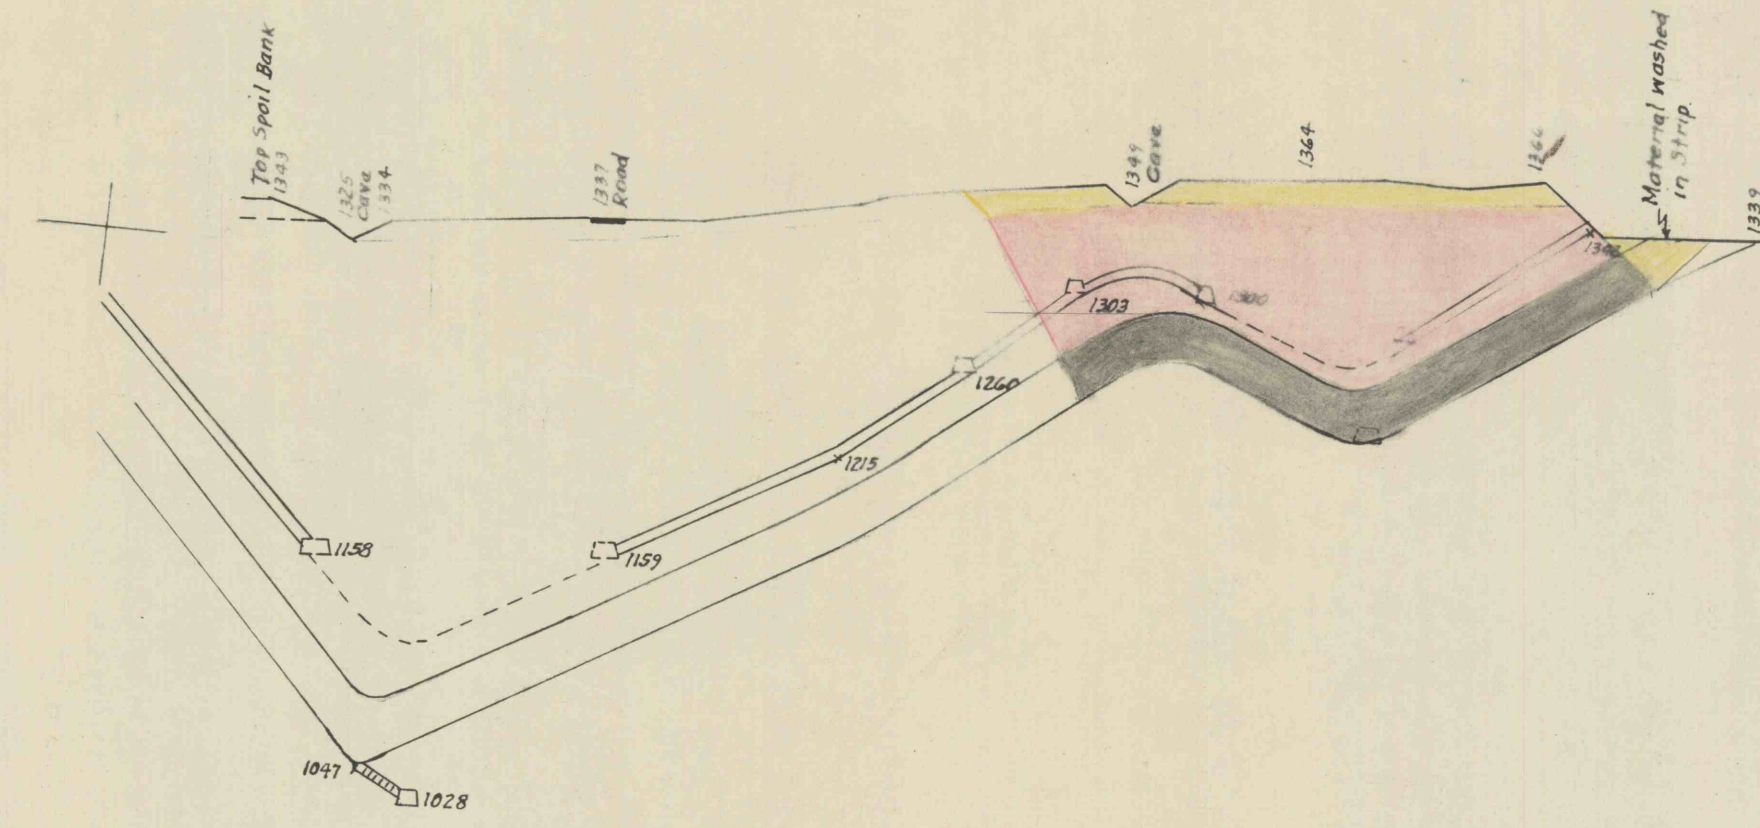

DAT. 1000'

DAT. 1000'