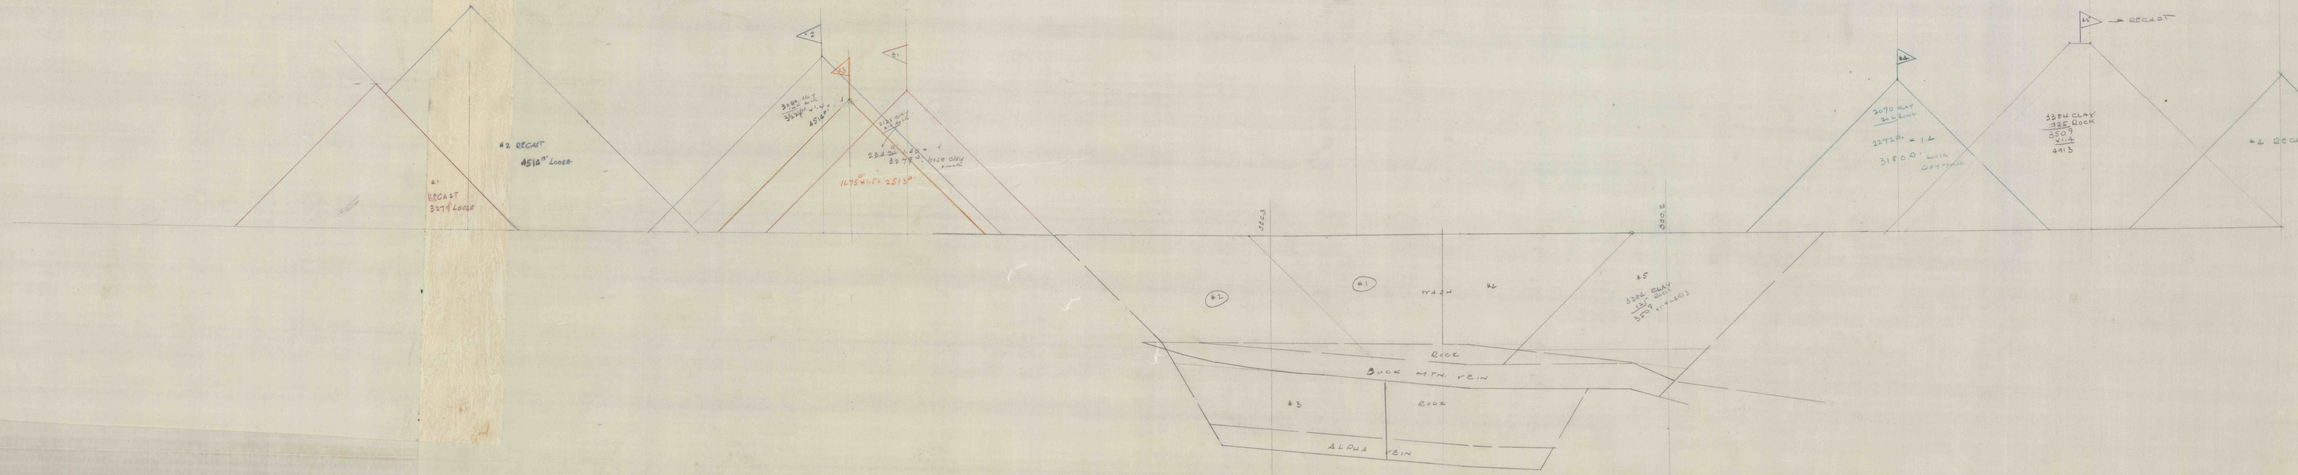

1"=20'

DRAWING HEIGHT 84'
RADIUS 100'
45° BOOM PITCH
2500 SERIES CRANE

HIGHLAND NO.