


168° 00' N

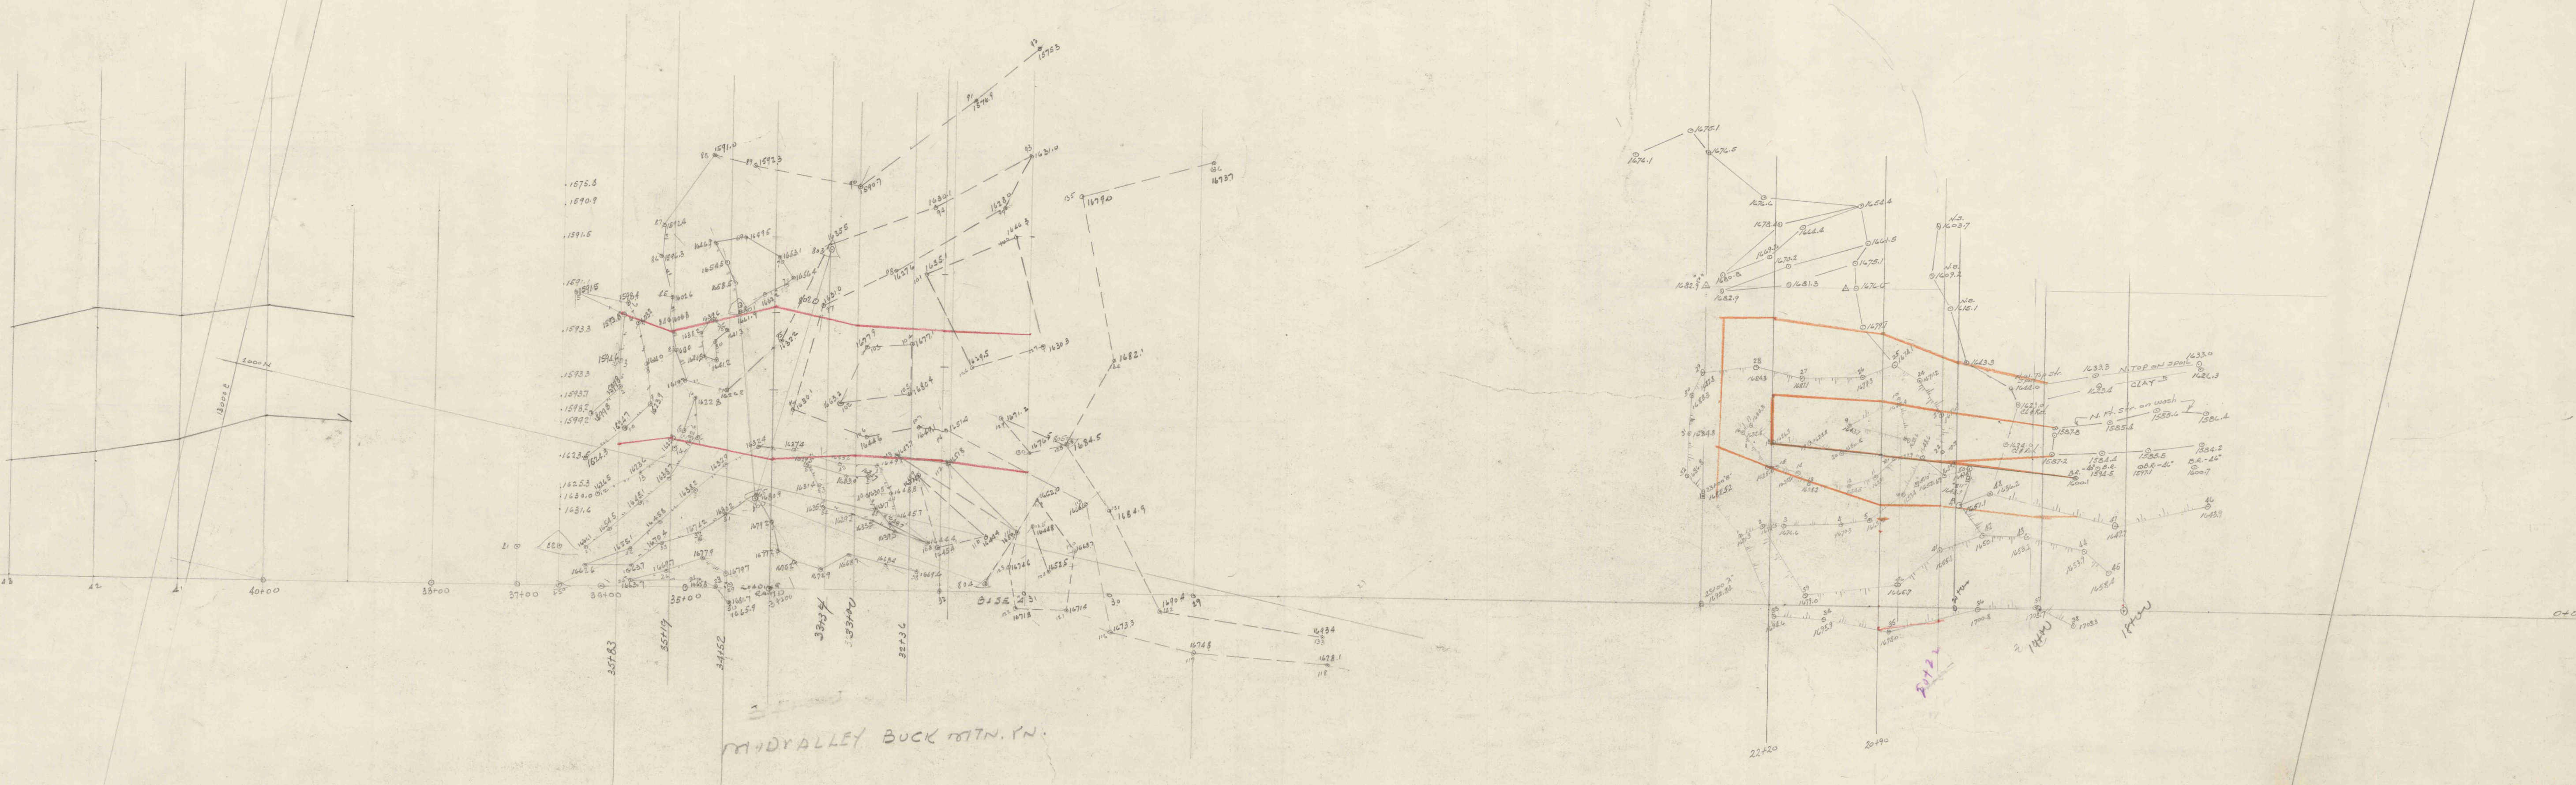

1577. m
37+50 157p
39+50

14.000
130.24
91.1