
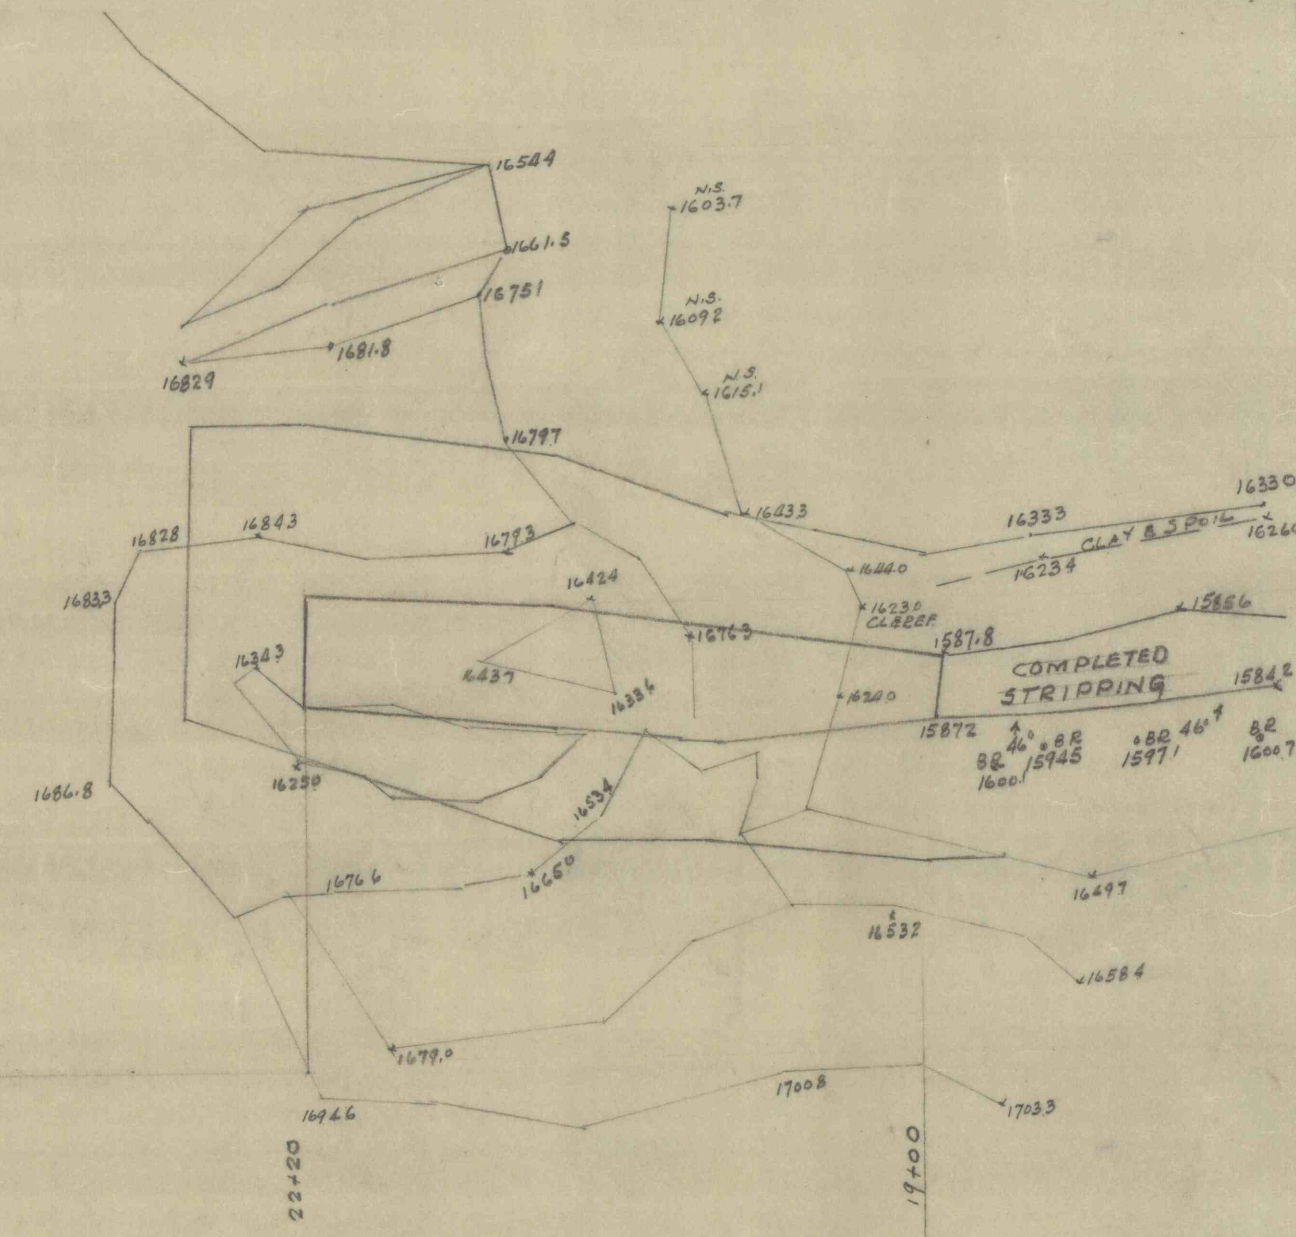


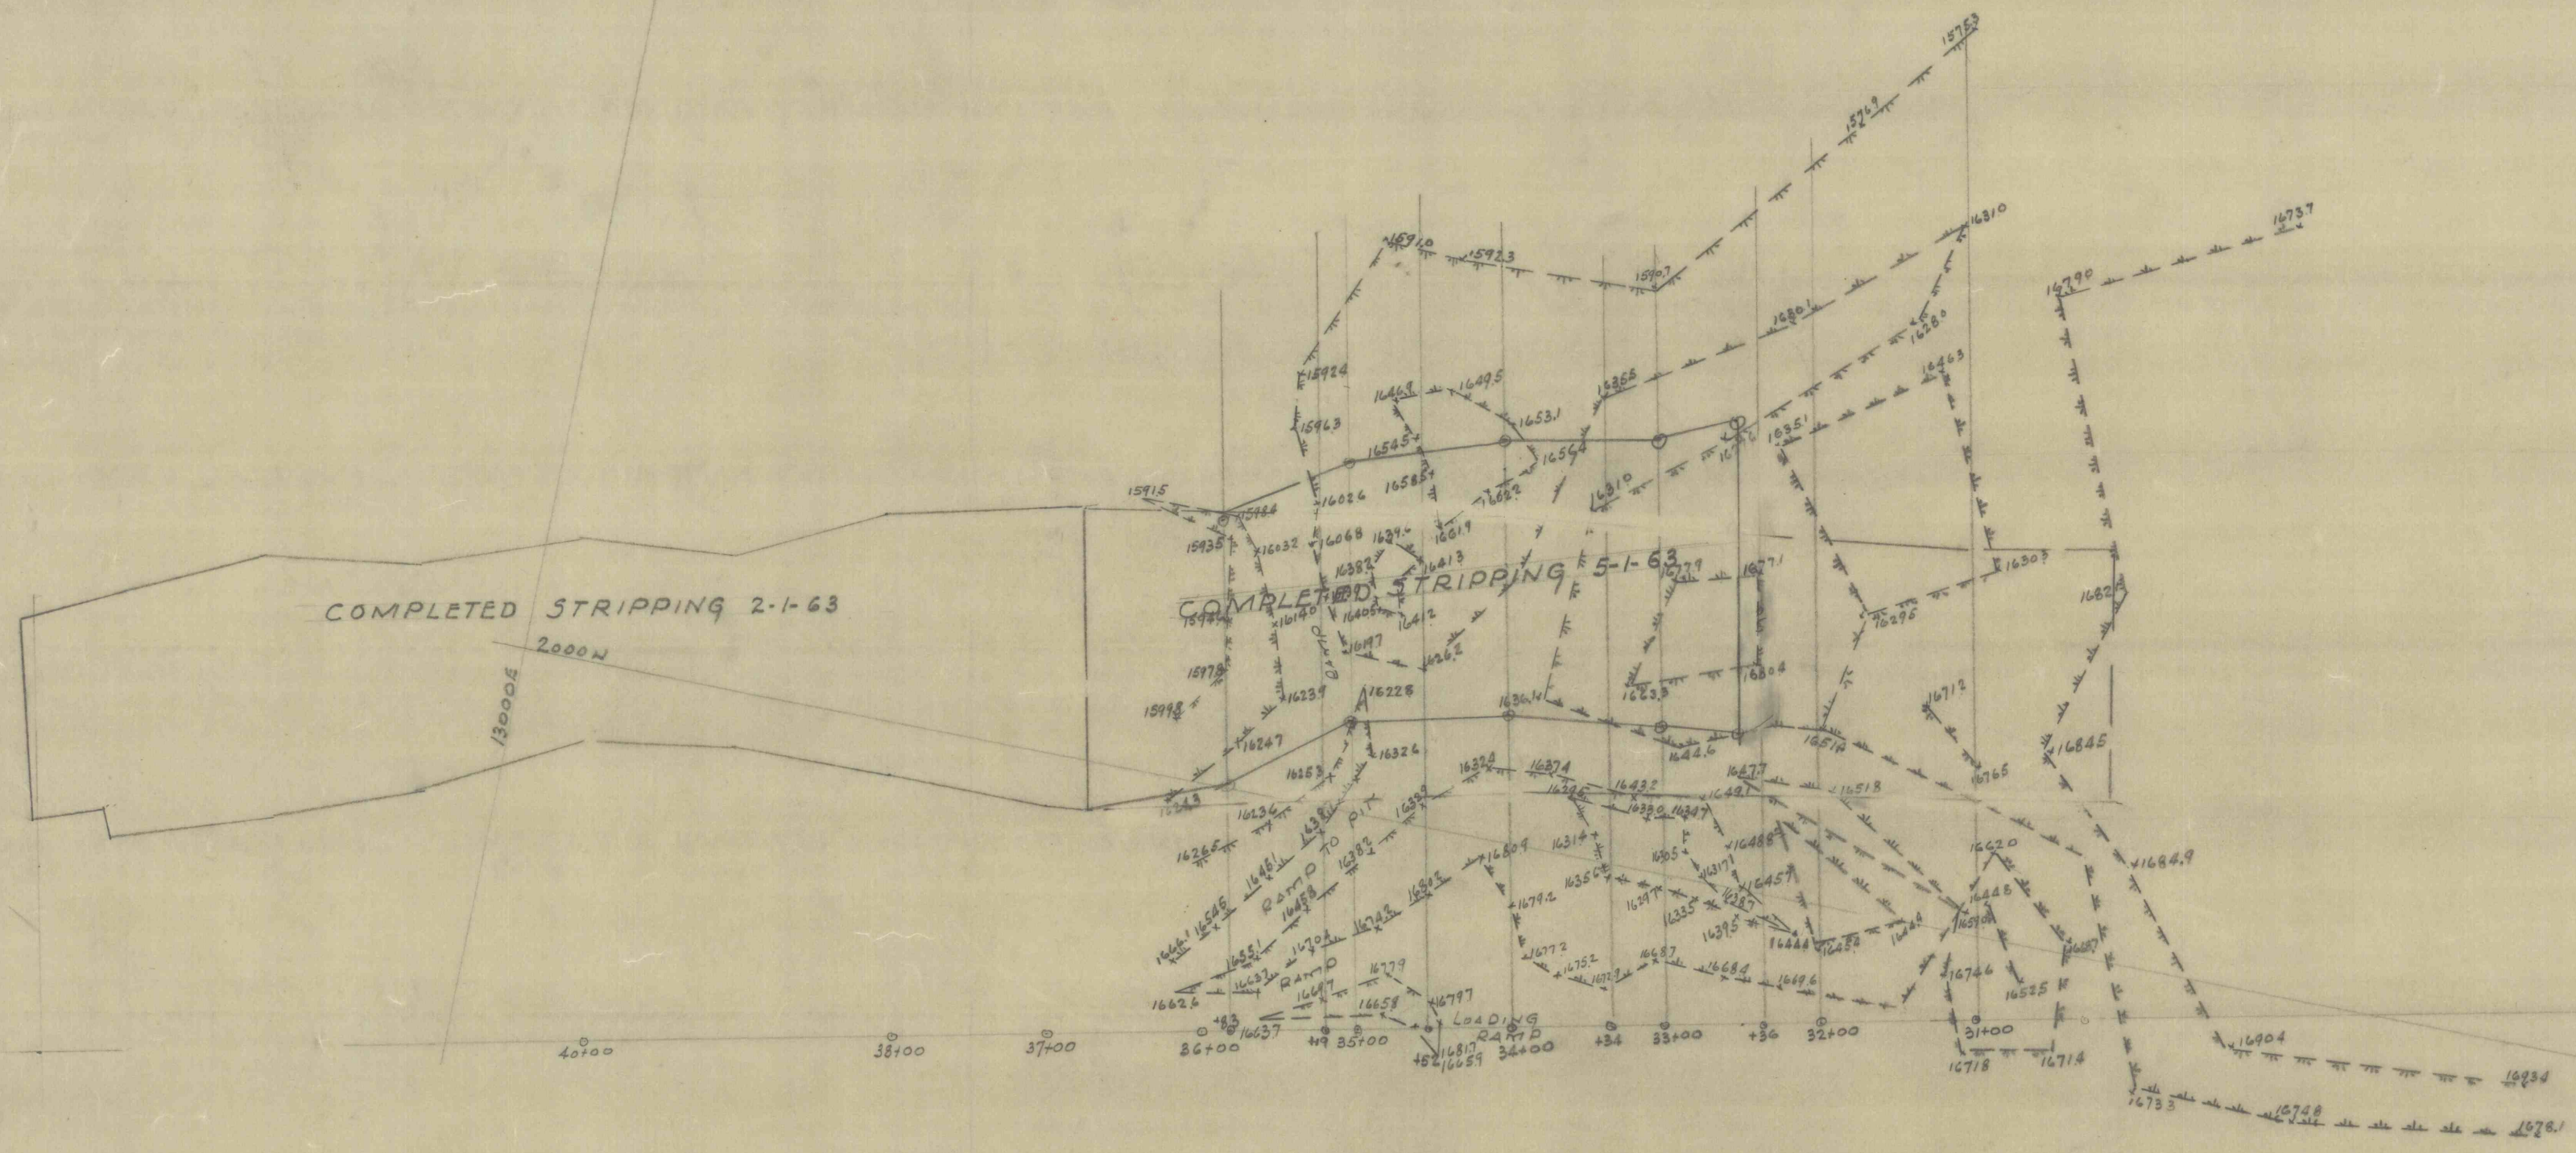

MIDVALLEY COLLIERY
BUCK MTN. VEIN N.D. STRIPPING
SCALE 1"=100' 2-1-63