
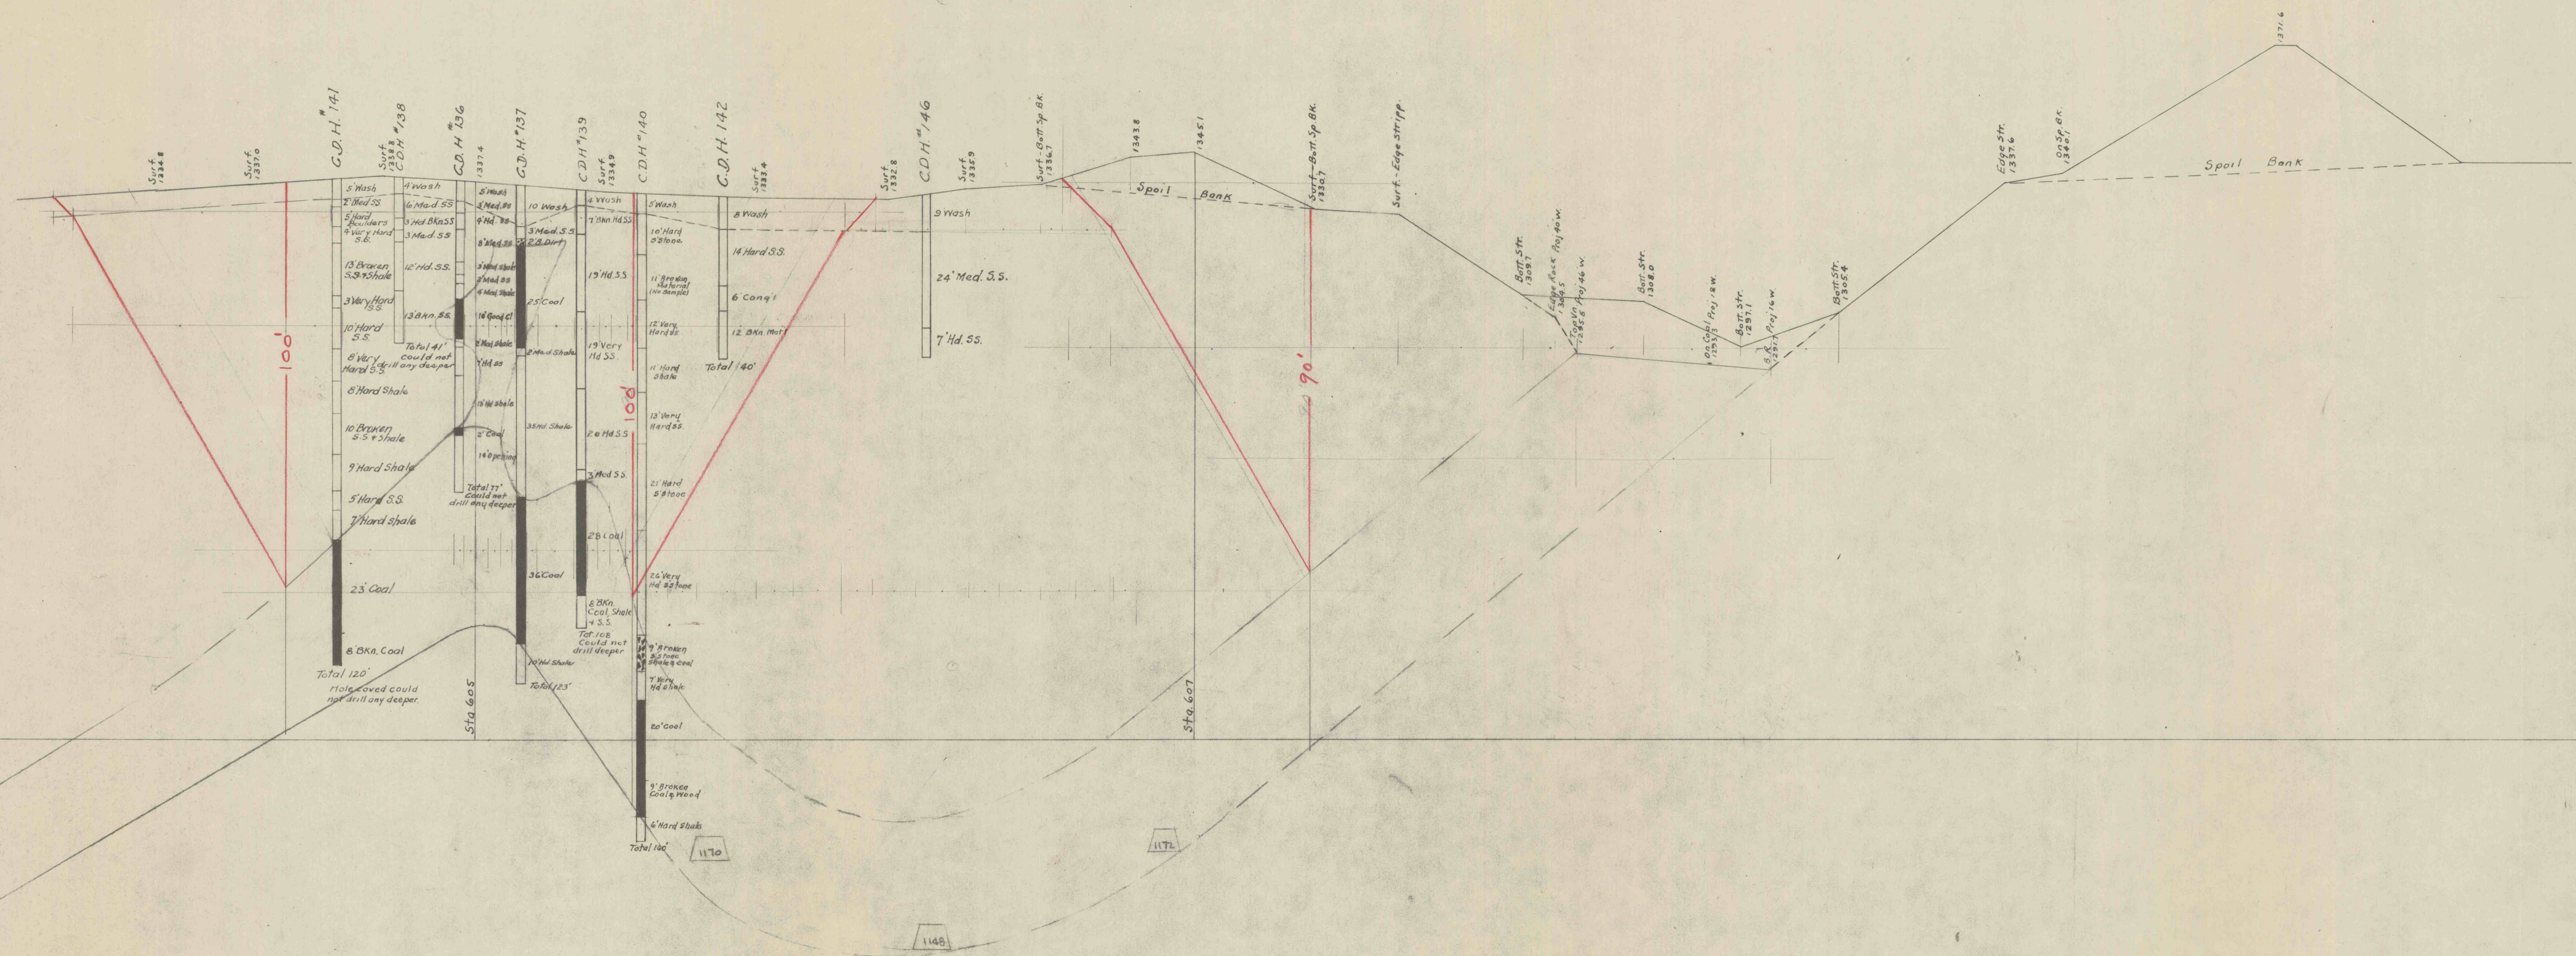


LOCUST RUN SECTION

PROVING LINE NO. 18 $\frac{1}{4}$

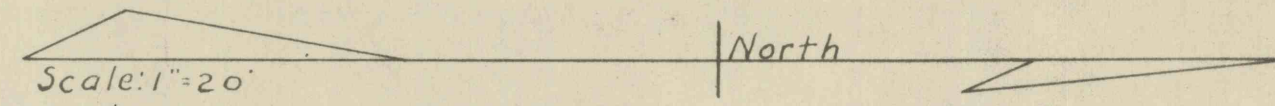

Datum 1200'