


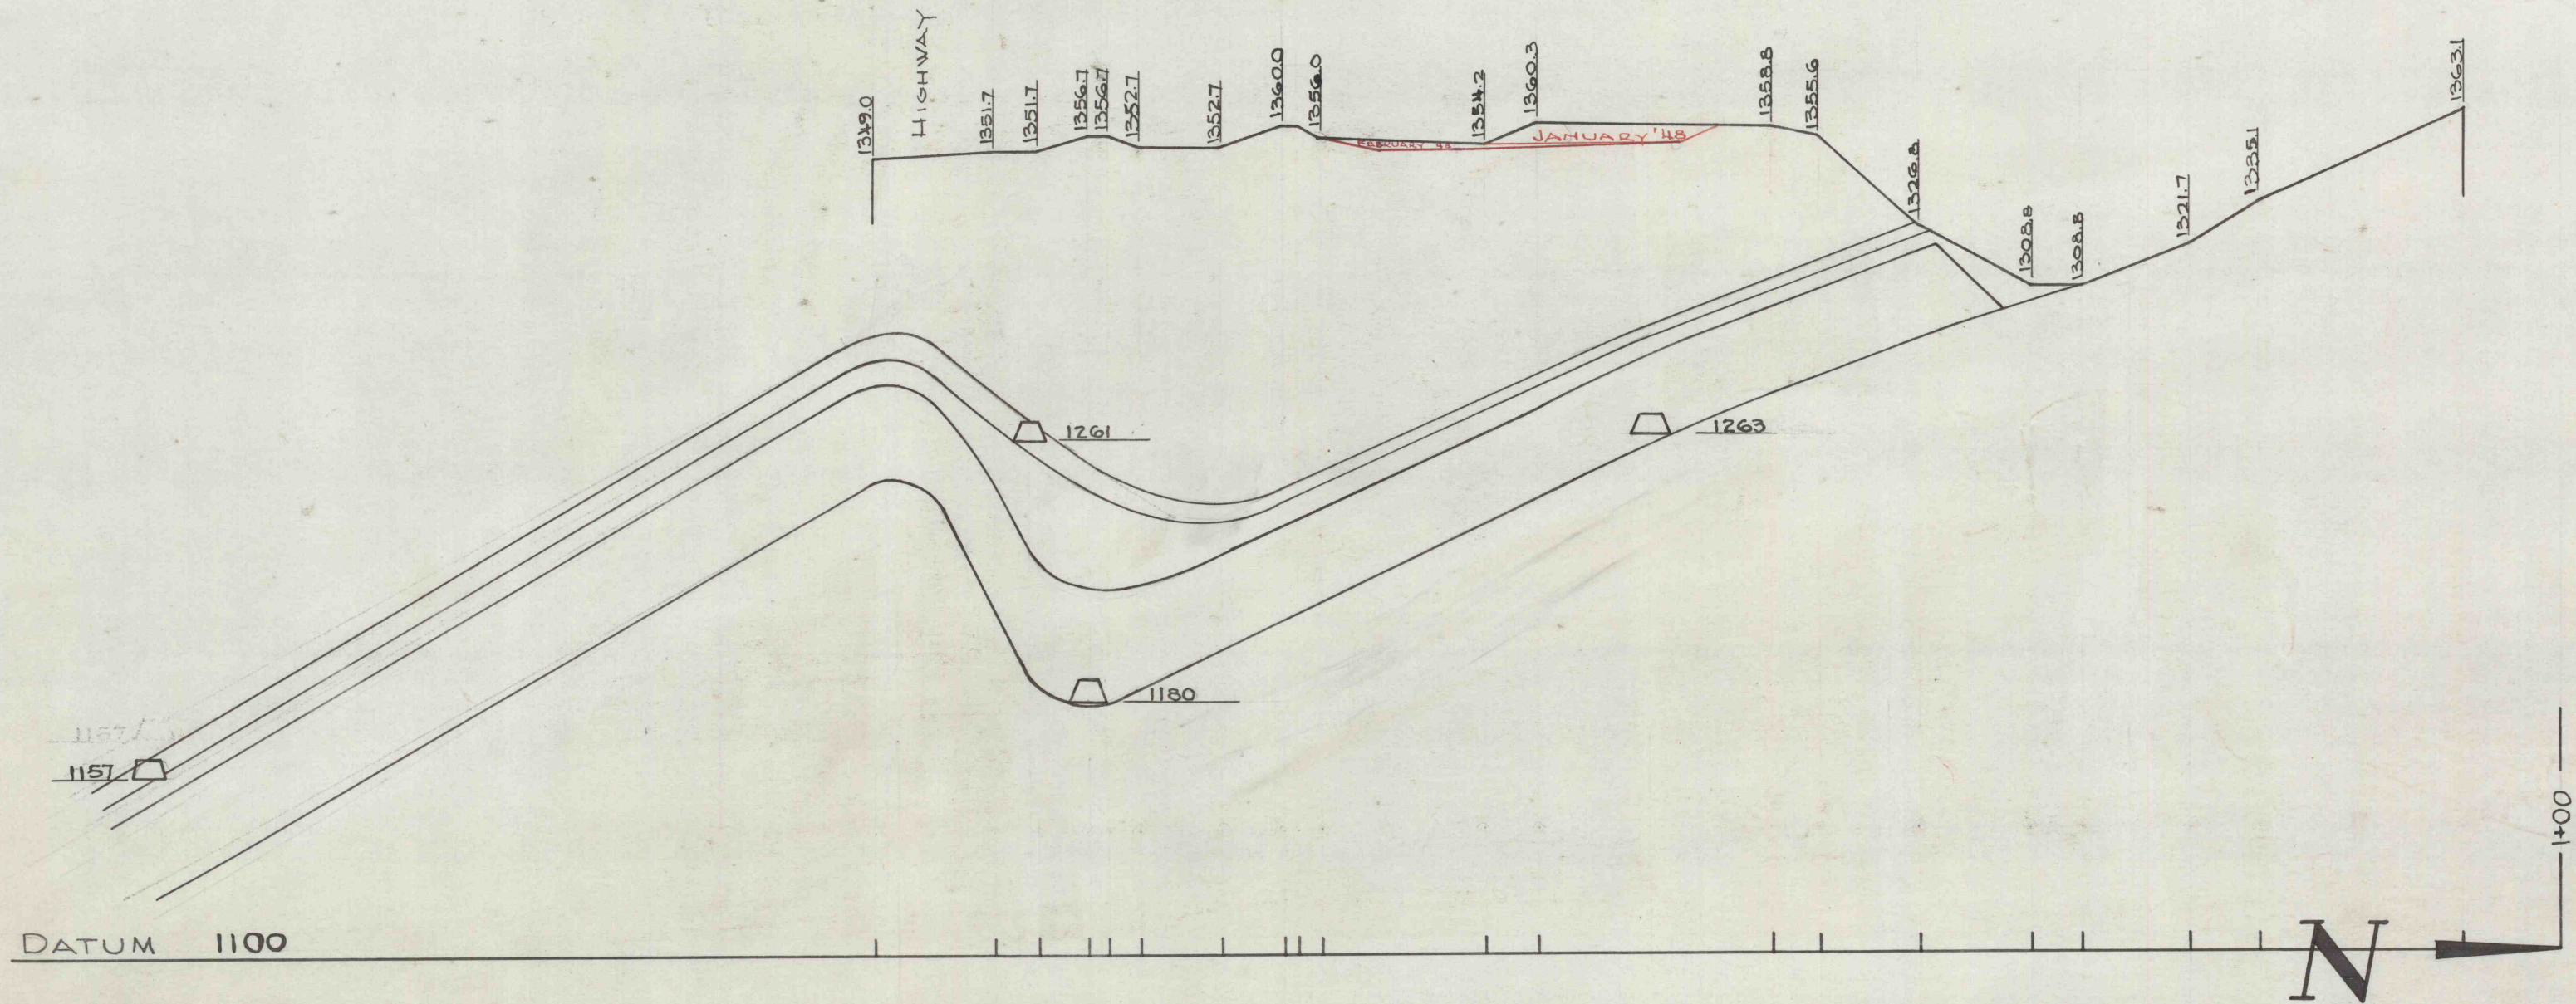

J. ROBERT BAZLEY, Inc.			
POTTSVILLE, PENNA.			
RAVEN RUN COAL CO.			
*20 BYRNESVILLE MAMMOTH STRIPPING			
SECTION 15+00			
DATE	SCALE	BY	
6-16-48	1"=50'	CWM	