


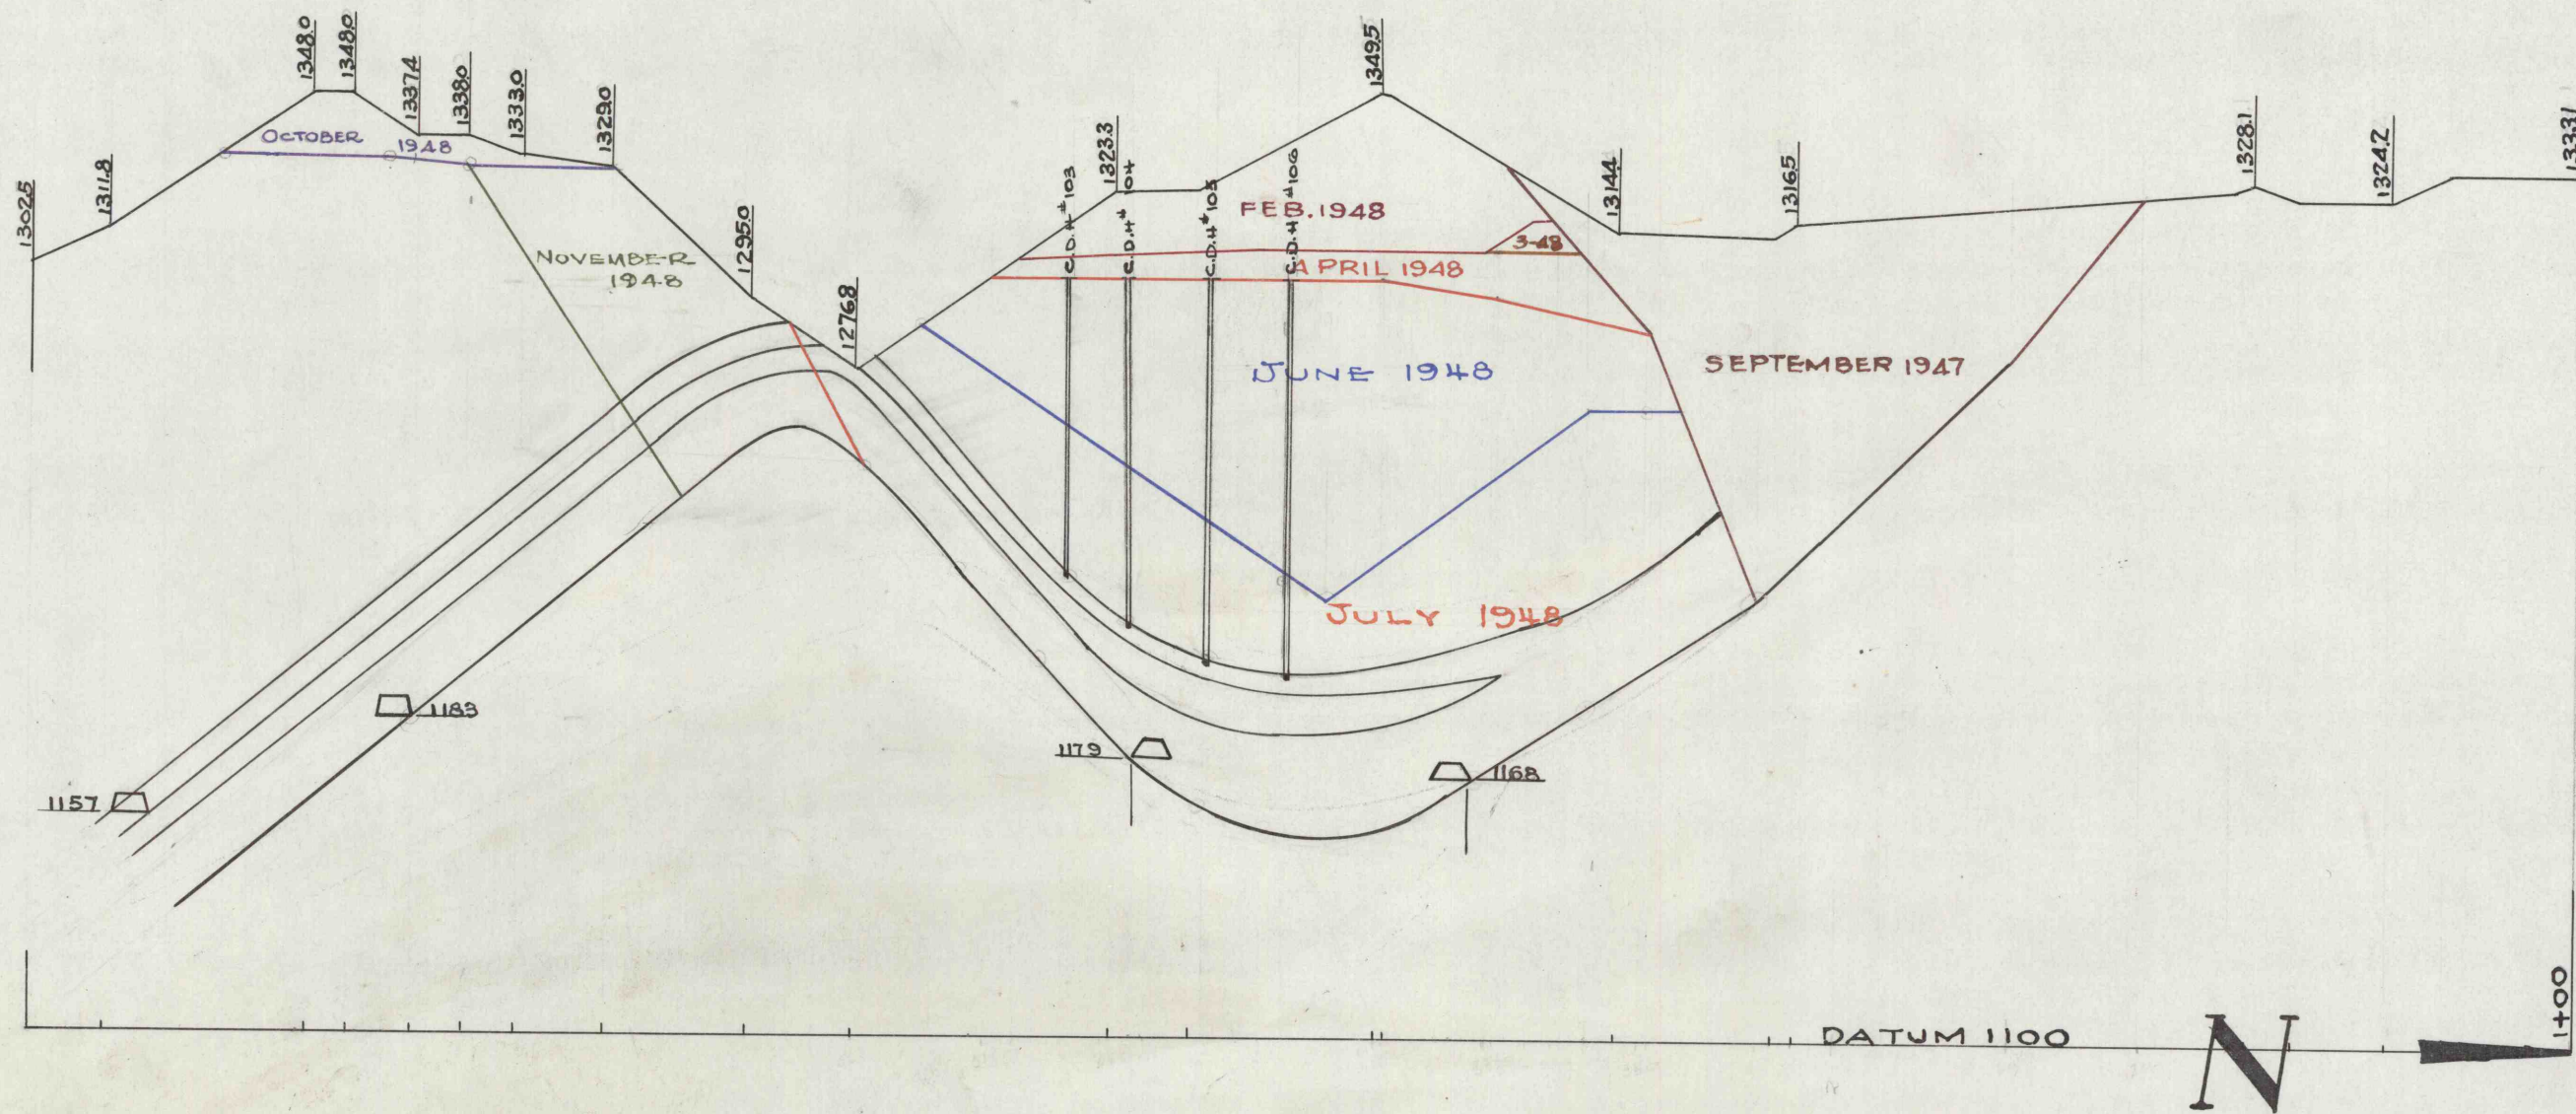

|                                |        |    |  |
|--------------------------------|--------|----|--|
| J. ROBERT BAZLEY, Inc.         |        |    |  |
| POTTSVILLE, PENNA.             |        |    |  |
| RAVEN RUN COAL CO.             |        |    |  |
| #20 BYRNESVILLE MAM.VN.STRIPP. |        |    |  |
| SECTION 9+00                   |        |    |  |
| DATE                           | SCALE  | BY |  |
| 6-48                           | 1"=50' |    |  |