


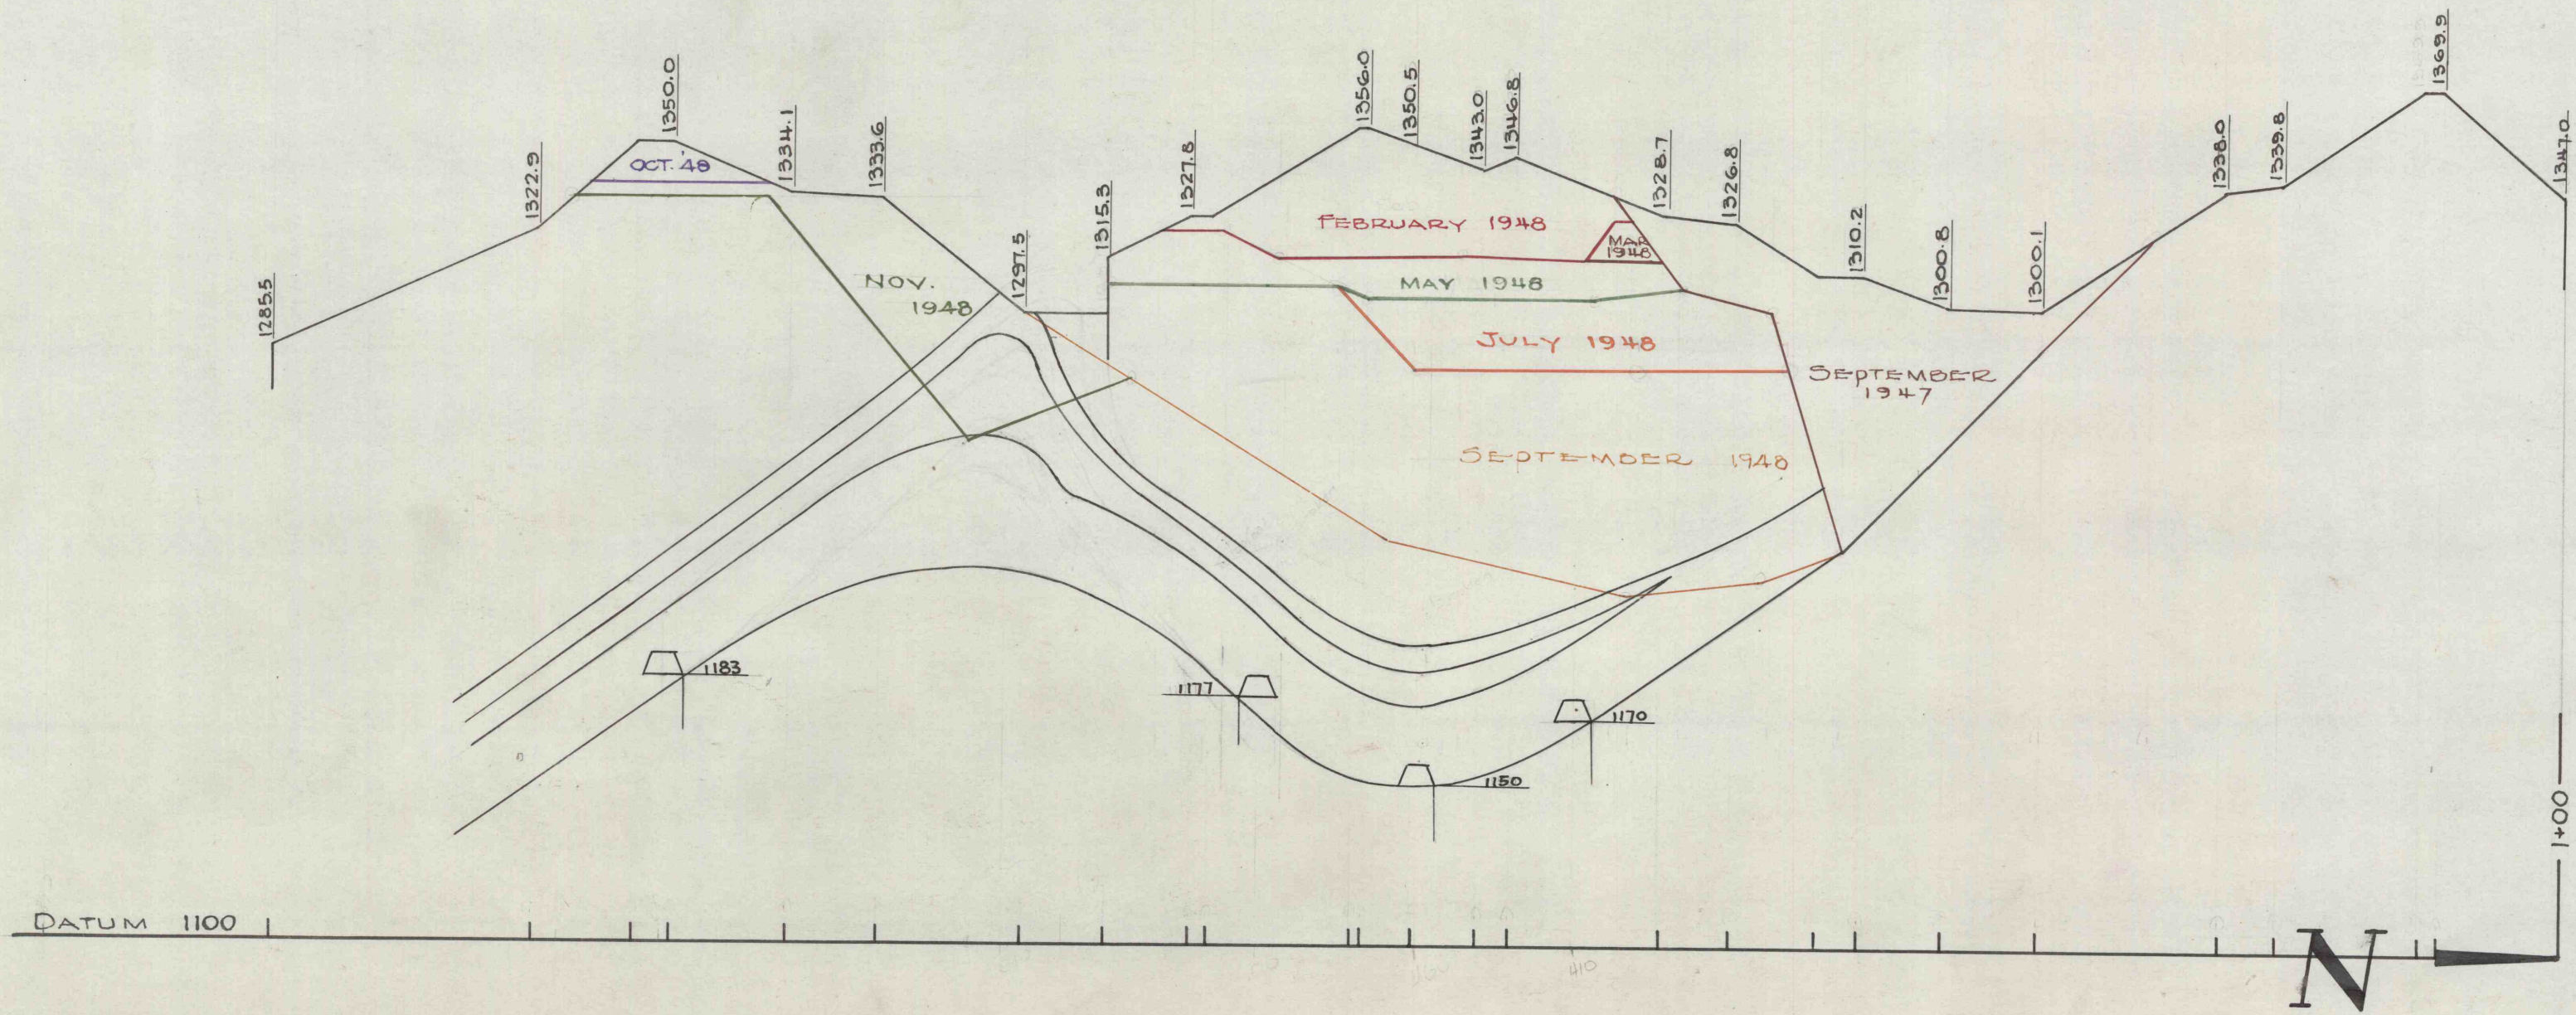

J. ROBERT BAZLEY, Inc.
 POTTSVILLE, PENNA.
 RAVEN RUN COAL CO.
 20 BYRNESVILLE MAMMOTH STRIPPING
 SECTION 10+00
 DATE 6-19-48 SCALE 1"=50' BY C.W.M.