


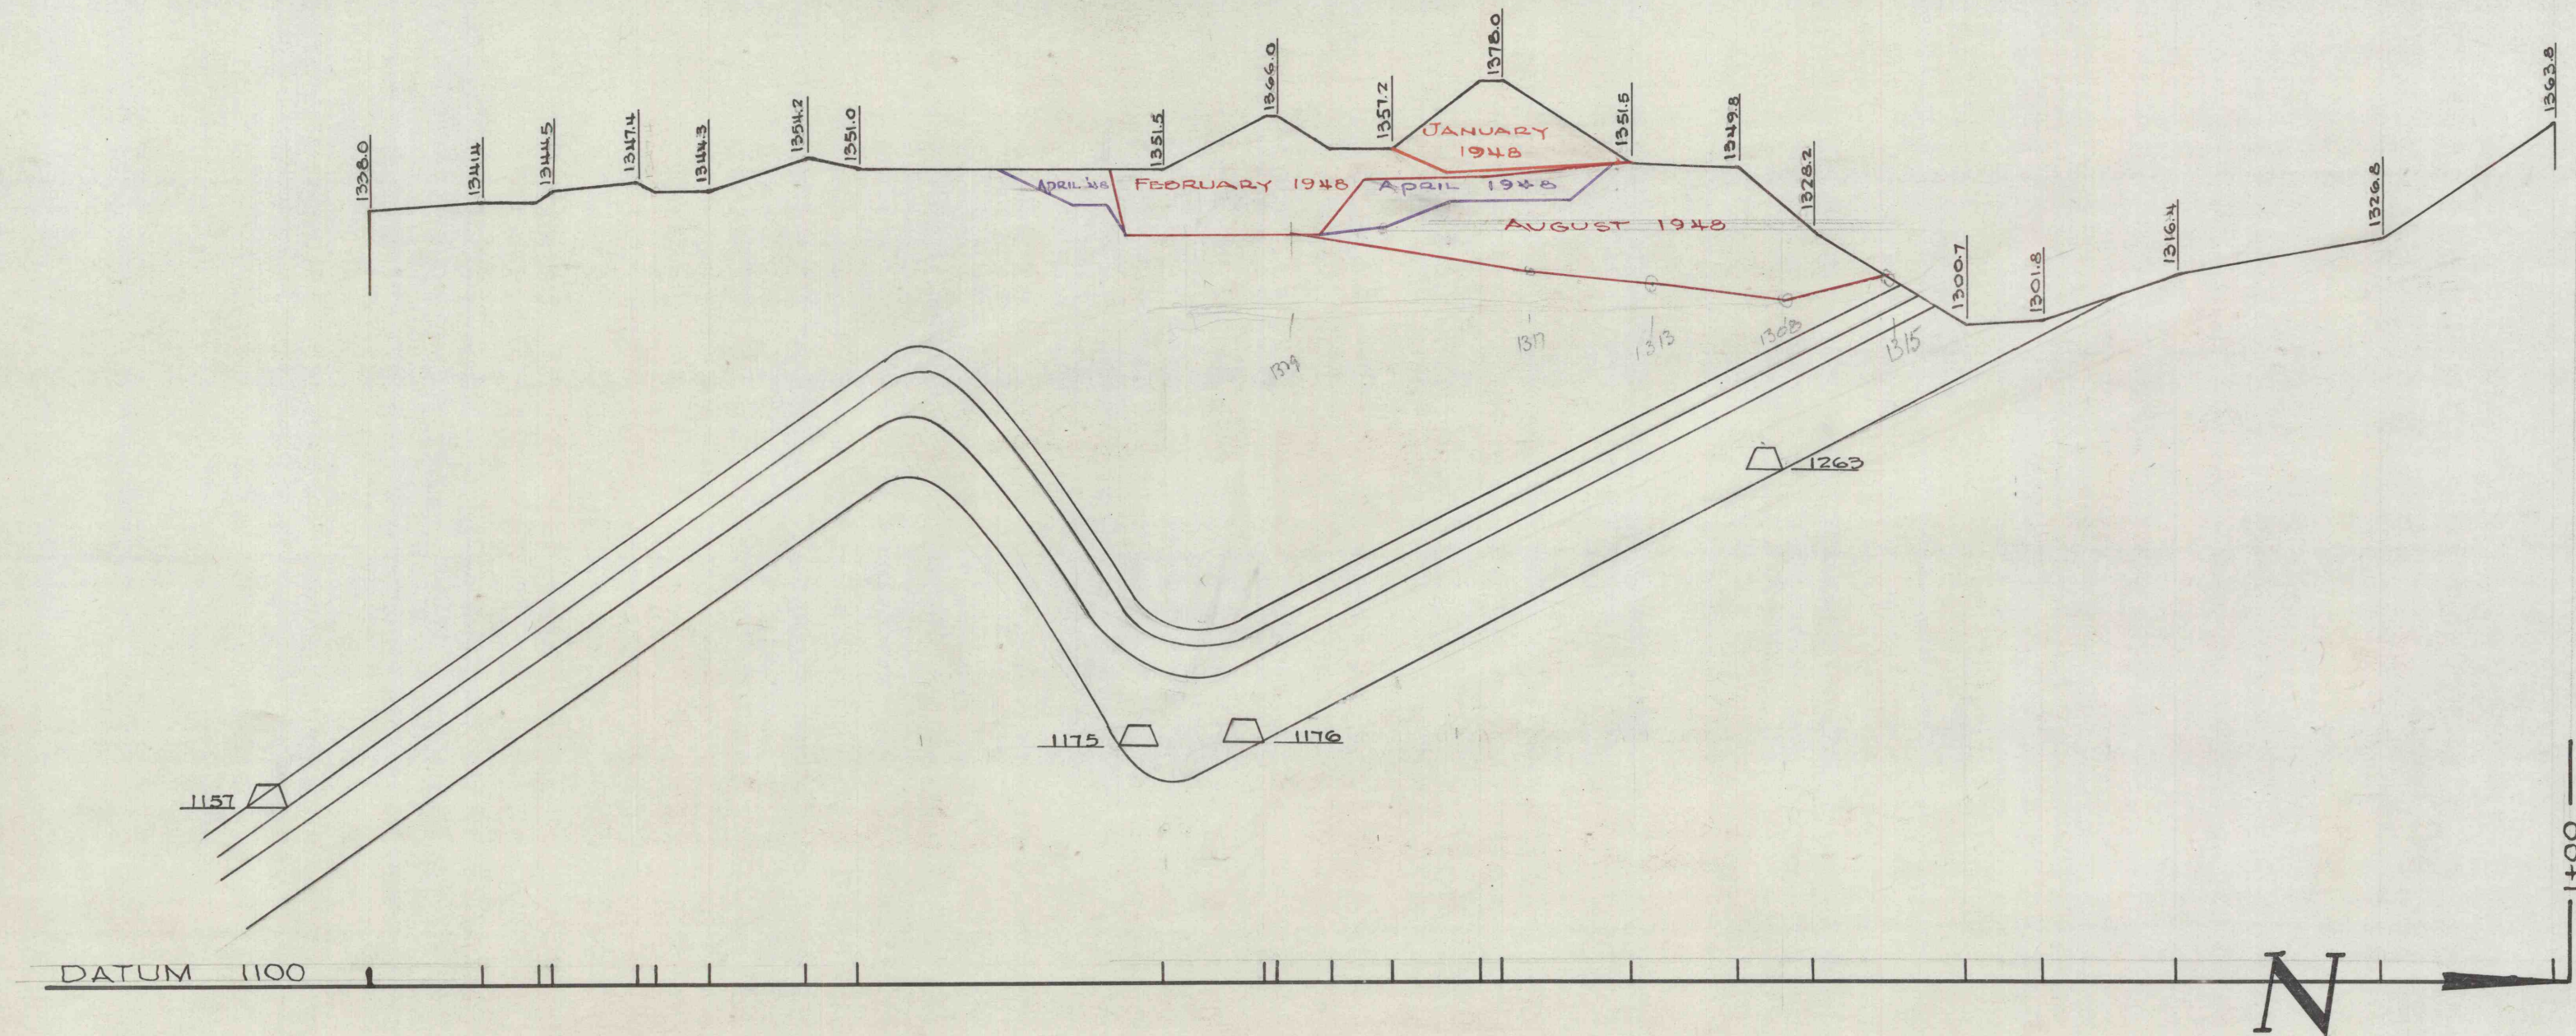

J. ROBERT BAZLEY, Inc.			
POTTSVILLE, PENNA.			
RAVEN RUN COAL CO			
*20 BYRNESVILLE MAMMOTH STRIPPING			
SECTION 14+00			
DATE	SCALE	BY	CHECKED
6-18-48	1"=50'	C.N.M.	