


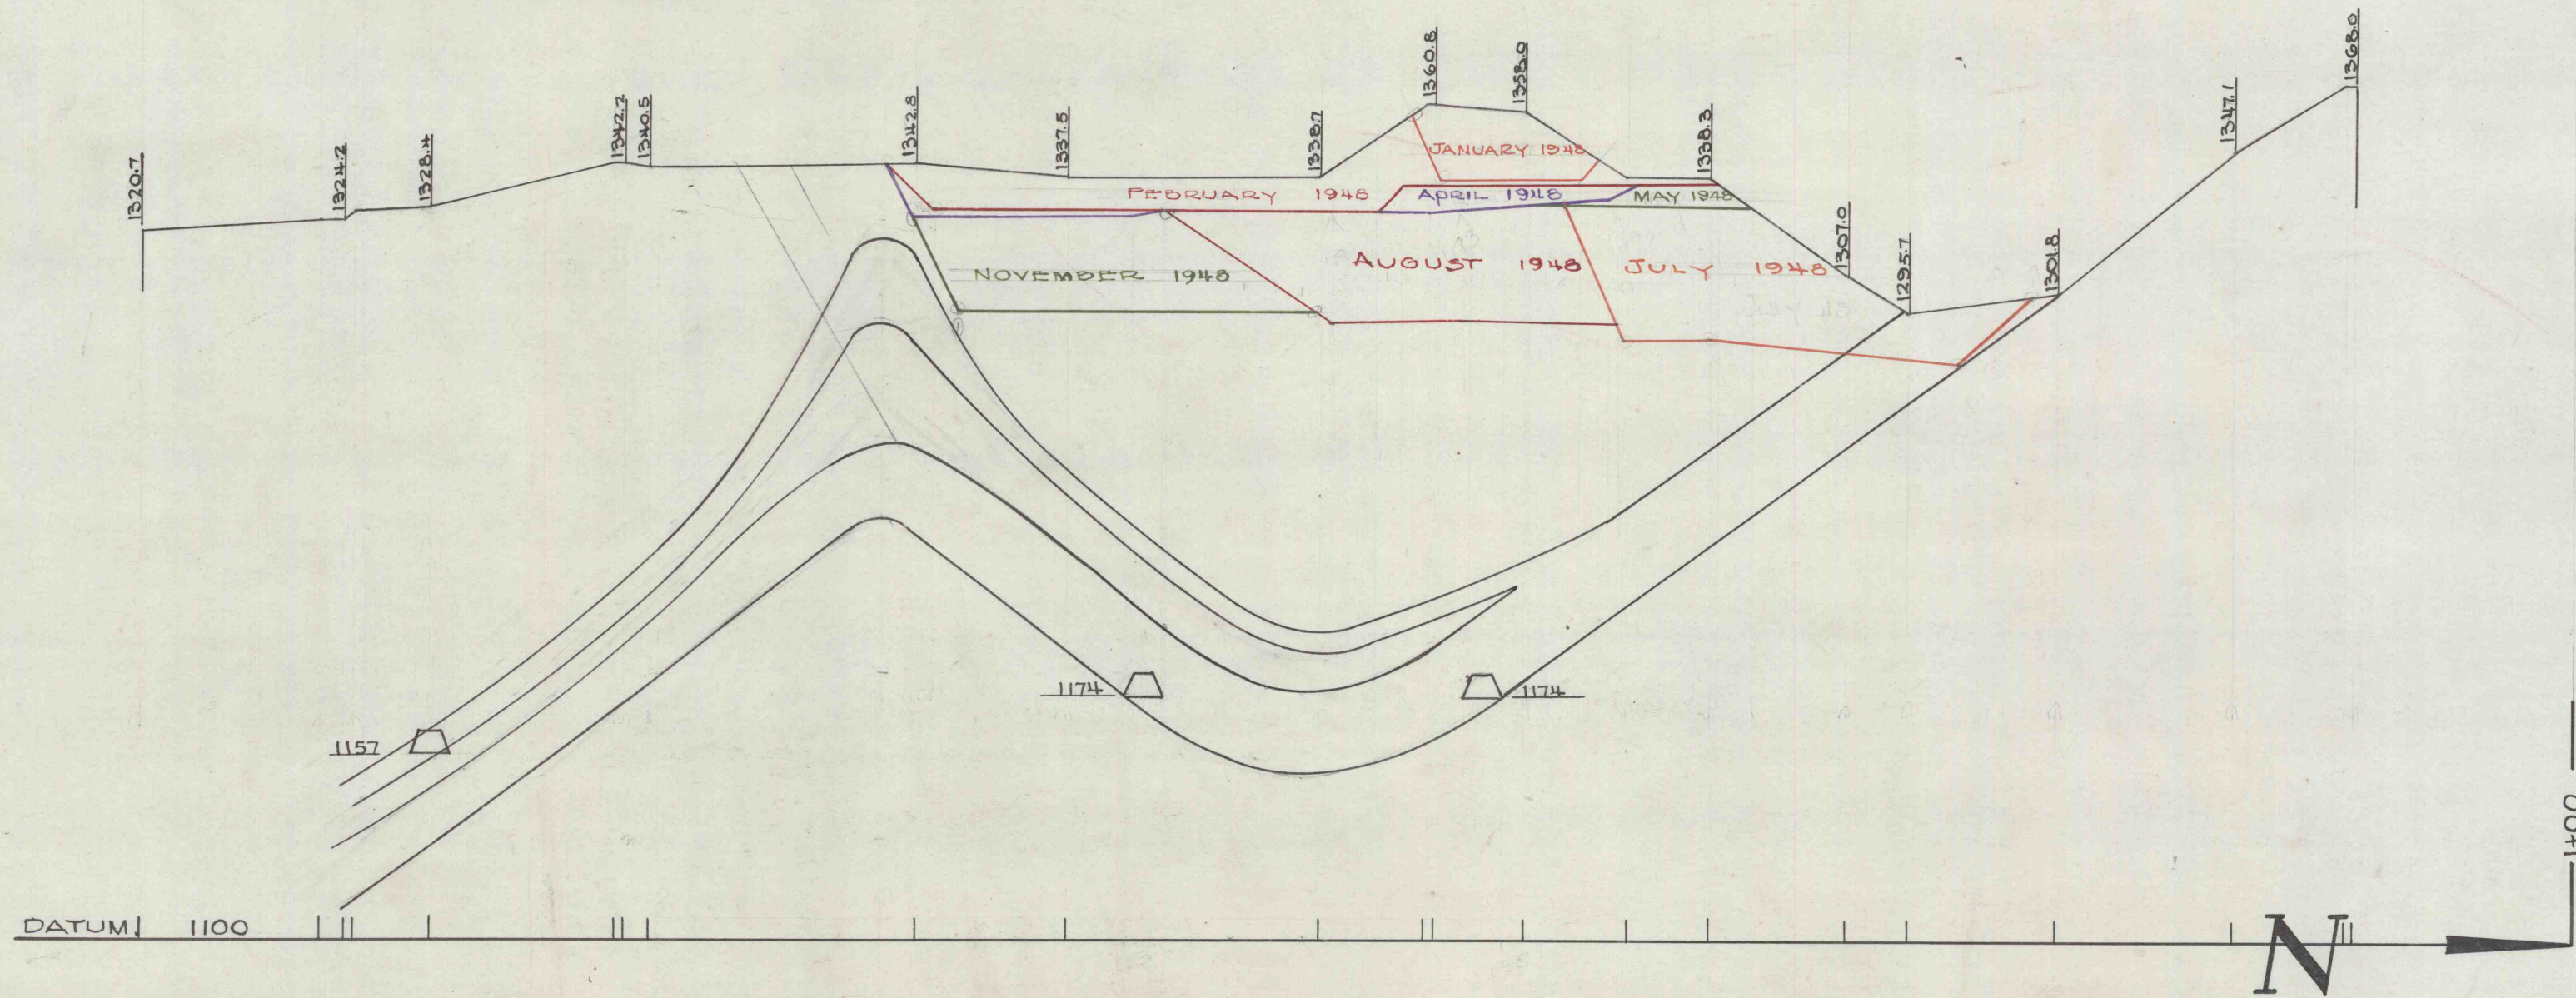

J. ROBERT BAZLEY, Inc.			
POTTSVILLE, PENNA.			
RAVEN RUN COAL CO			
#20 BYRNESVILLE MAMMOTH STRIPPING			
SECTION 12+00			
DATE	SCALE	BY	
6-19-48	1"=50'	C.W.M.	