


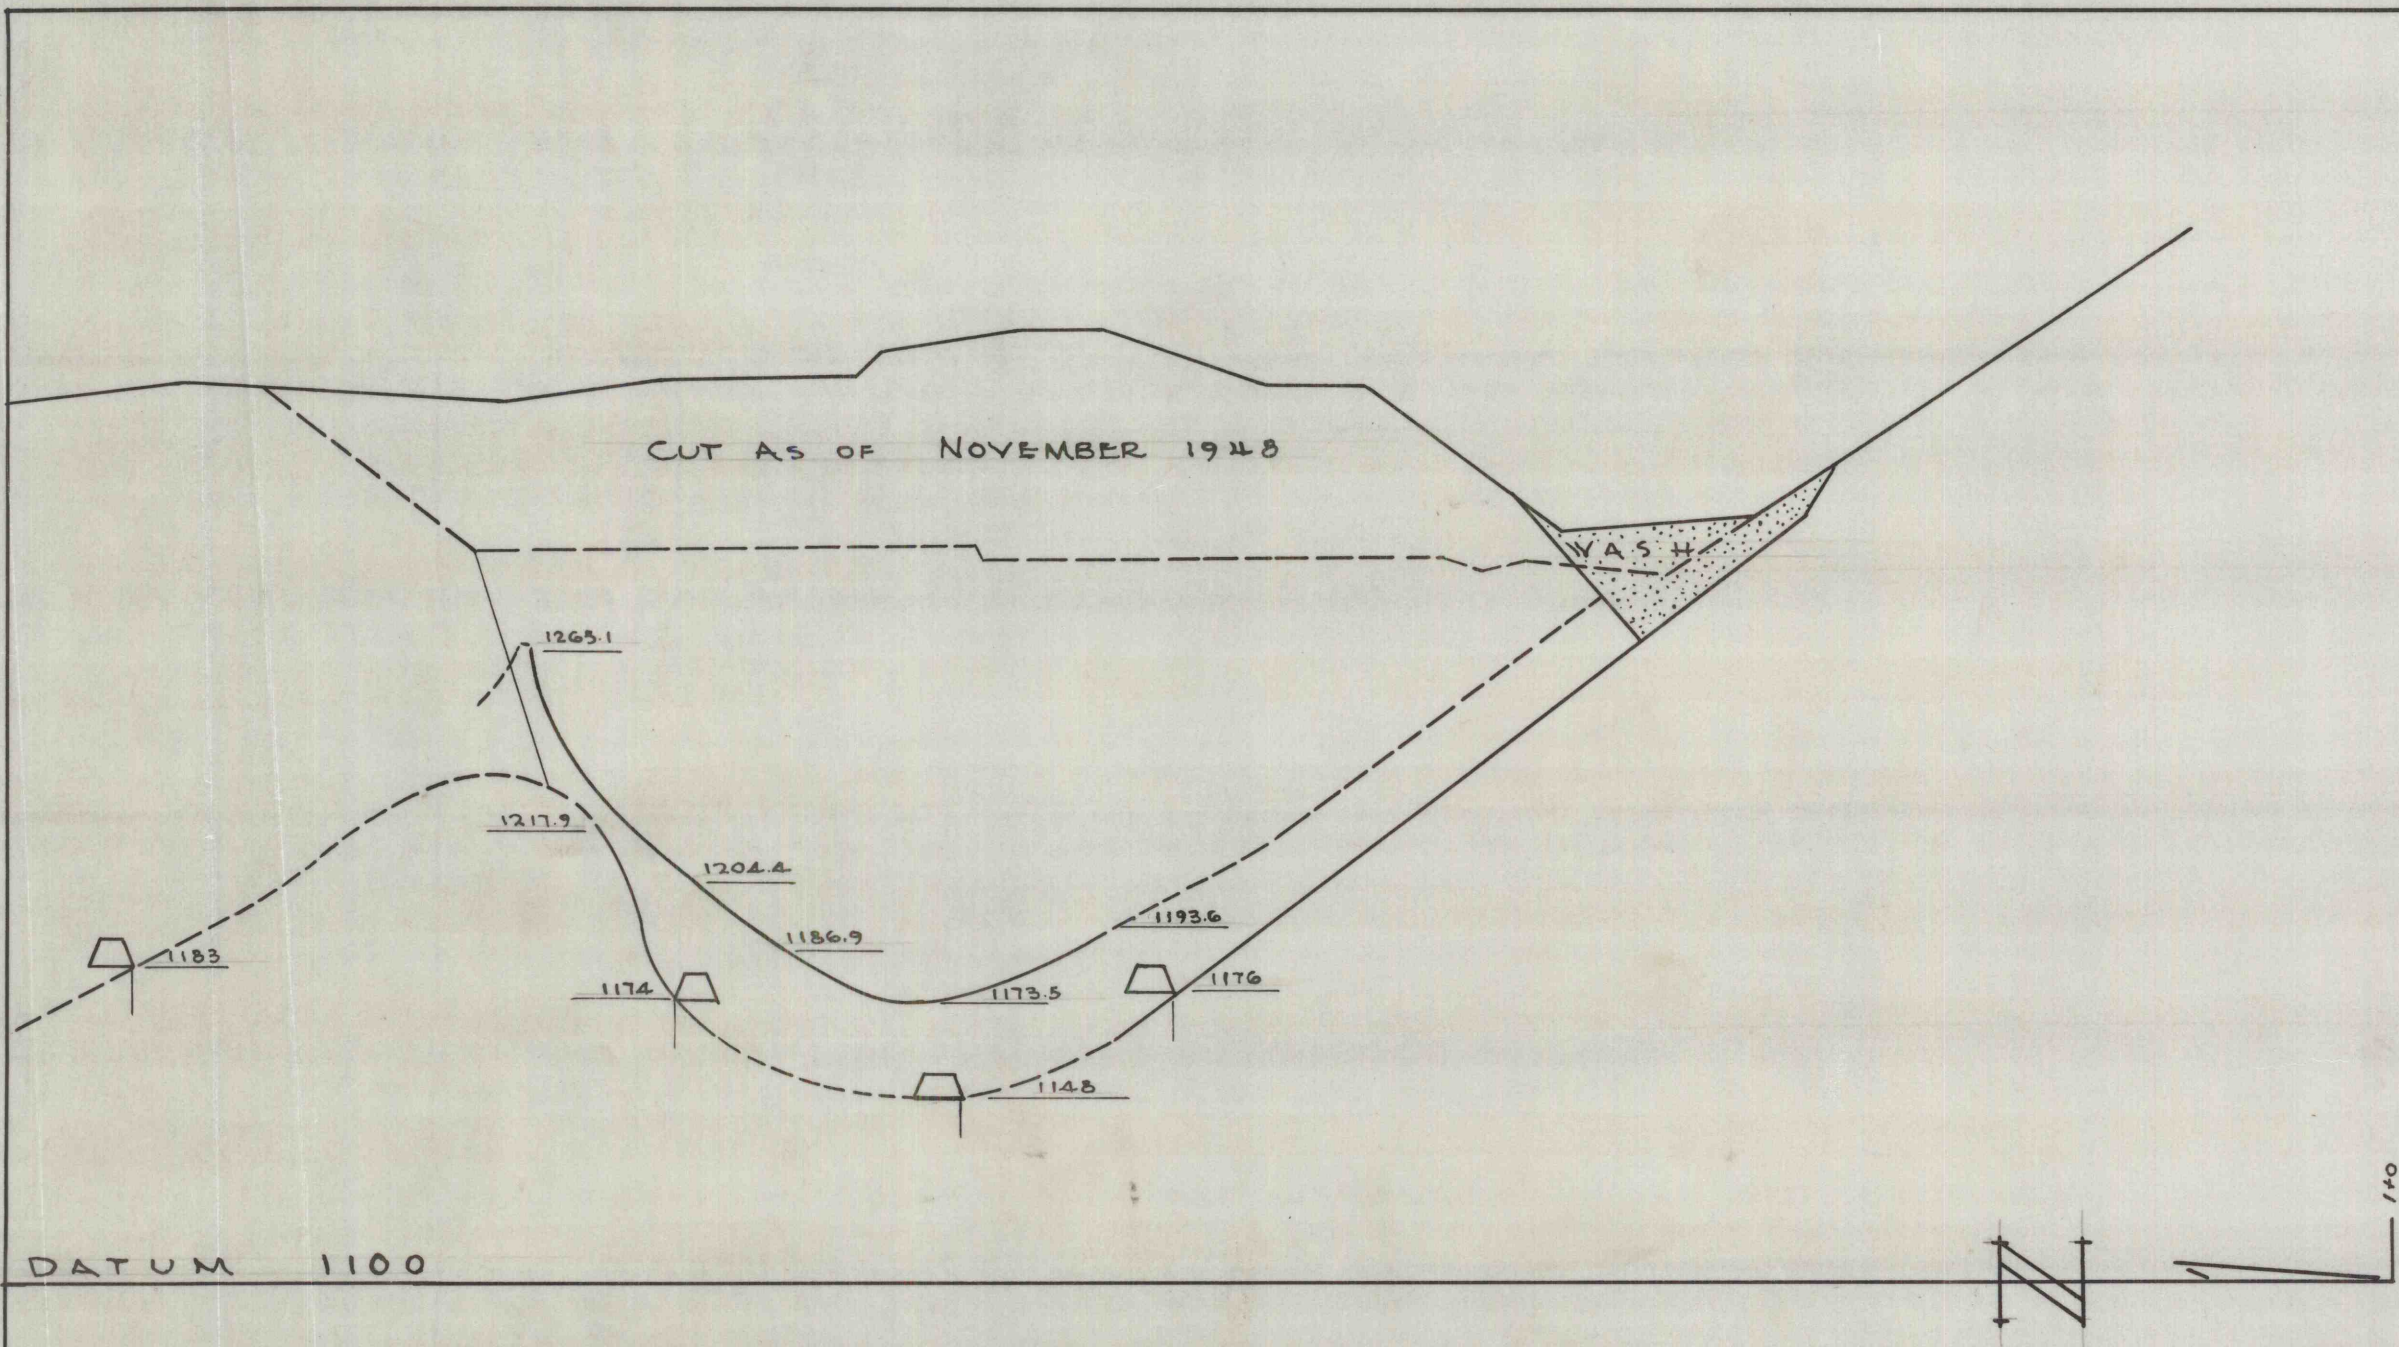

J. ROBERT BAZLEY, Inc.			
POTTSVILLE, PENNA.			
# 20 BYRNESVILLE MAMMOTH			
SECTION 10+75			
DATE	SCALE	BY	
8-14-51	1"=50'		

8 PPO MC-JAL