


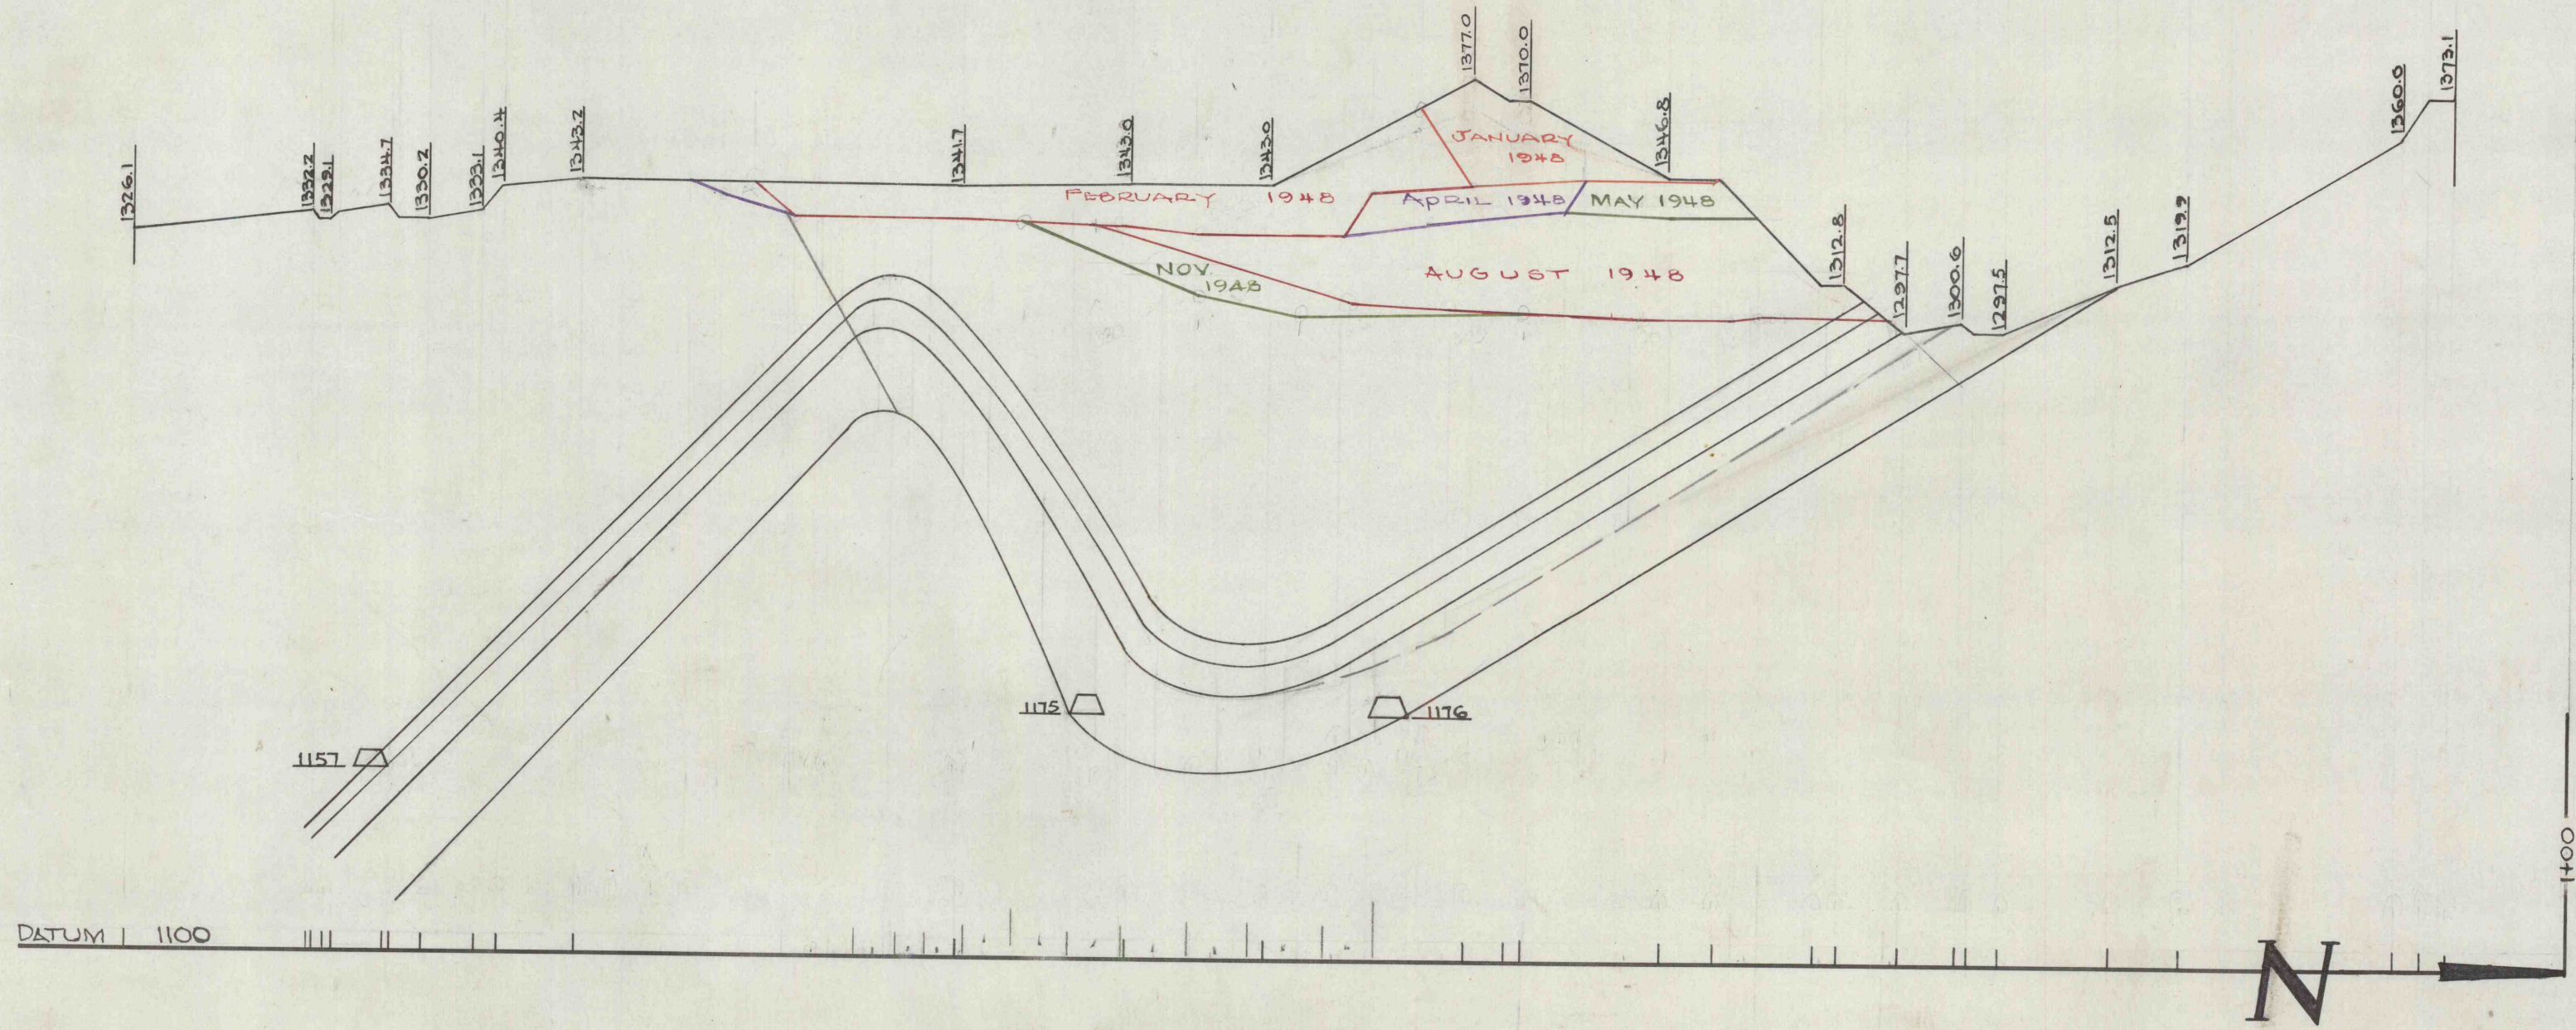

J. ROBERT BAZLEY, Inc.			
POTTSVILLE, PENNA.			
RAVEN RUN COAL CO.			
#20 BYRNESVILLE MAMMOTH STRIPPING			
SECTION 13+00			
DATE	SCALE	BY	
7-7-48	1"=50'	C.W.M.	

02PO-ME-JAT