


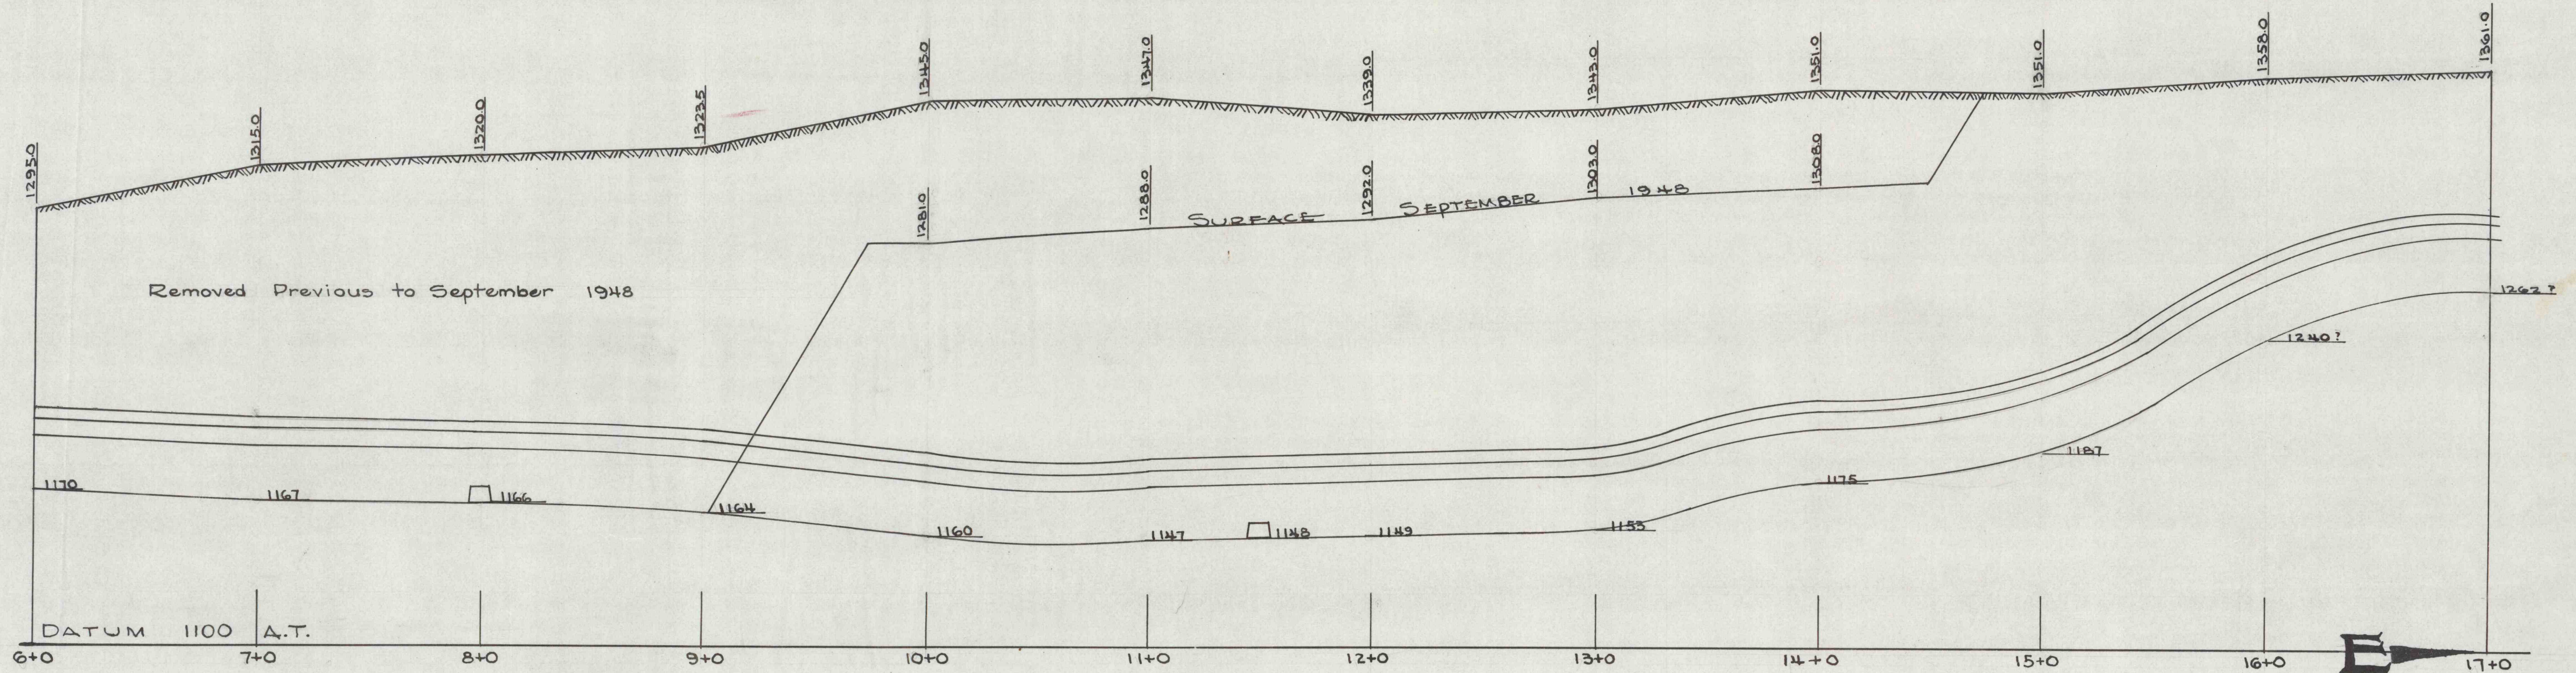

J. ROBERT BAZLEY, Inc.
 POTTSVILLE, PENNA.
 #20 BYRNESVILLE Stripping
 LONGITUDINAL SECTION
 THROUGH BASIN
 DATE 9-5-48 SCALE 1"=50' BY B-51