


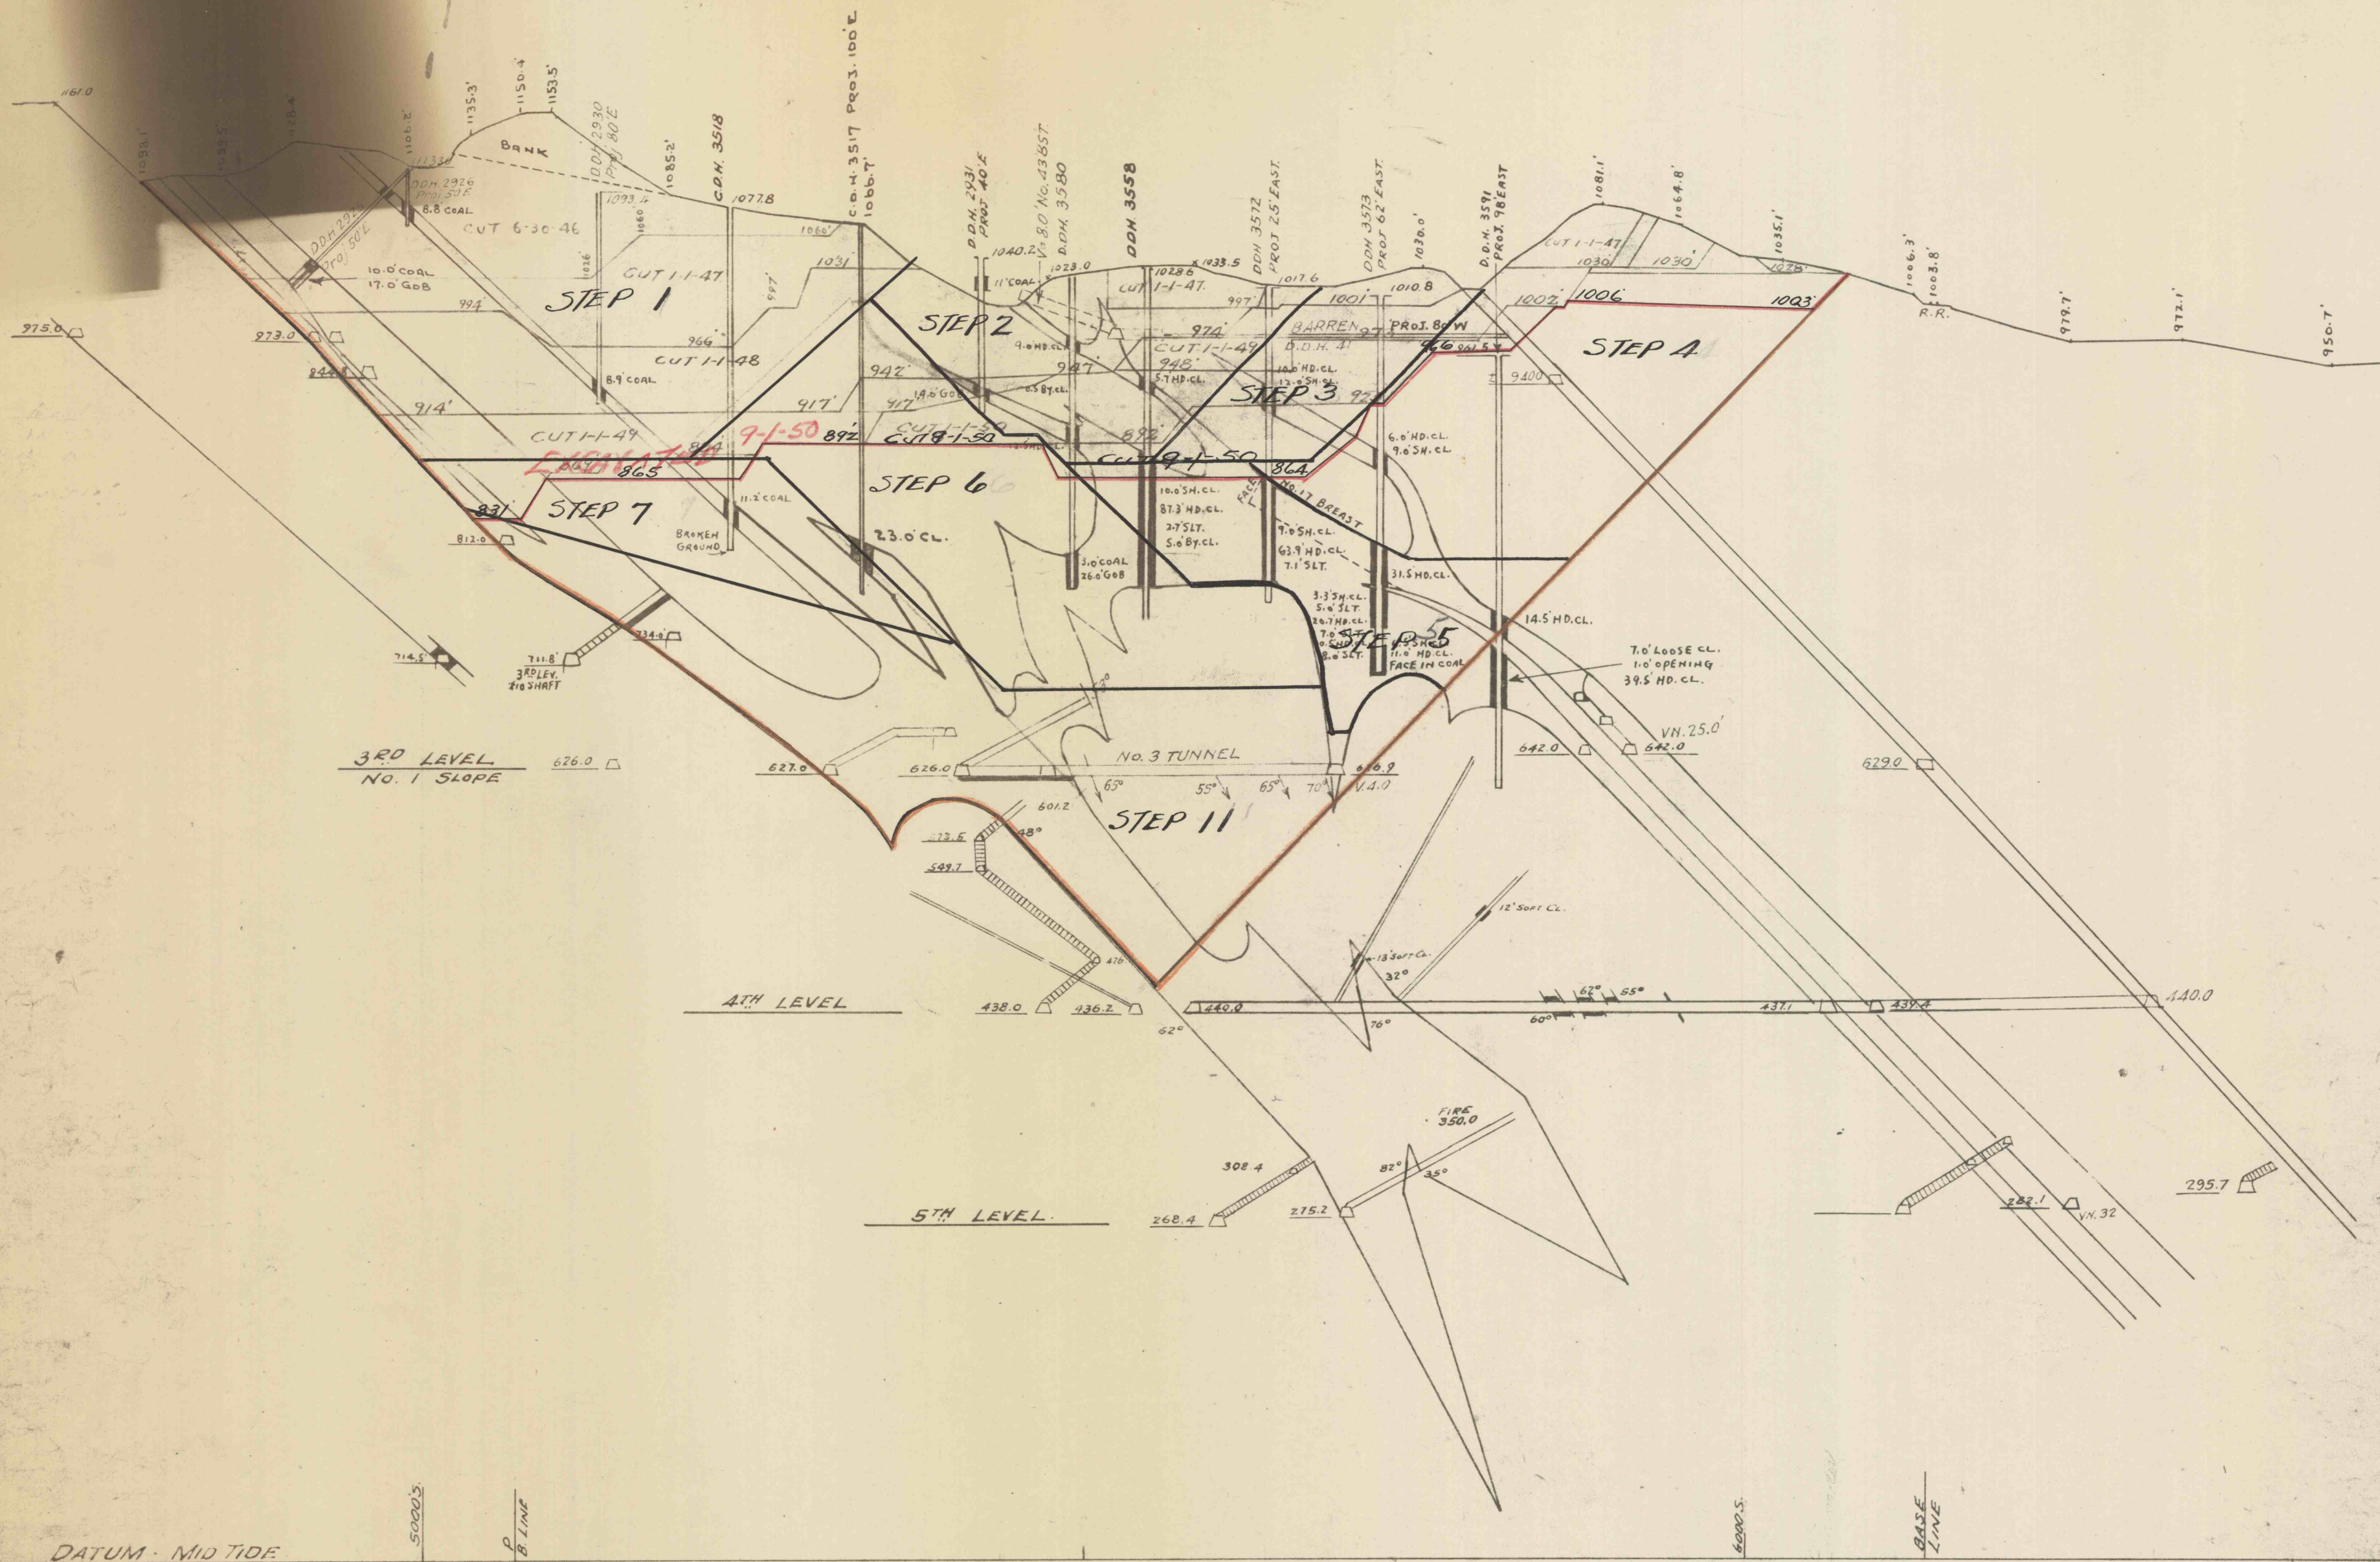

LEHIGH NAVIGATION COAL CO., INC.
LANSFORD, PENNA.
MINING ENGINEERING DEPT.

GREENWOOD COLLIERY

CROSS SECTION "M" or "O"
THROUGH FIRE AREA
SEE DWG 10-272

SCALE 1" = 100' DATE

MADE BY TRACED BY CHECKED BY

REVISED

APPROVED:

MIN. ENGR.

DIST. SGT.

V. P. & GEN. MGR.

C1064