


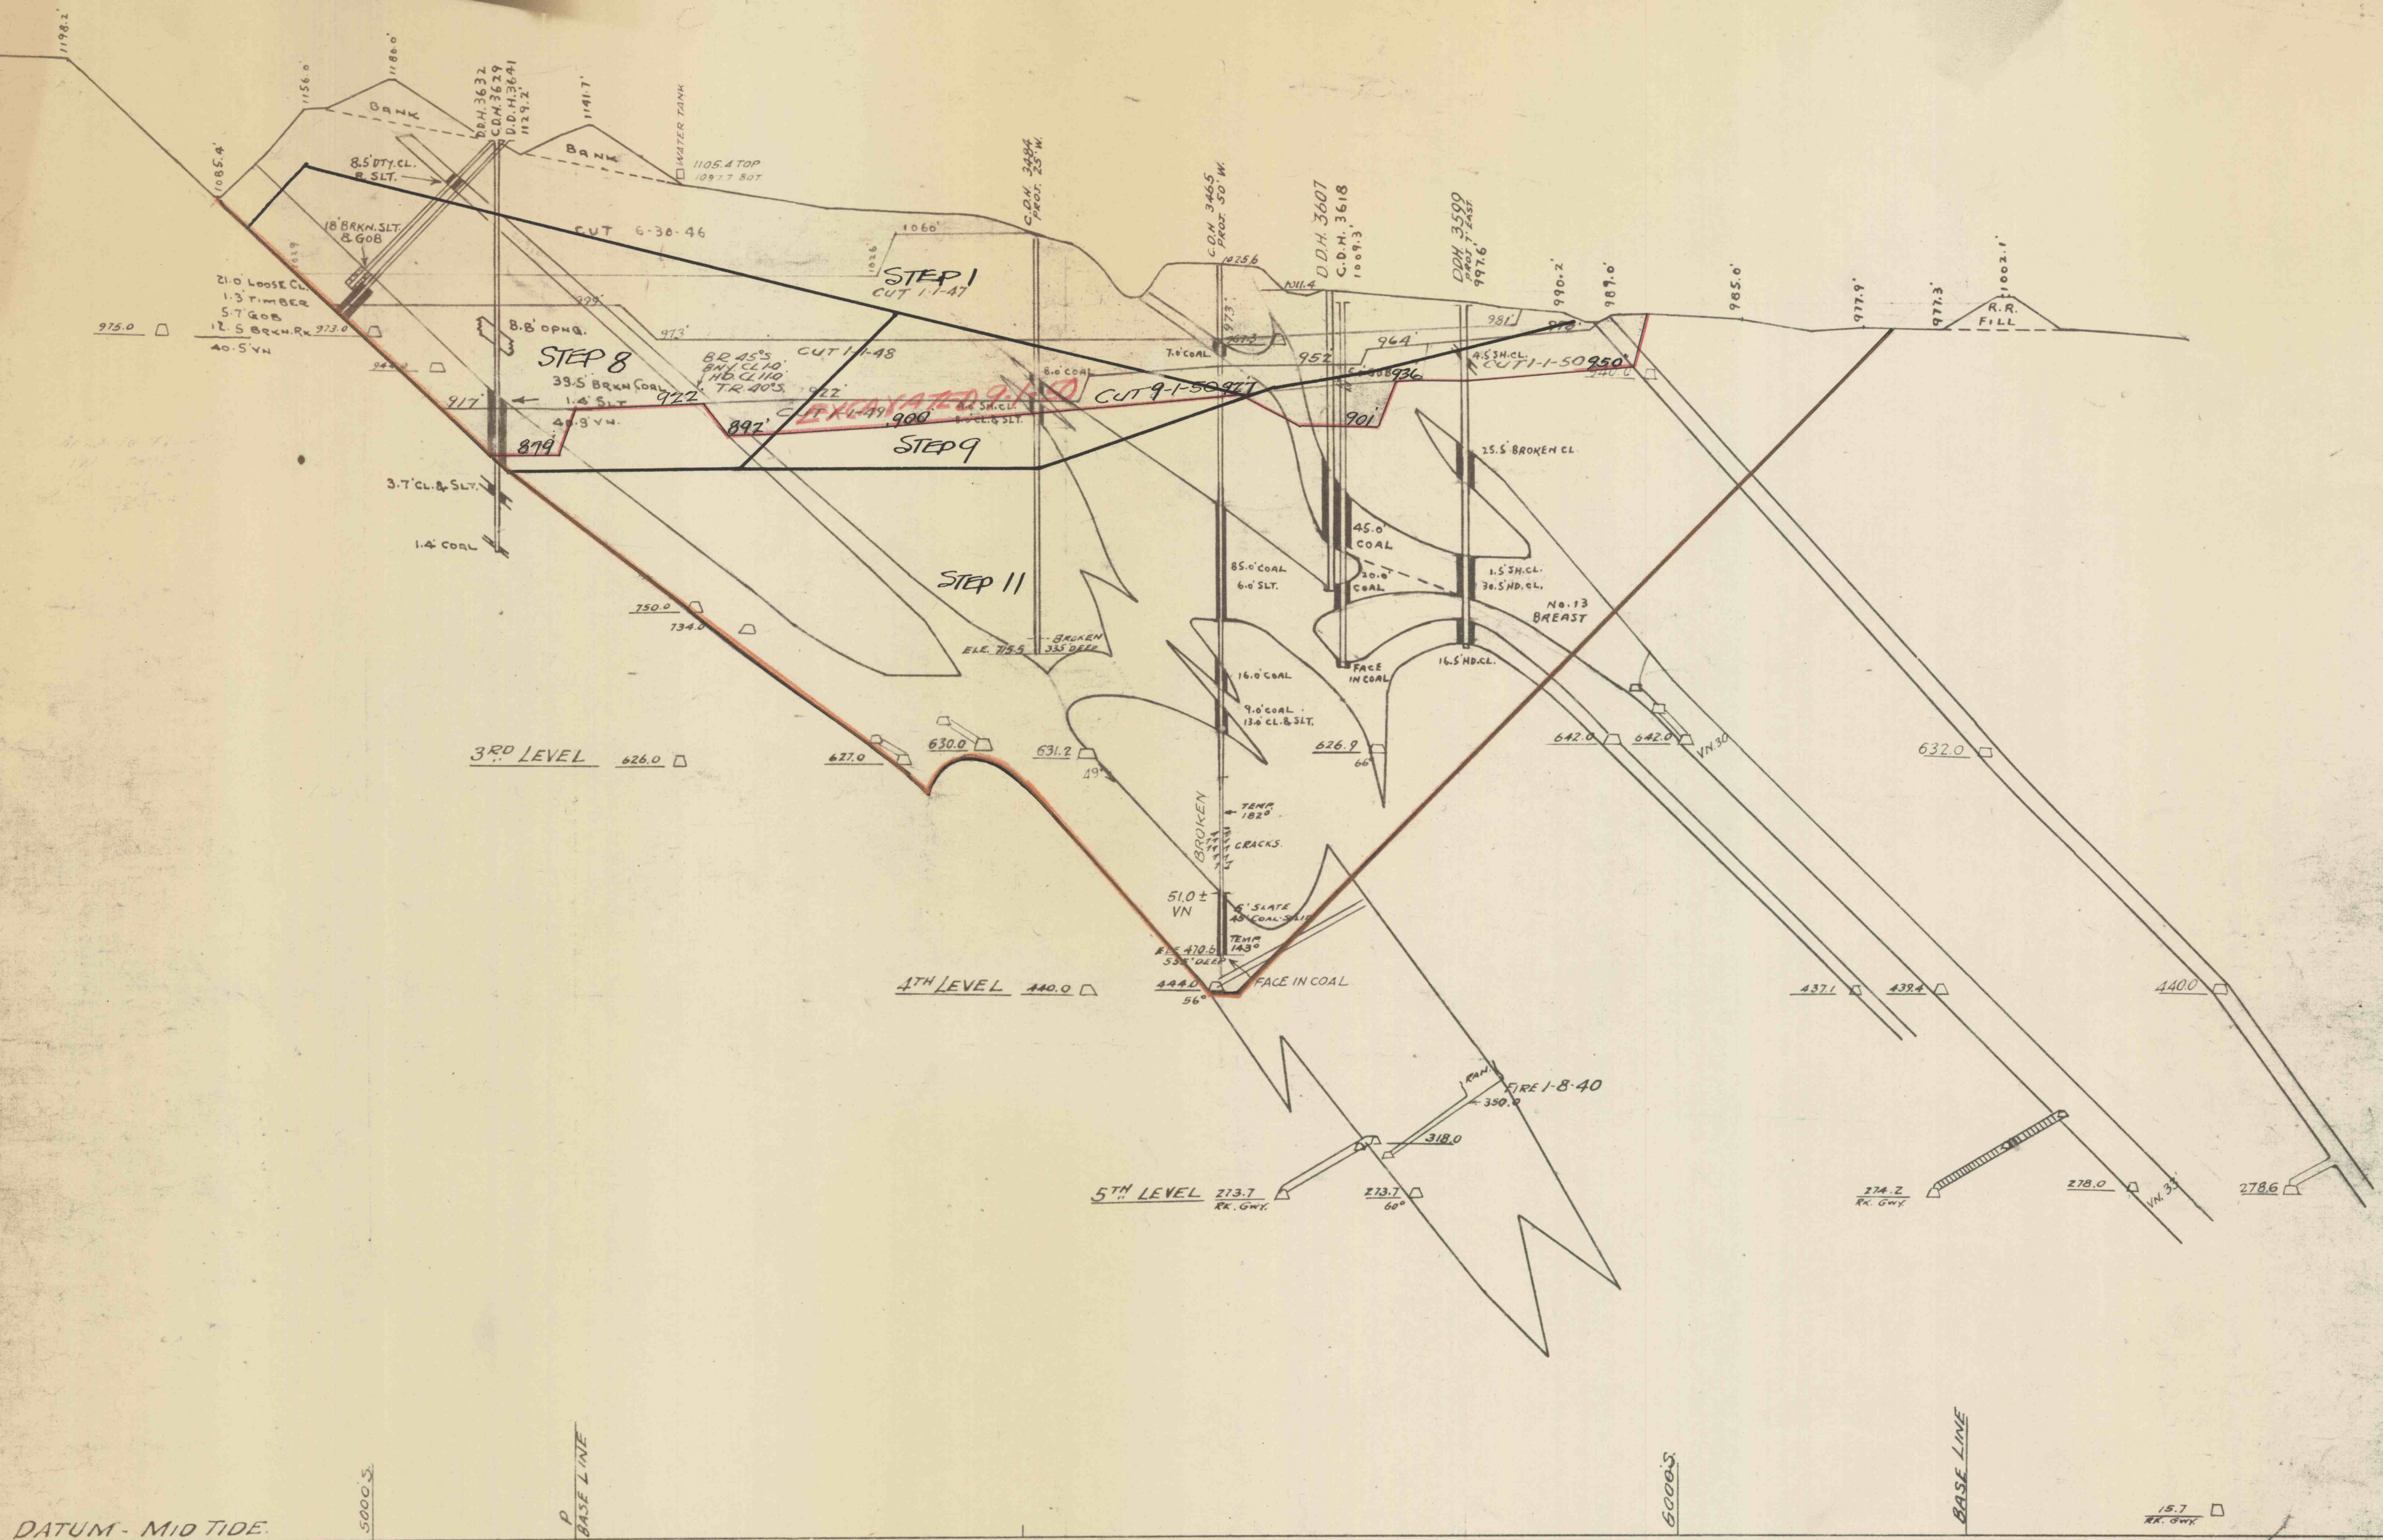

34

LEHIGH NAVIGATION COAL CO., INC.	
LANSFORD, PENNA.	
MINING ENGINEERING DEPT.	
GREENWOOD COLLIERY	
CROSS SECTION N° 2-W	
THROUGH FIRE AREA	
SEE DWG 10-272	
SCALE 1" = 100'	DATE
MADE BY	TRACED BY
REVISOR	CHECKED BY
APPROVED:	
MIN. ENGR.	
DIST. SUPT.	
V. P. & GEN. MGR.	
C1062	