


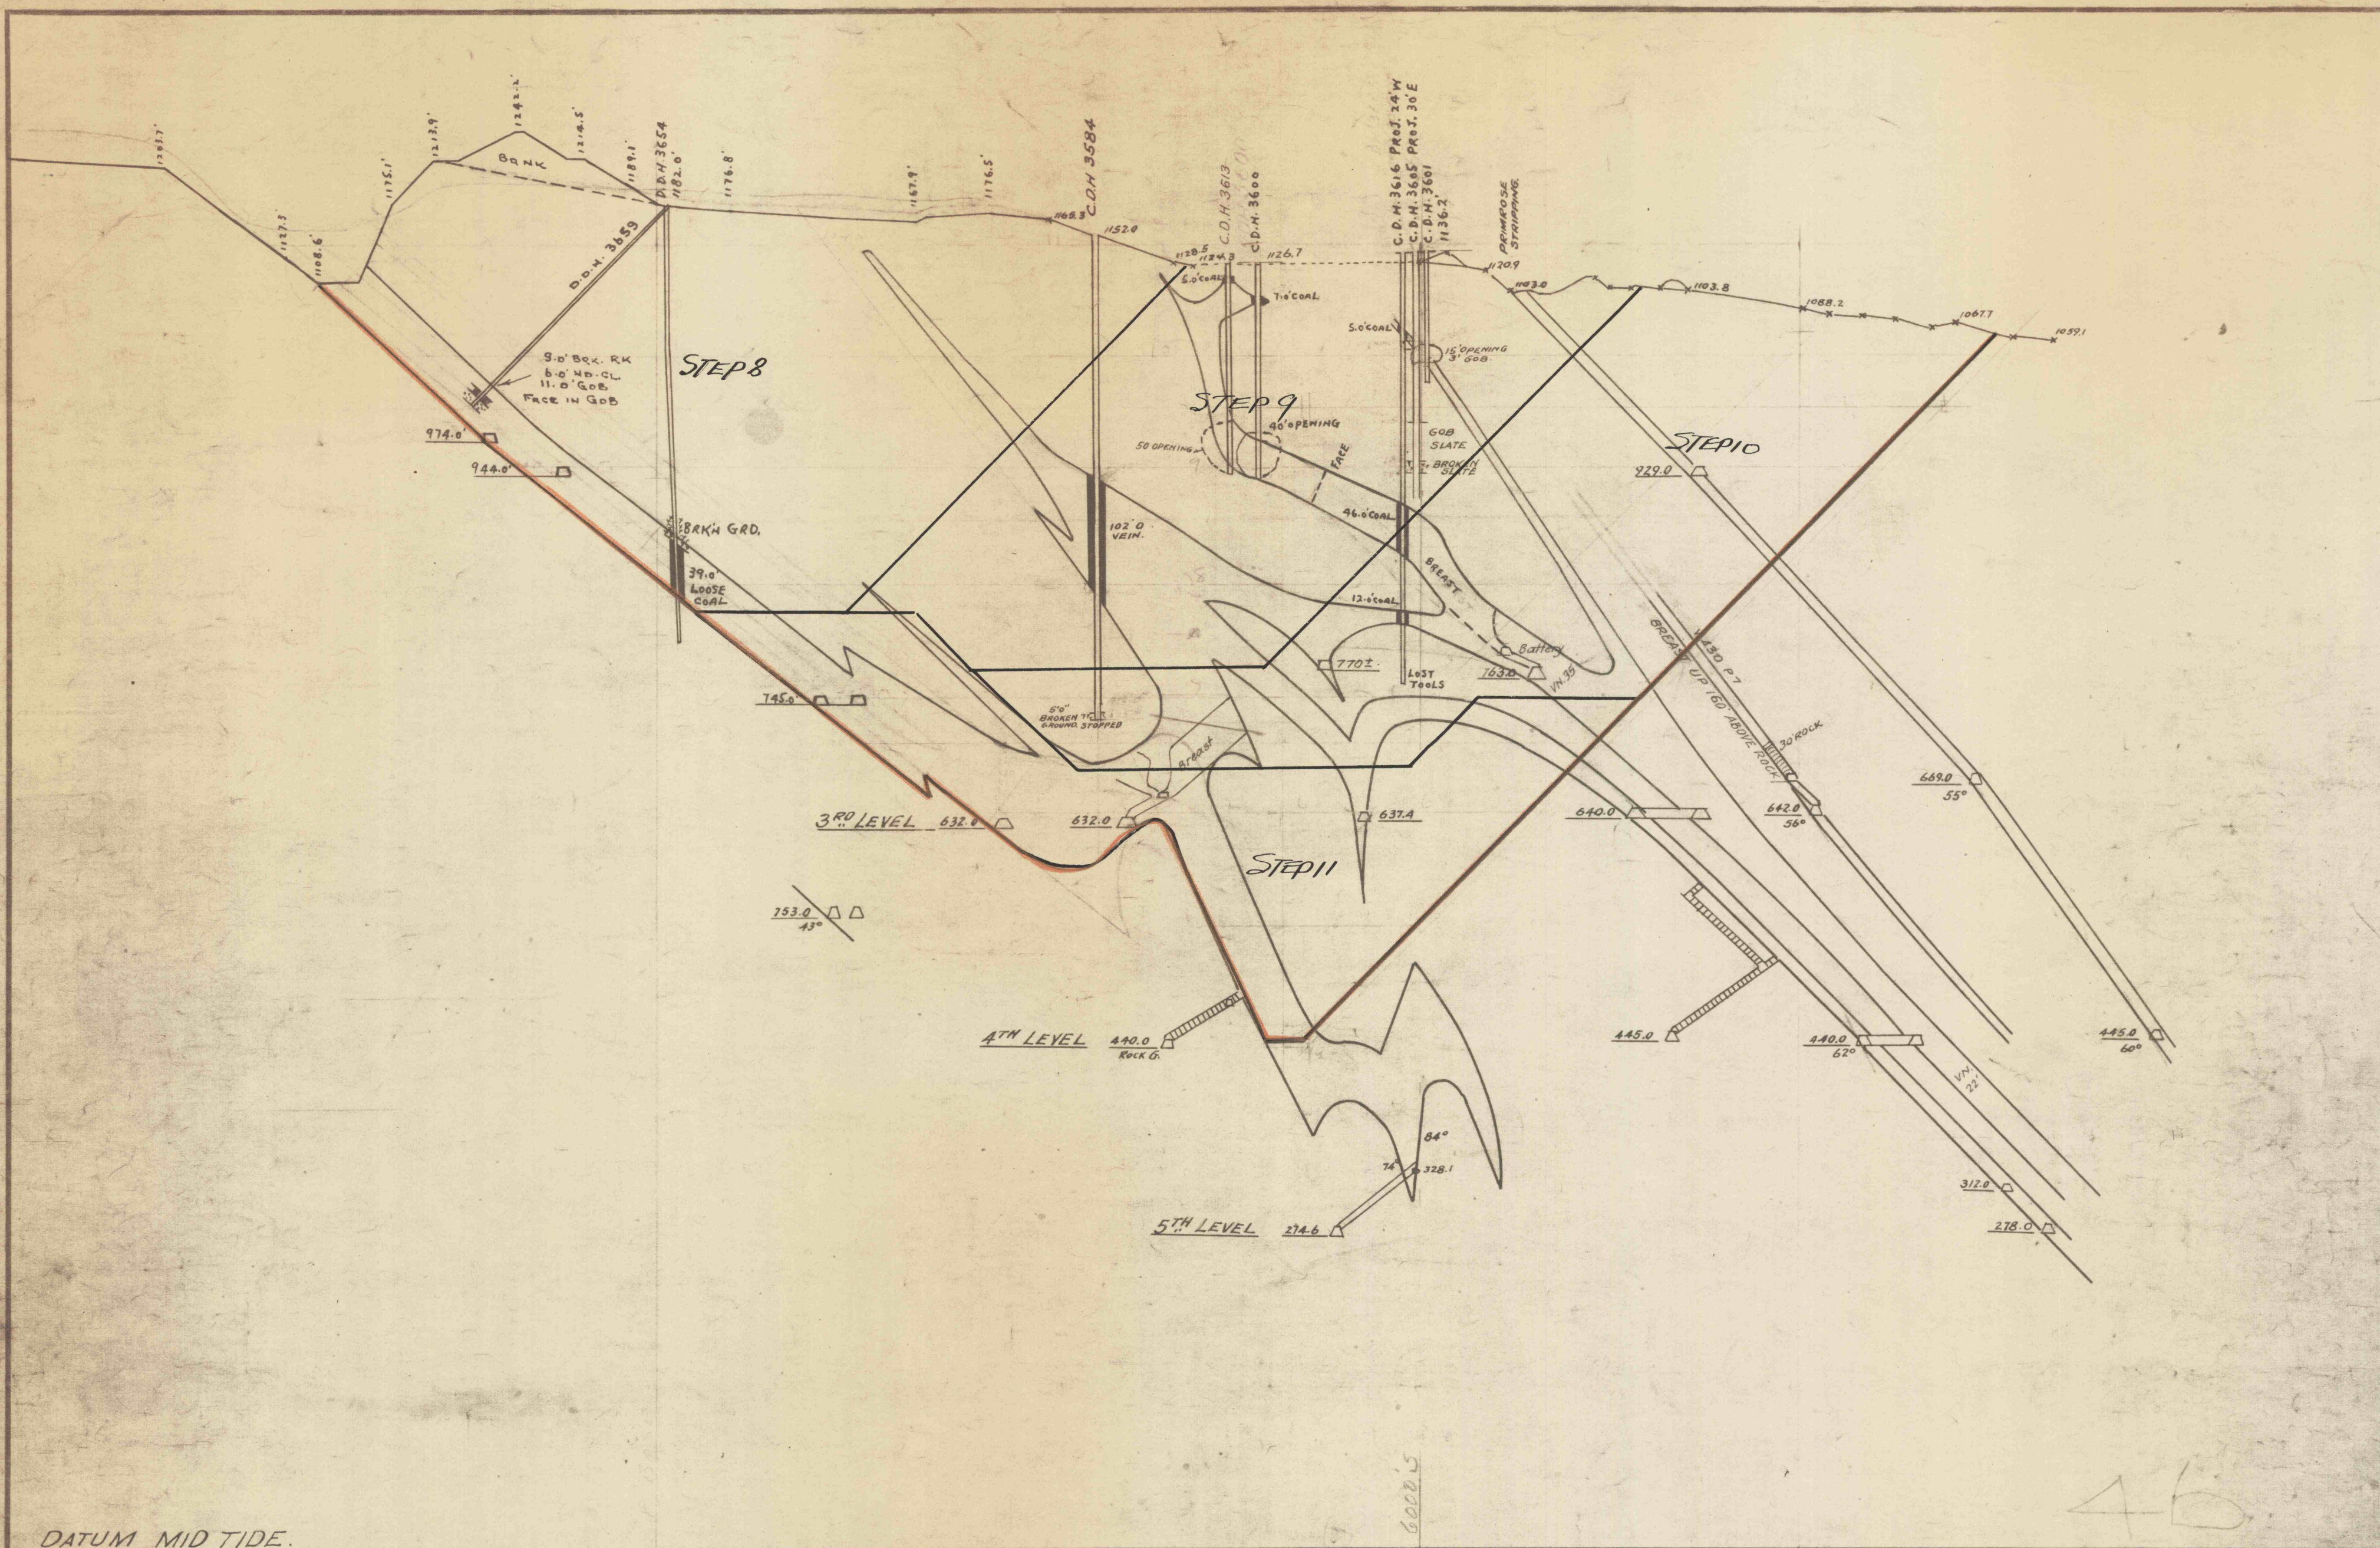

DATUM MID TIDE.

46

46

|                                  |            |
|----------------------------------|------------|
| LEHIGH NAVIGATION COAL CO., INC. |            |
| LANSFORD, PENNA.                 |            |
| MINING ENGINEERING DEPT.         |            |
| GREENWOOD COLLIERY               |            |
| CROSS SECTION 5-W                |            |
| THROUGH FIRE AREA                |            |
| SEE DWG 10-272                   |            |
| SCALE 1"=100'                    | DATE       |
| MADE BY                          | TRACED BY  |
| REVISOR                          | CHECKED BY |
| APPROVED:                        |            |
| MIN. ENGR.                       |            |
| DIST. SURT.                      |            |
| V. P. & GEN. MGR.                |            |

C1059