


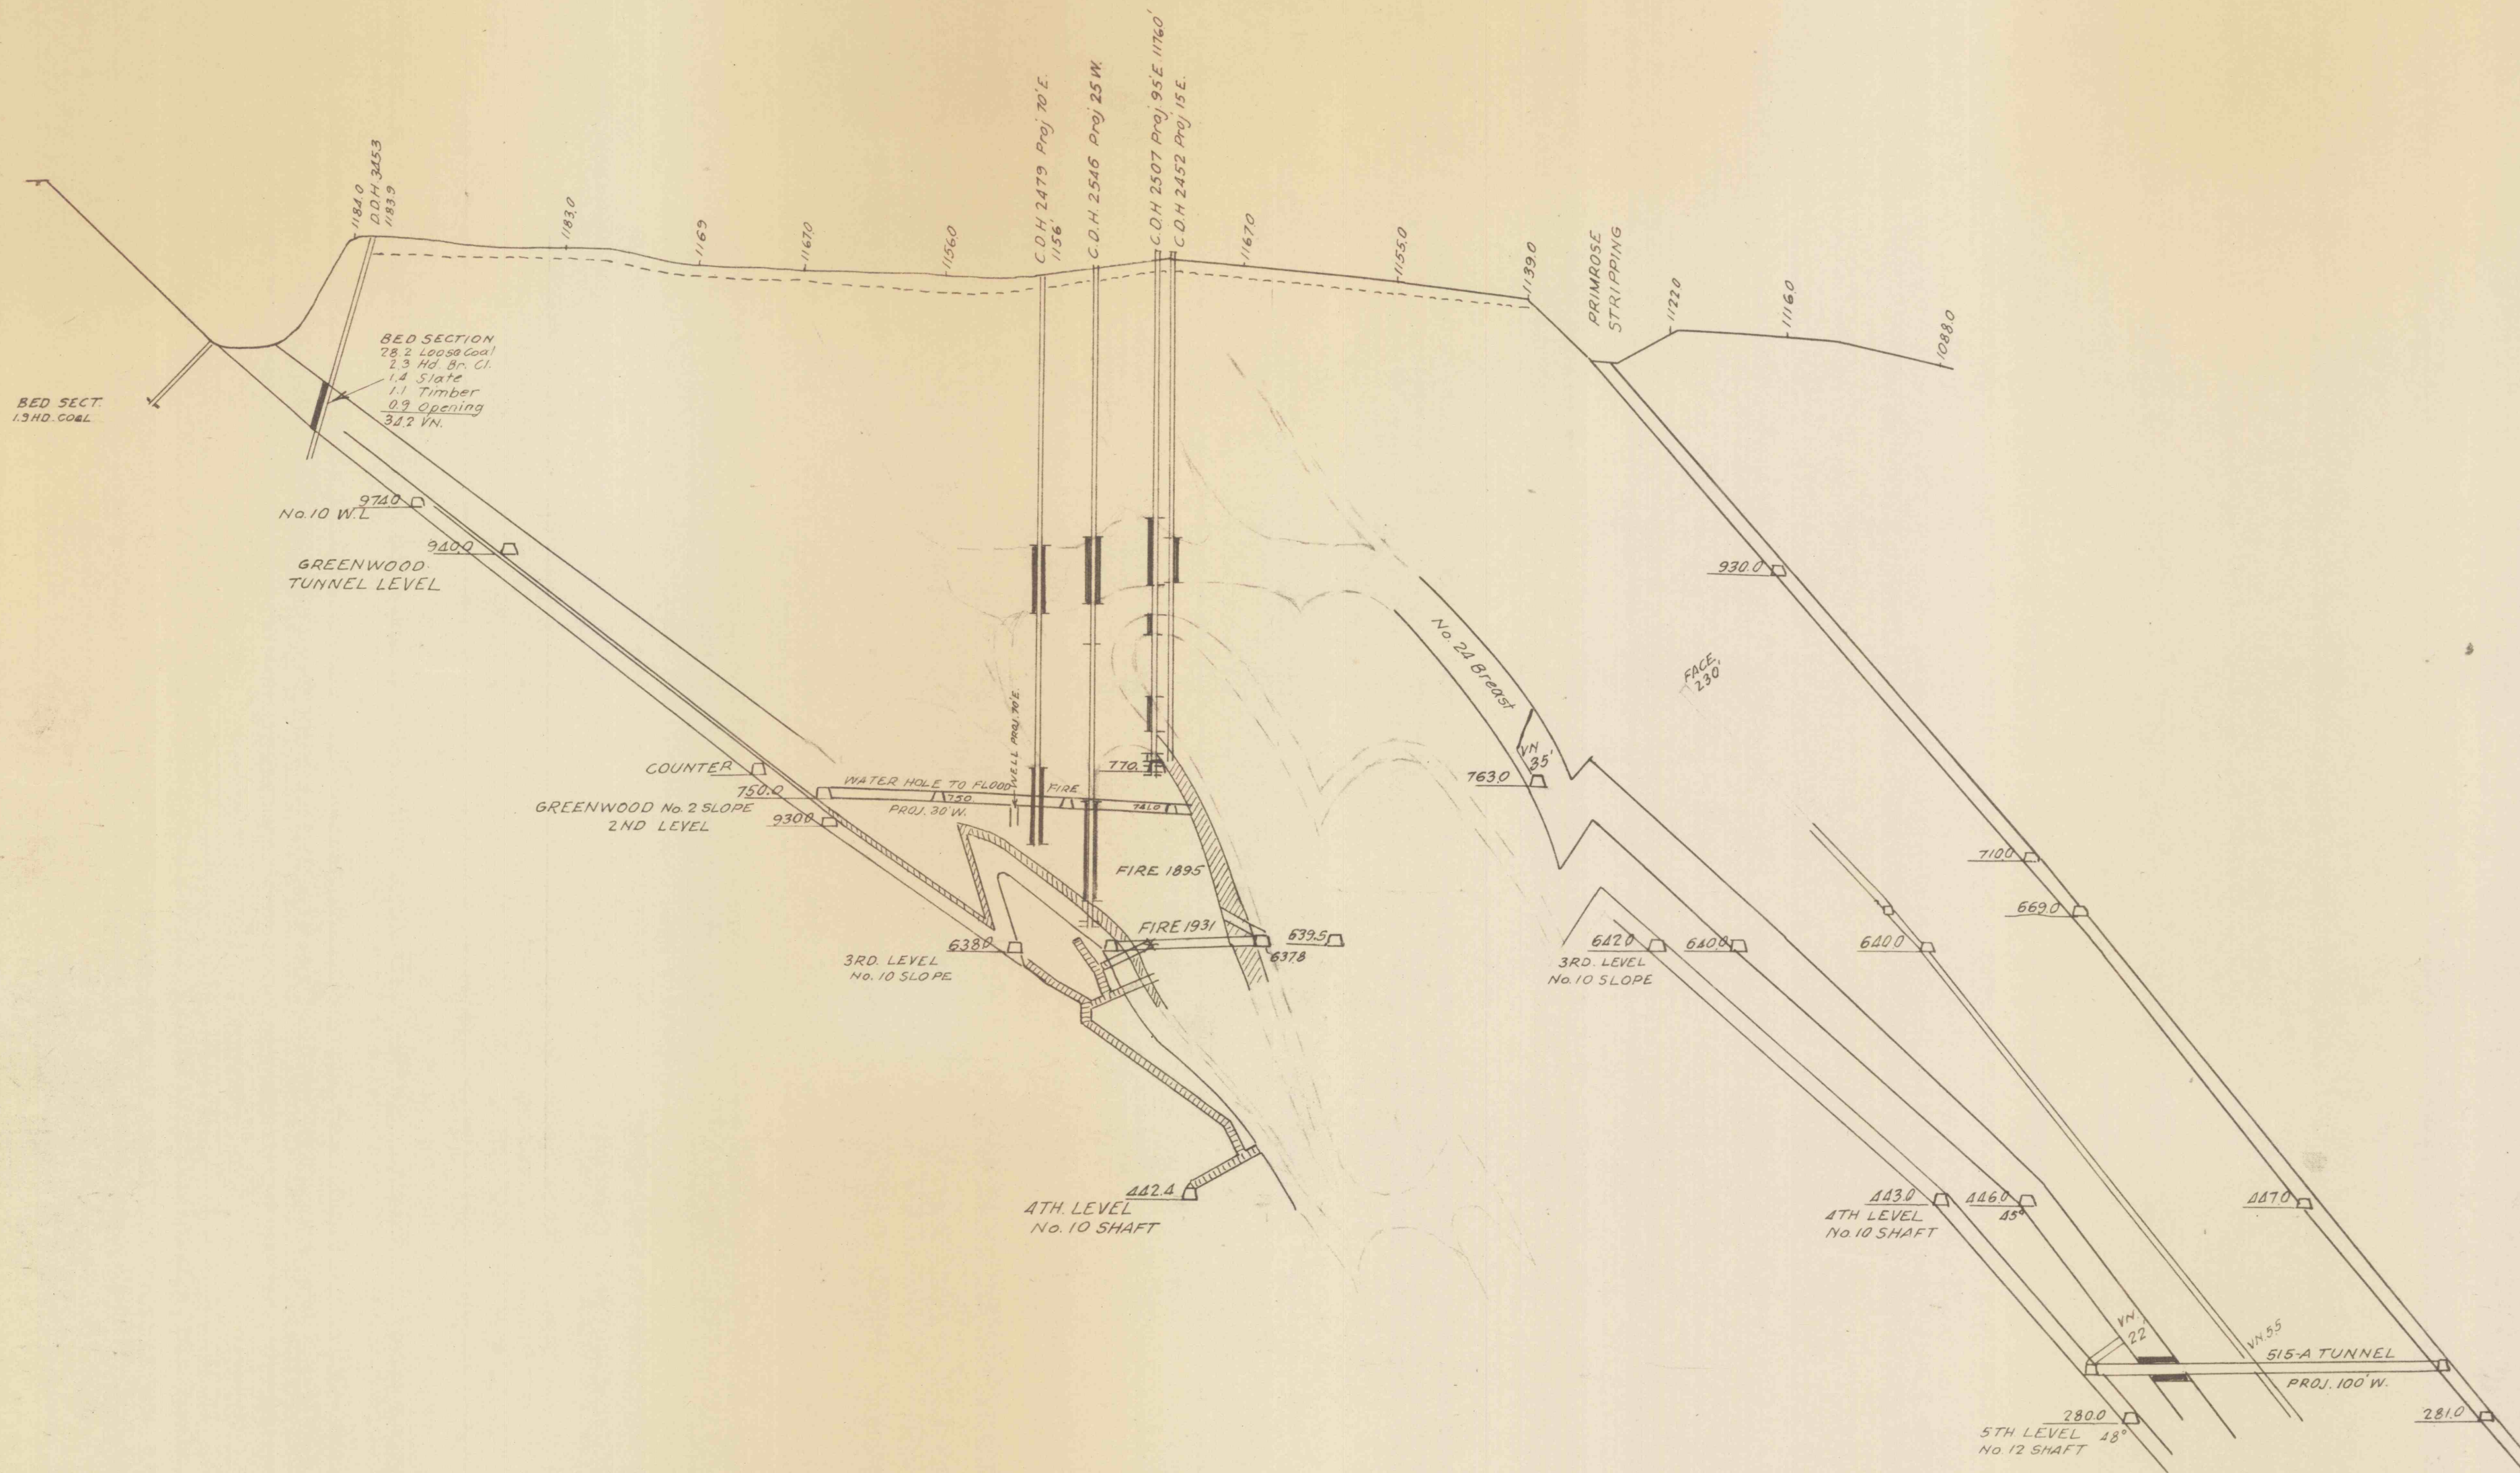

DATUM MID TIDE

|                                  |            |
|----------------------------------|------------|
| LEHIGH NAVIGATION COAL CO., INC. |            |
| LANSFORD, PENNA.                 |            |
| MINING ENGINEERING DEPT.         |            |
| COLLIERY                         |            |
| { 7W                             |            |
| CROSS SECTION { F81-A            |            |
| THROUGH FIRE AREA                |            |
| SCALE 1" = 100'                  | DATE       |
| MADE BY                          | TRACED BY  |
| REVISOR                          | CHECKED BY |
| APPROVED                         |            |
| MIN. ENGR.                       |            |
| DIST. SUPT.                      |            |
| V. P. & GEN. MGR.                |            |
| C1057                            |            |