


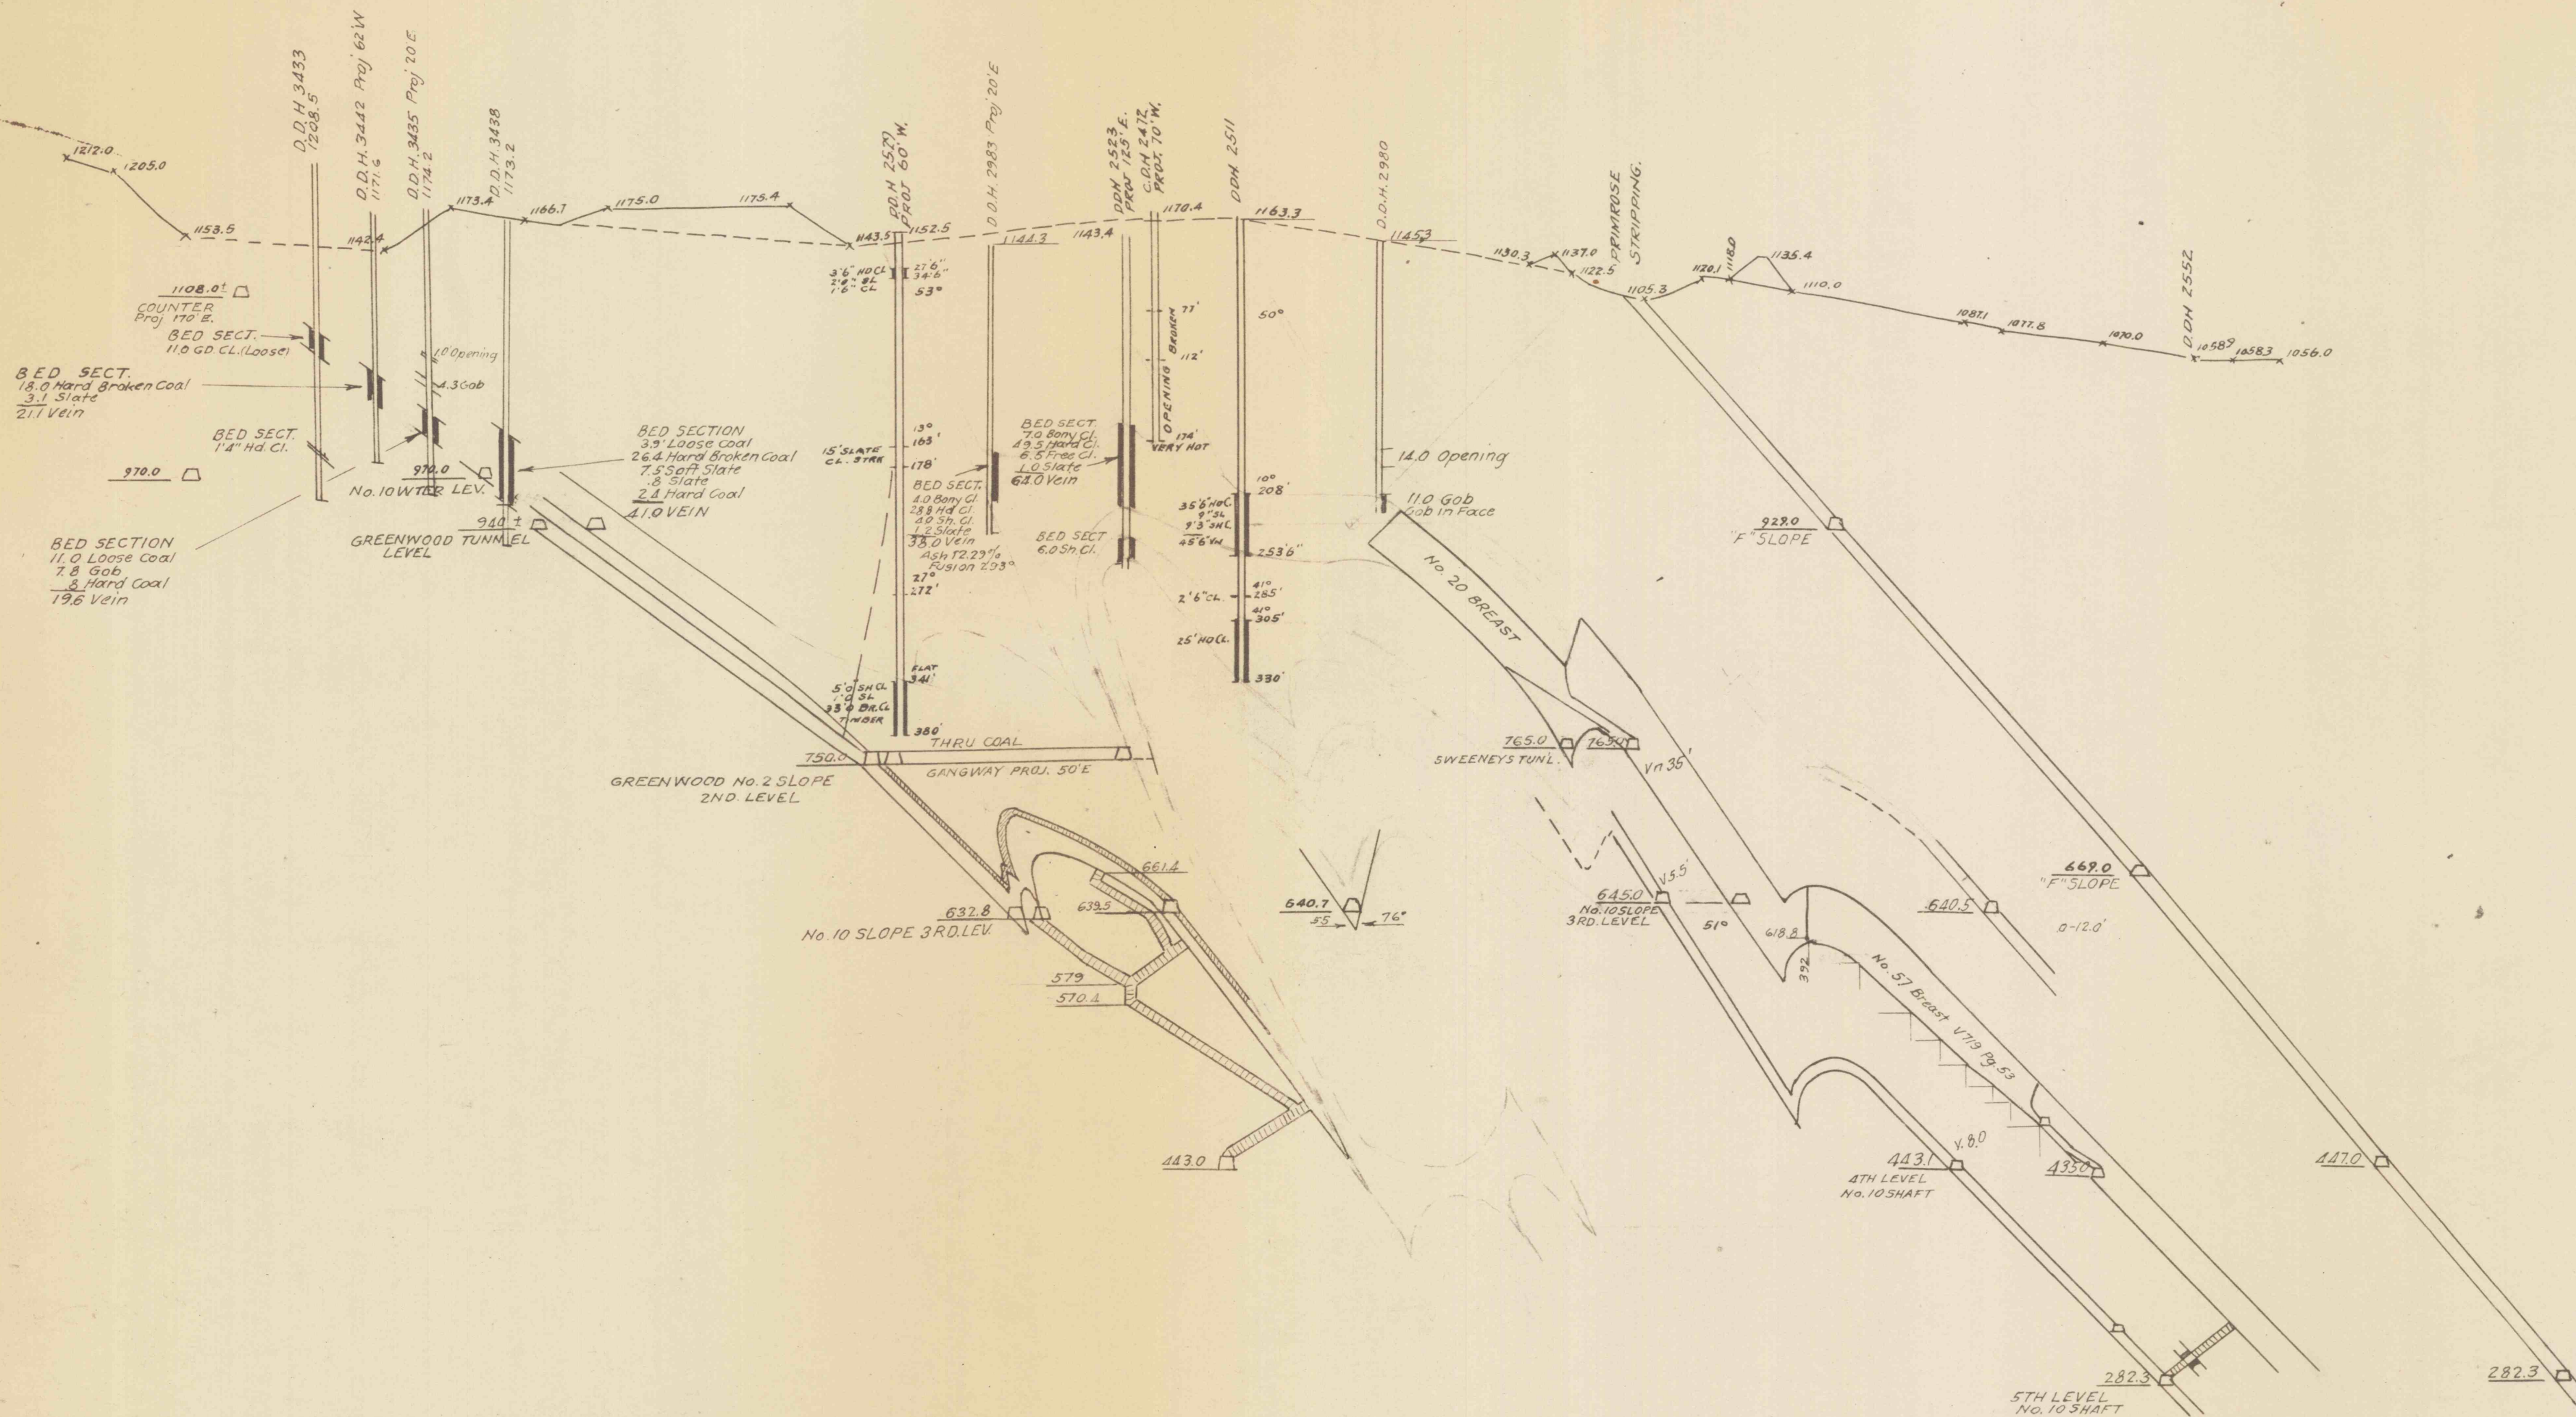

DATUM - MID TIDE.

LEHIGH NAVIGATION COAL CO., INC.
LANSFORD, PENNA.
MINING ENGINEERING DEPT.

COLLIERY
8W
CROSS SECTION F-84
THROUGH FIRE AREA

SCALE 1"=100' DATE
MADE BY TRACED BY CHECKED BY
REVISED
APPROVED:

MIN. ENGR.
DIST. SUPT.
V. P. & GEN. MGR.

C1056