


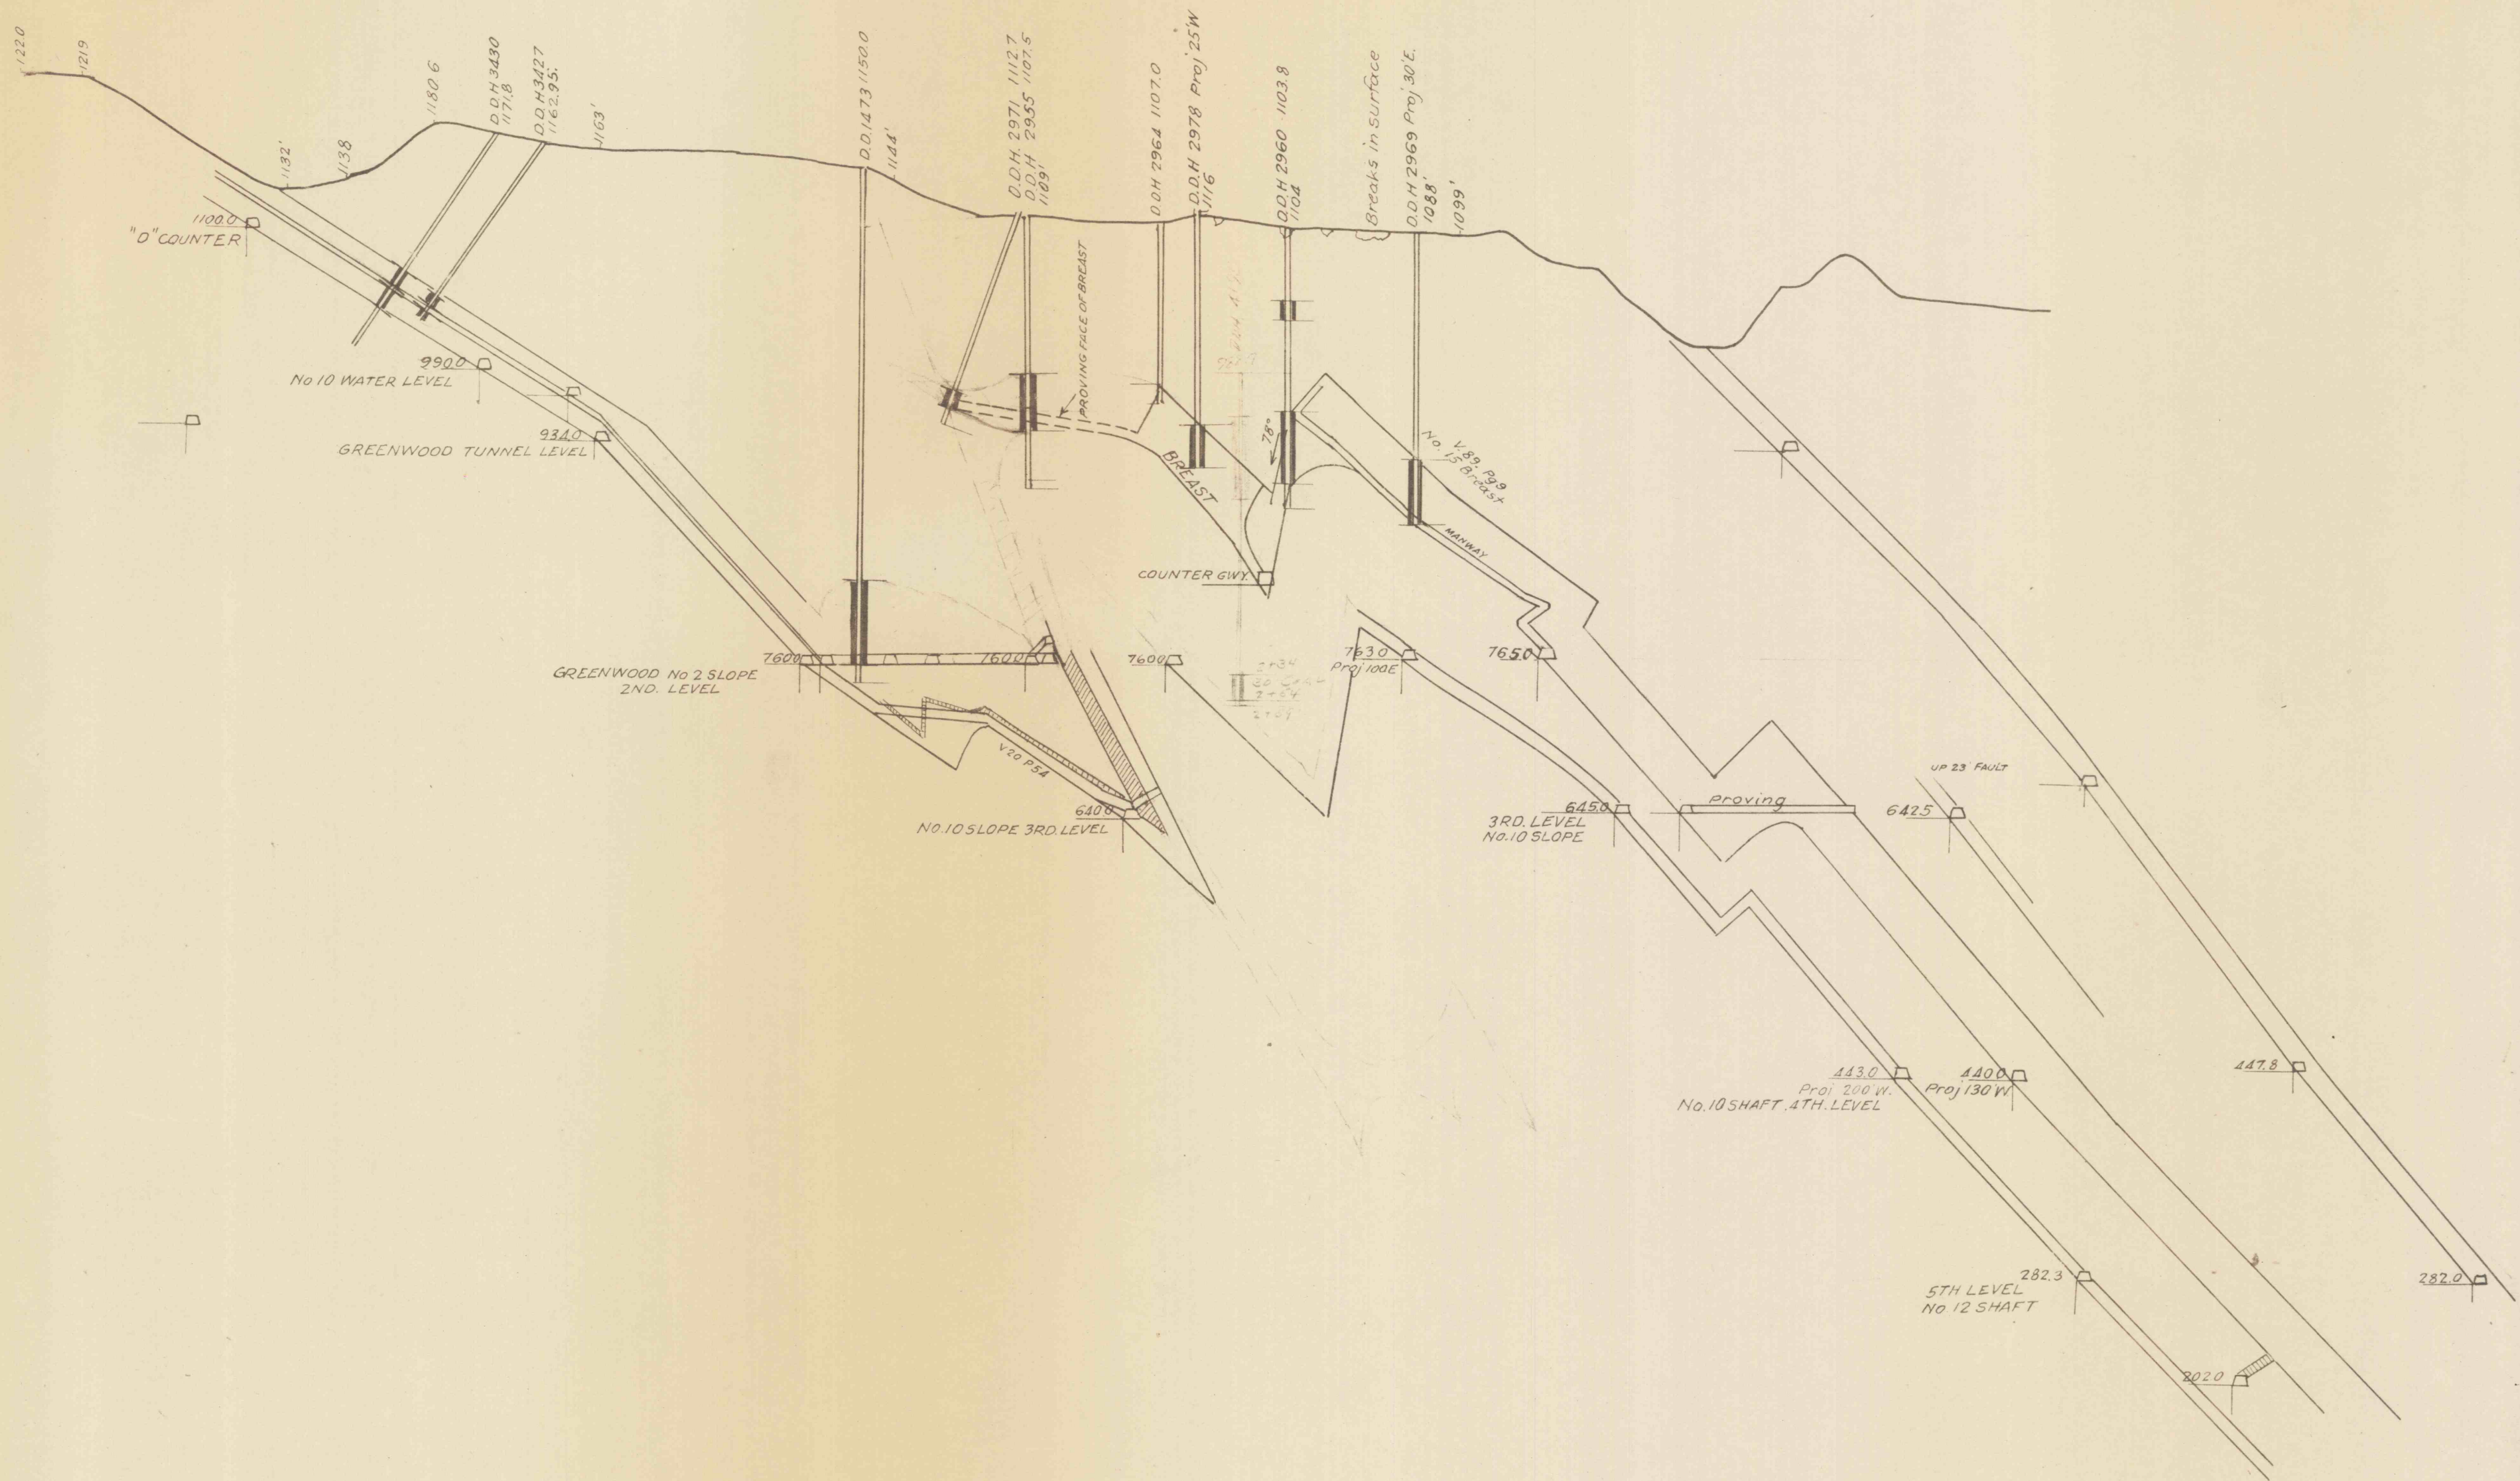

DATUM MIDTIDE

LEHIGH NAVIGATION COAL CO., INC.
LANSFORD, PENNA.
MINING ENGINEERING DEPT.

GREENWOOD COLLIERY
9-W
CROSS SECTION F-83
THROUGH FIRE AREA

SCALE 1"=100' DATE
MADE BY TRACED BY CHECKED BY
REVISED
APPROVED
MIN. ENGR.
DIST. SUPT.
V. P. & GEN. MGR.

C 1055