


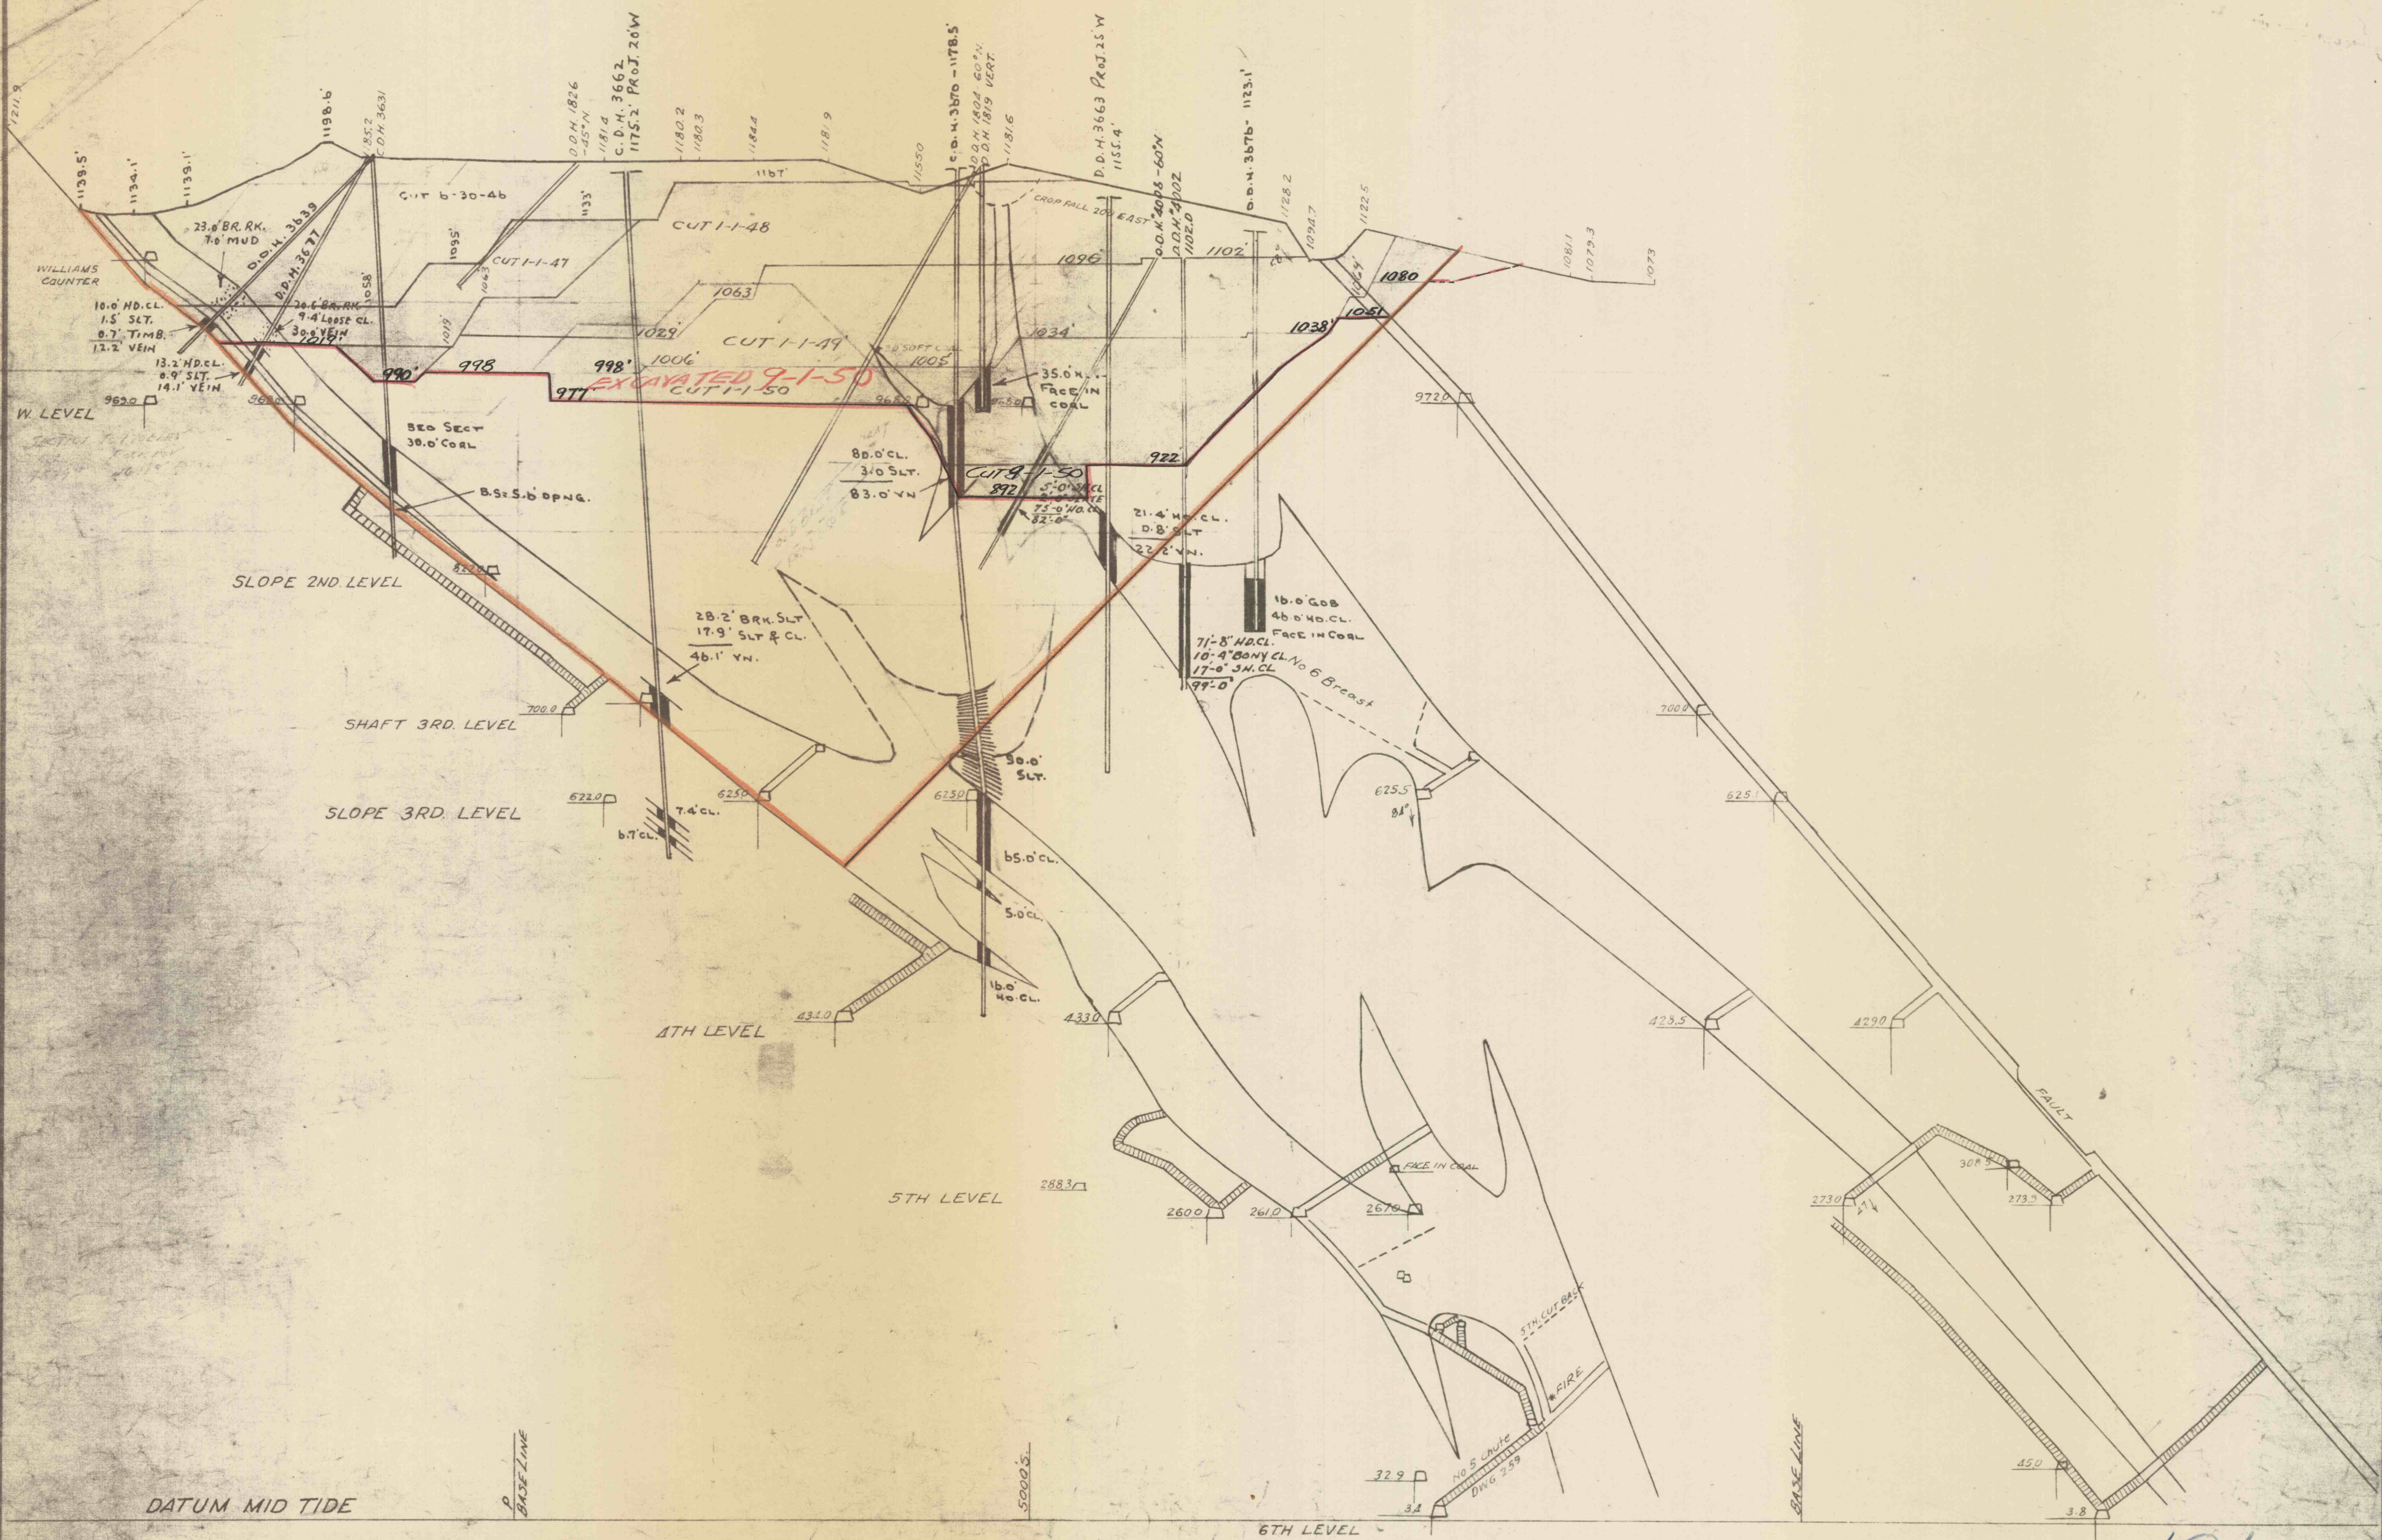

LEHIGH NAVIGATION COAL CO., INC.
LANSFORD, PENNA.
MINING ENGINEERING DEPT.

GREENWOOD COLLIERY

CROSS SECTION 7.E
THROUGH FIRE AREA

SCALE $1" = 100'$ DATE

MADE BY TRACED BY CHECKED BY

REVISÉ.....

APPROVED:

.....MIN. ENGR.

DIST. SUPT.

V. P. & GEN. M'G'R.

C 1070