


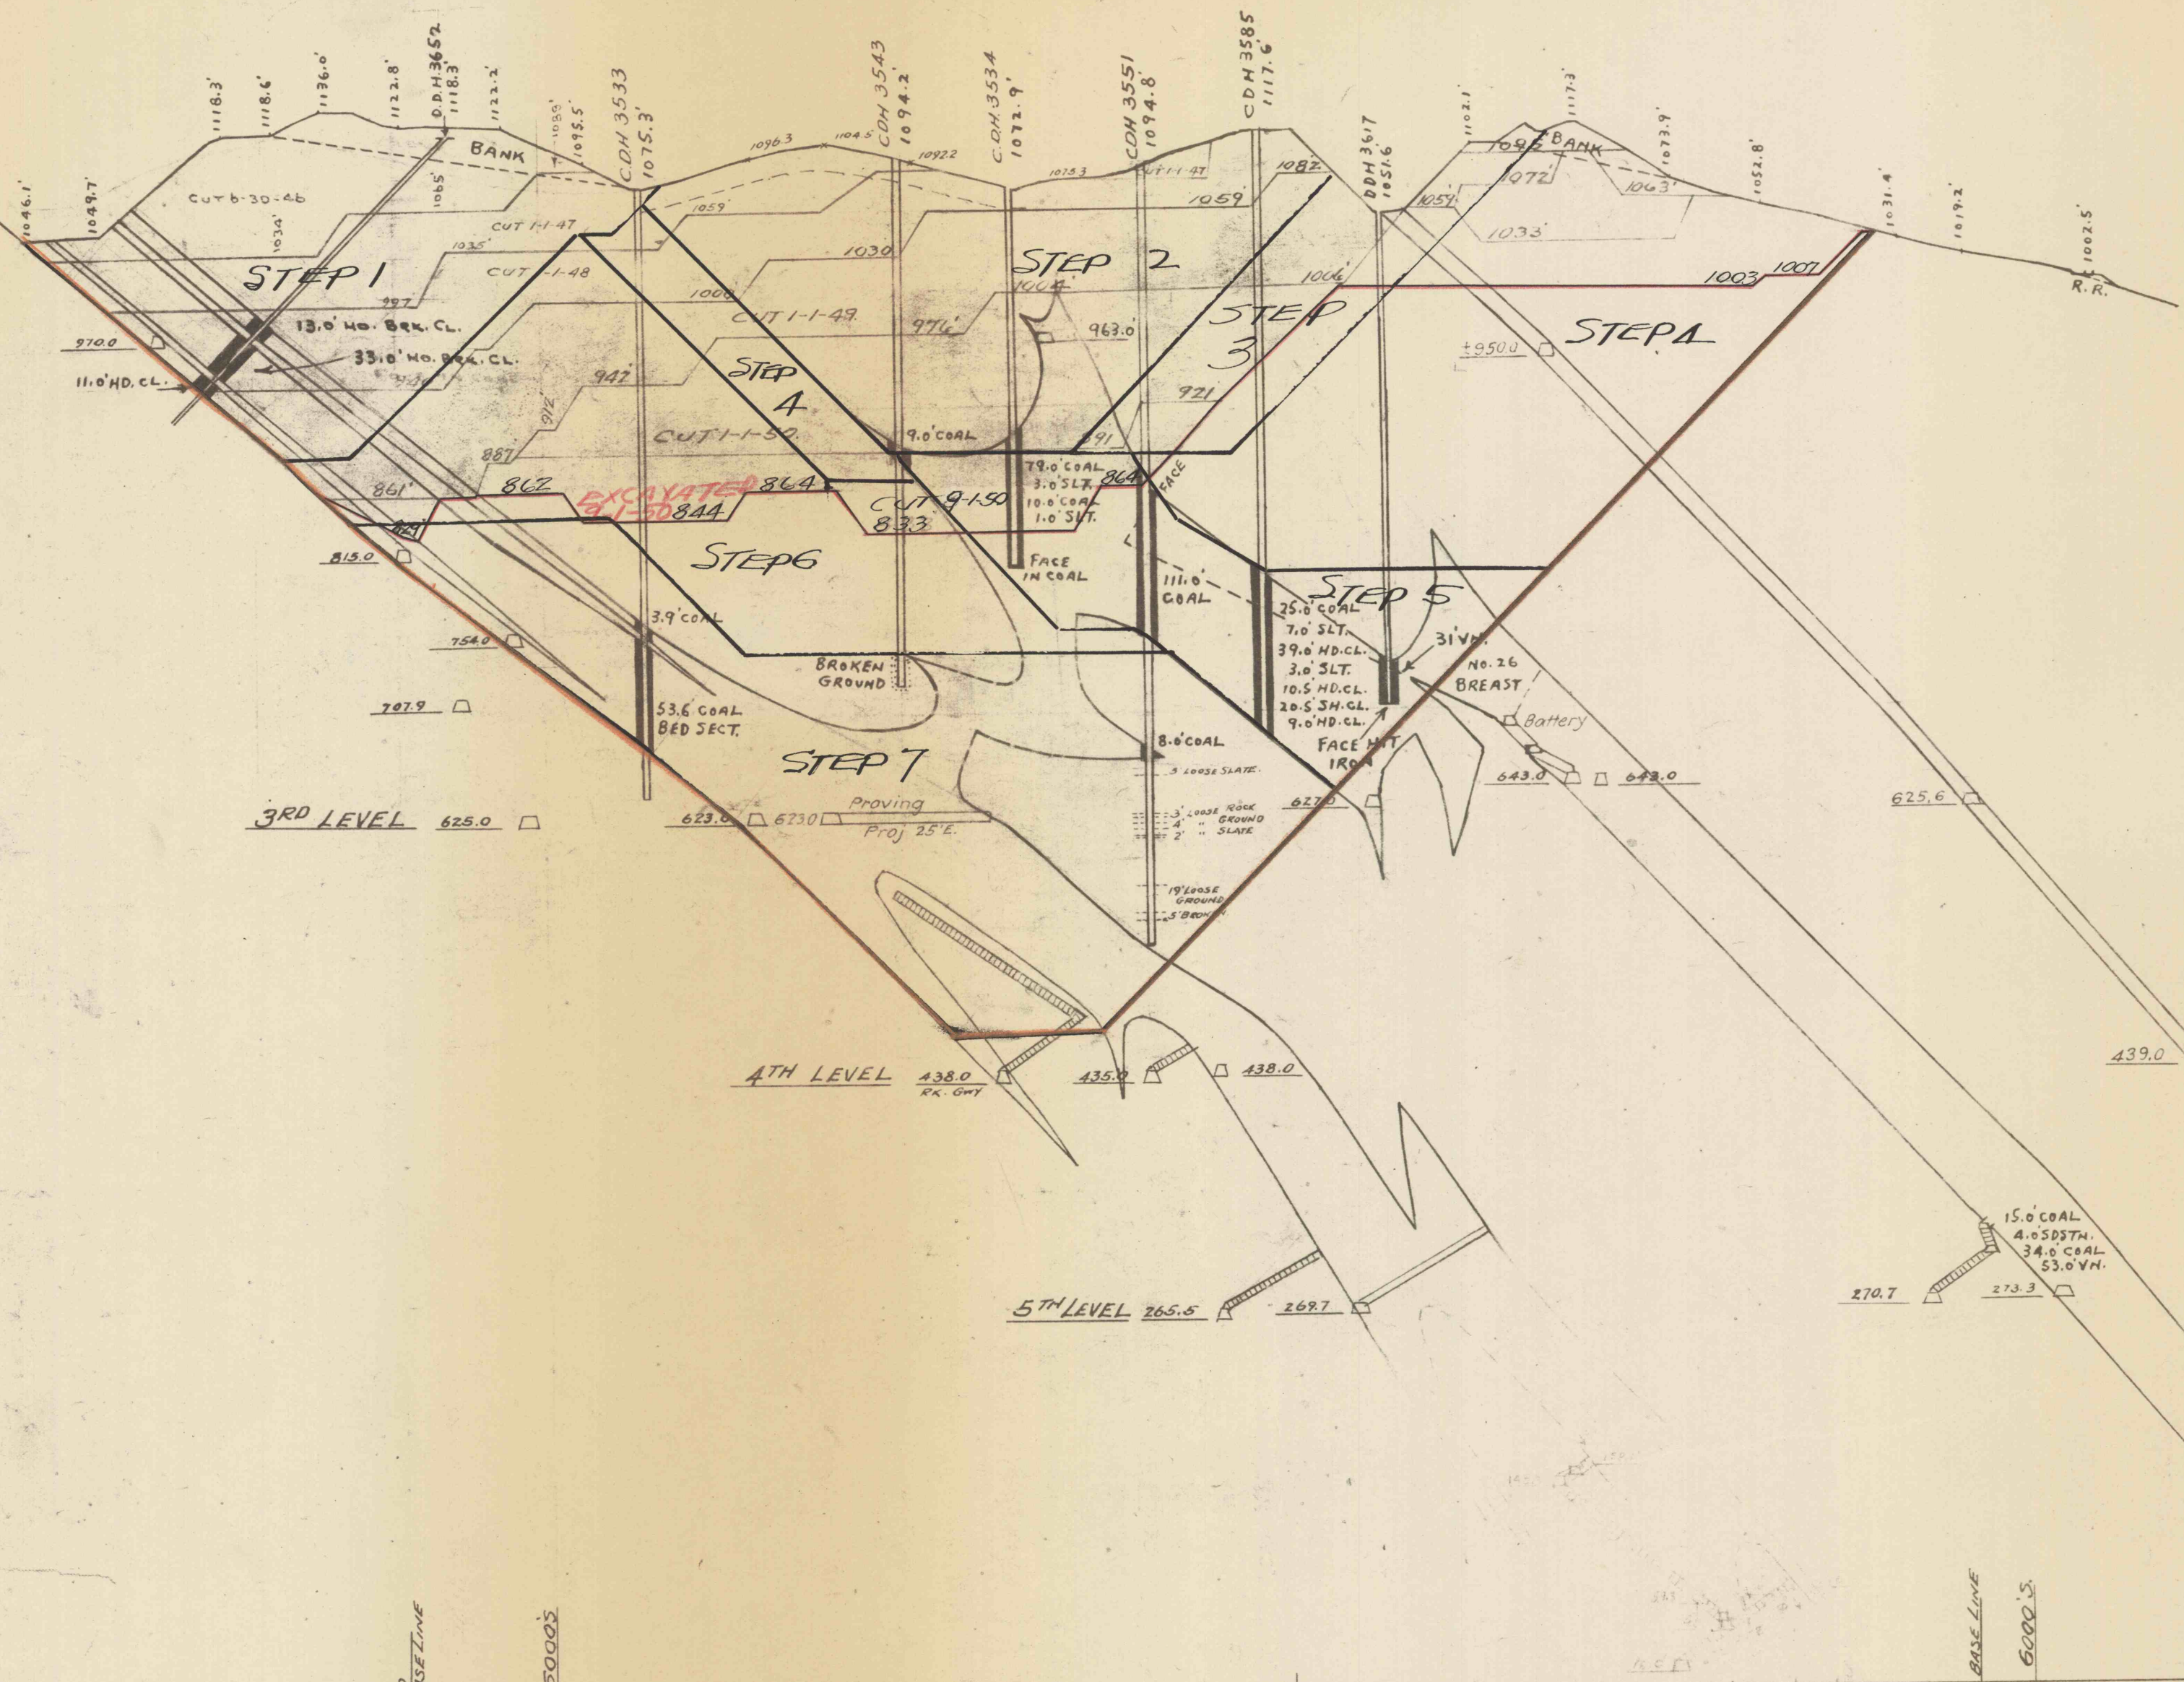

LEHIGH NAVIGATION COAL CO., INC.
 LANSFORD, PENNA.
 MINING ENGINEERING DEPT.

GREENWOOD COLLIERY

CROSS SECTION #3-E
 THROUGH FIRE AREA
 SEE DWG. 10-272

SCALE 1" = 100' DATE _____
 MADE BY _____ TRACED BY _____ CHECKED BY _____
 REVISED _____
 APPROVED _____

MIN. ENGR.
 DIST. SUPT.
 V. P. & GEN. MGR.

C1067