


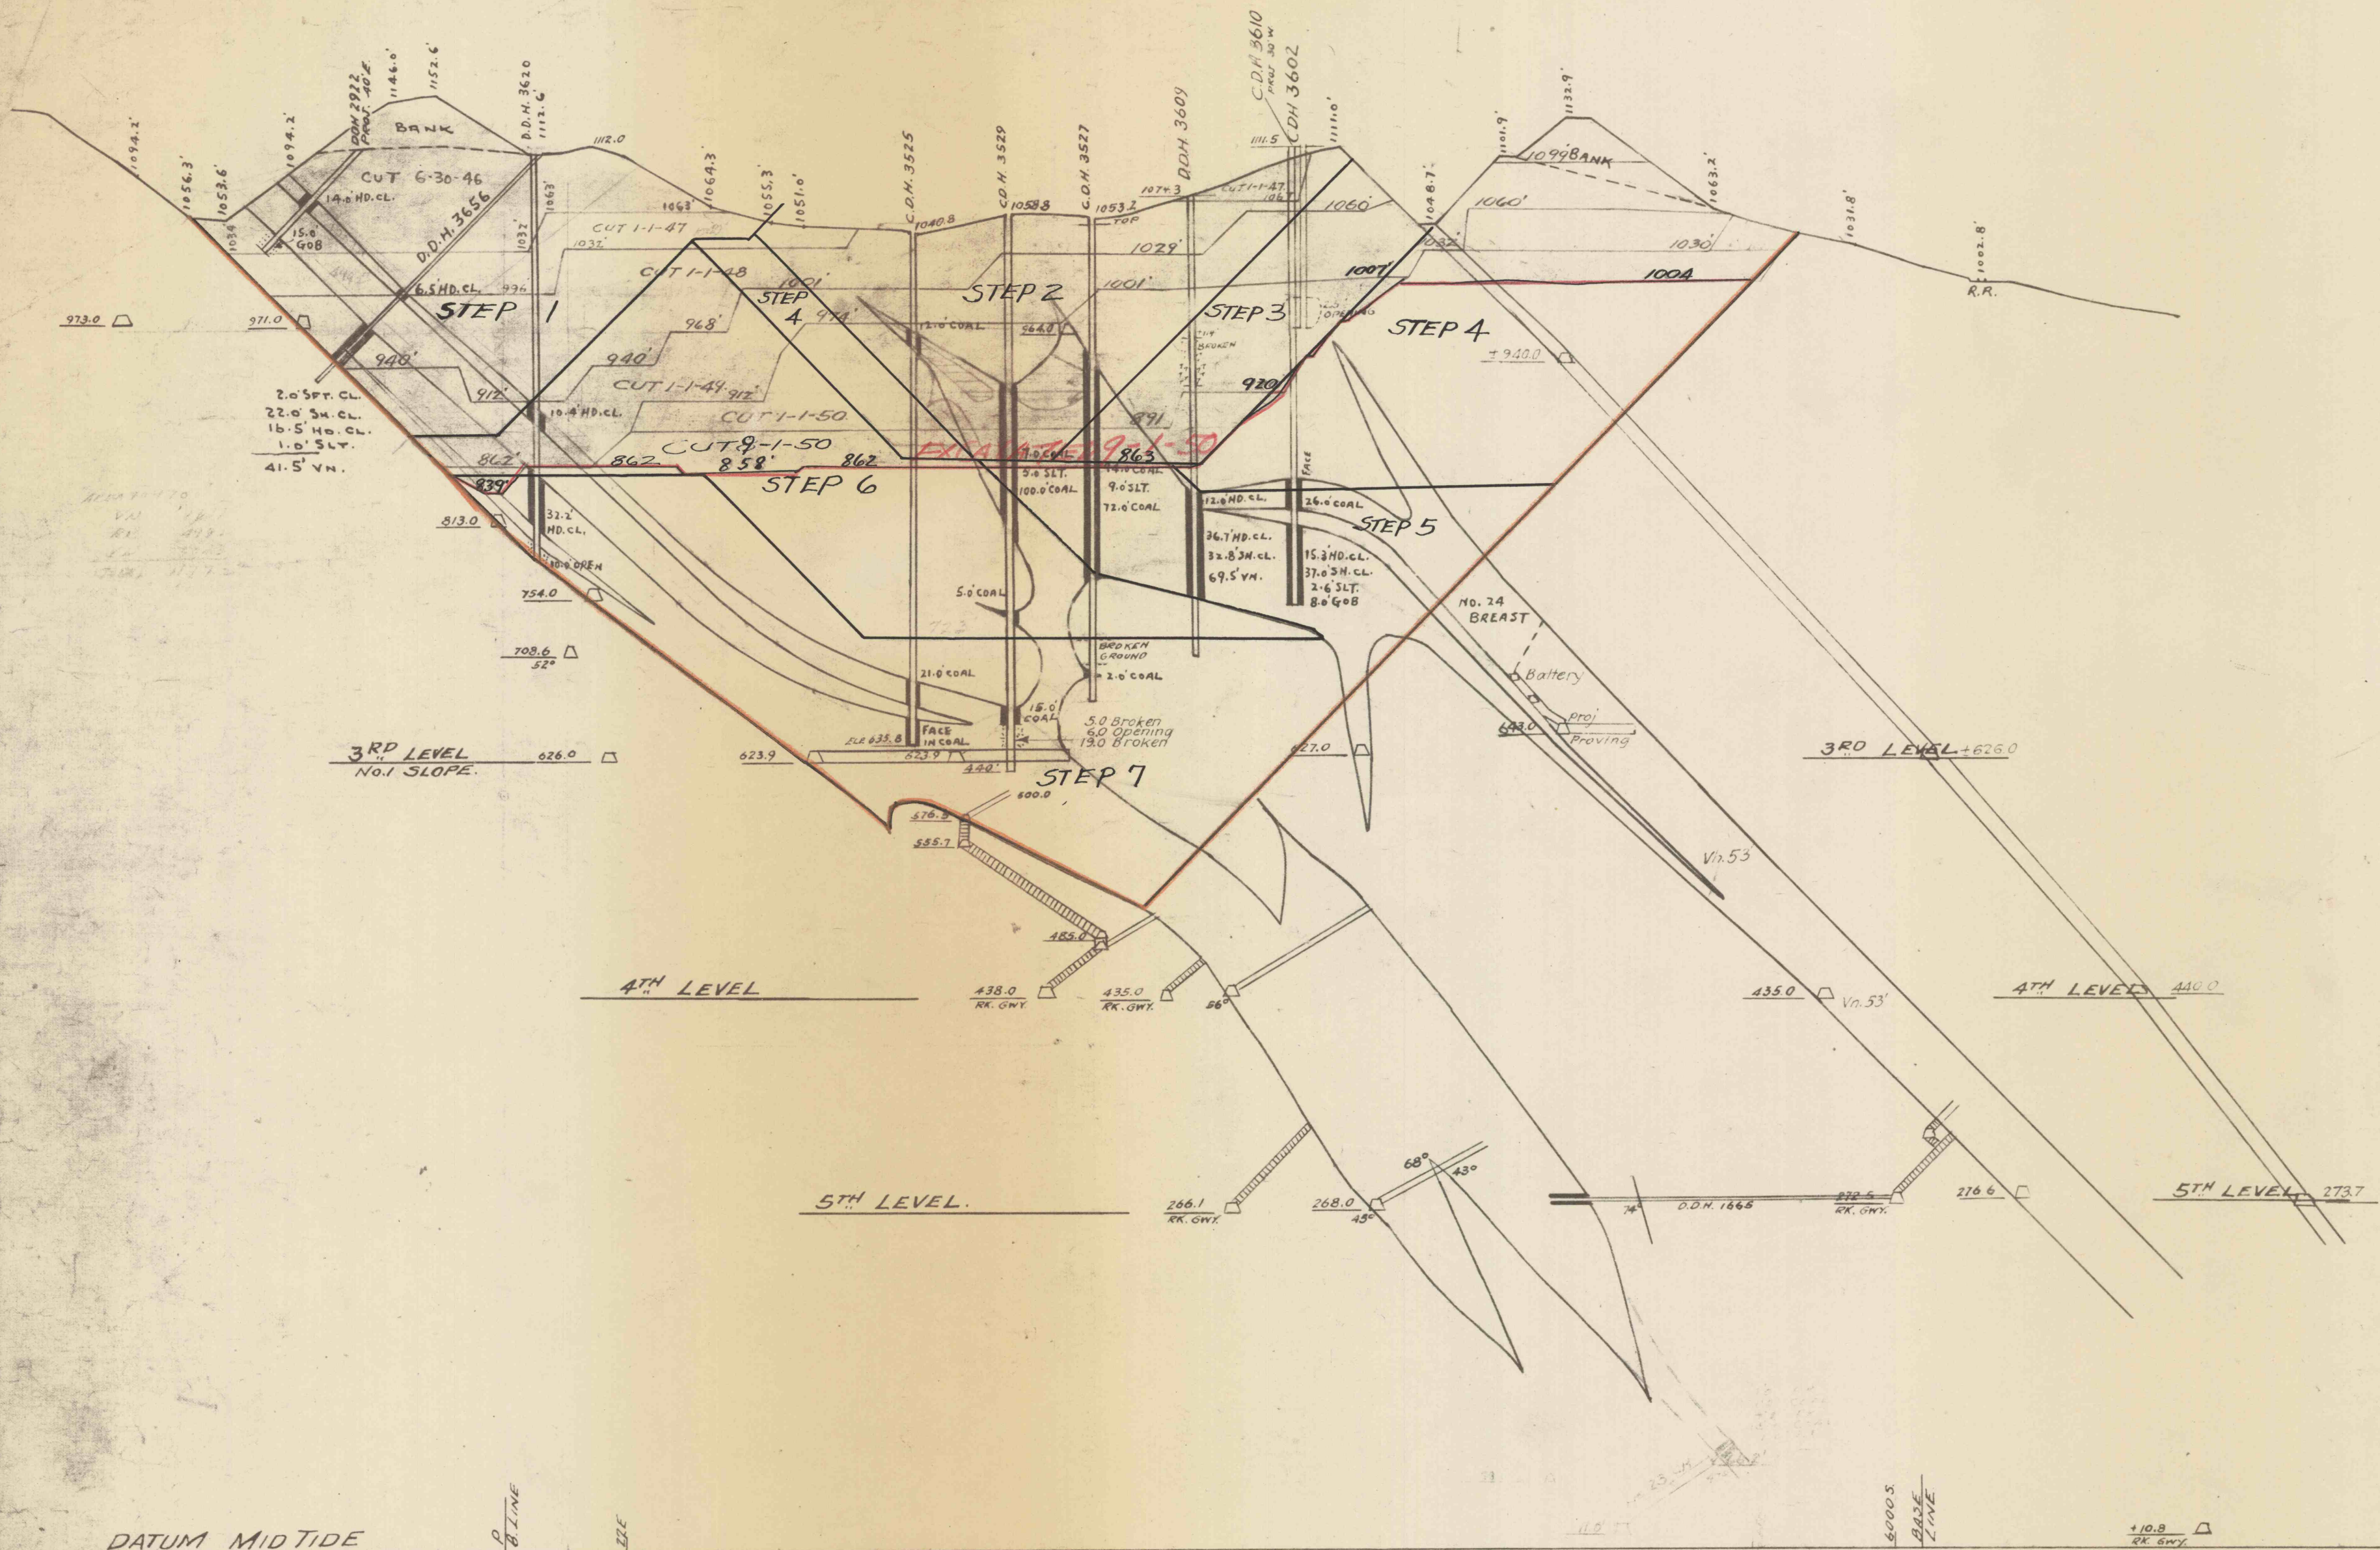

77

LEHIGH NAVIGATION COAL CO., INC.			
LANSFORD, PENNA.			
MINING ENGINEERING DEPT.			
GREENWOOD COLLIERY			
CROSS SECTION #2-E			
THROUGH FIRE AREA			
SEE DWG 10-272			
SCALE	1" = 100'	DATE	
MADE BY	TRACED BY	CHECKED BY	
REVISED			
APPROVED			
MIN. ENGR.			
DIST. SUPT.			
V. P. & GEN. MGR.			
			C1066