


C A L E B L O W N E S T R A C T

G E O R G

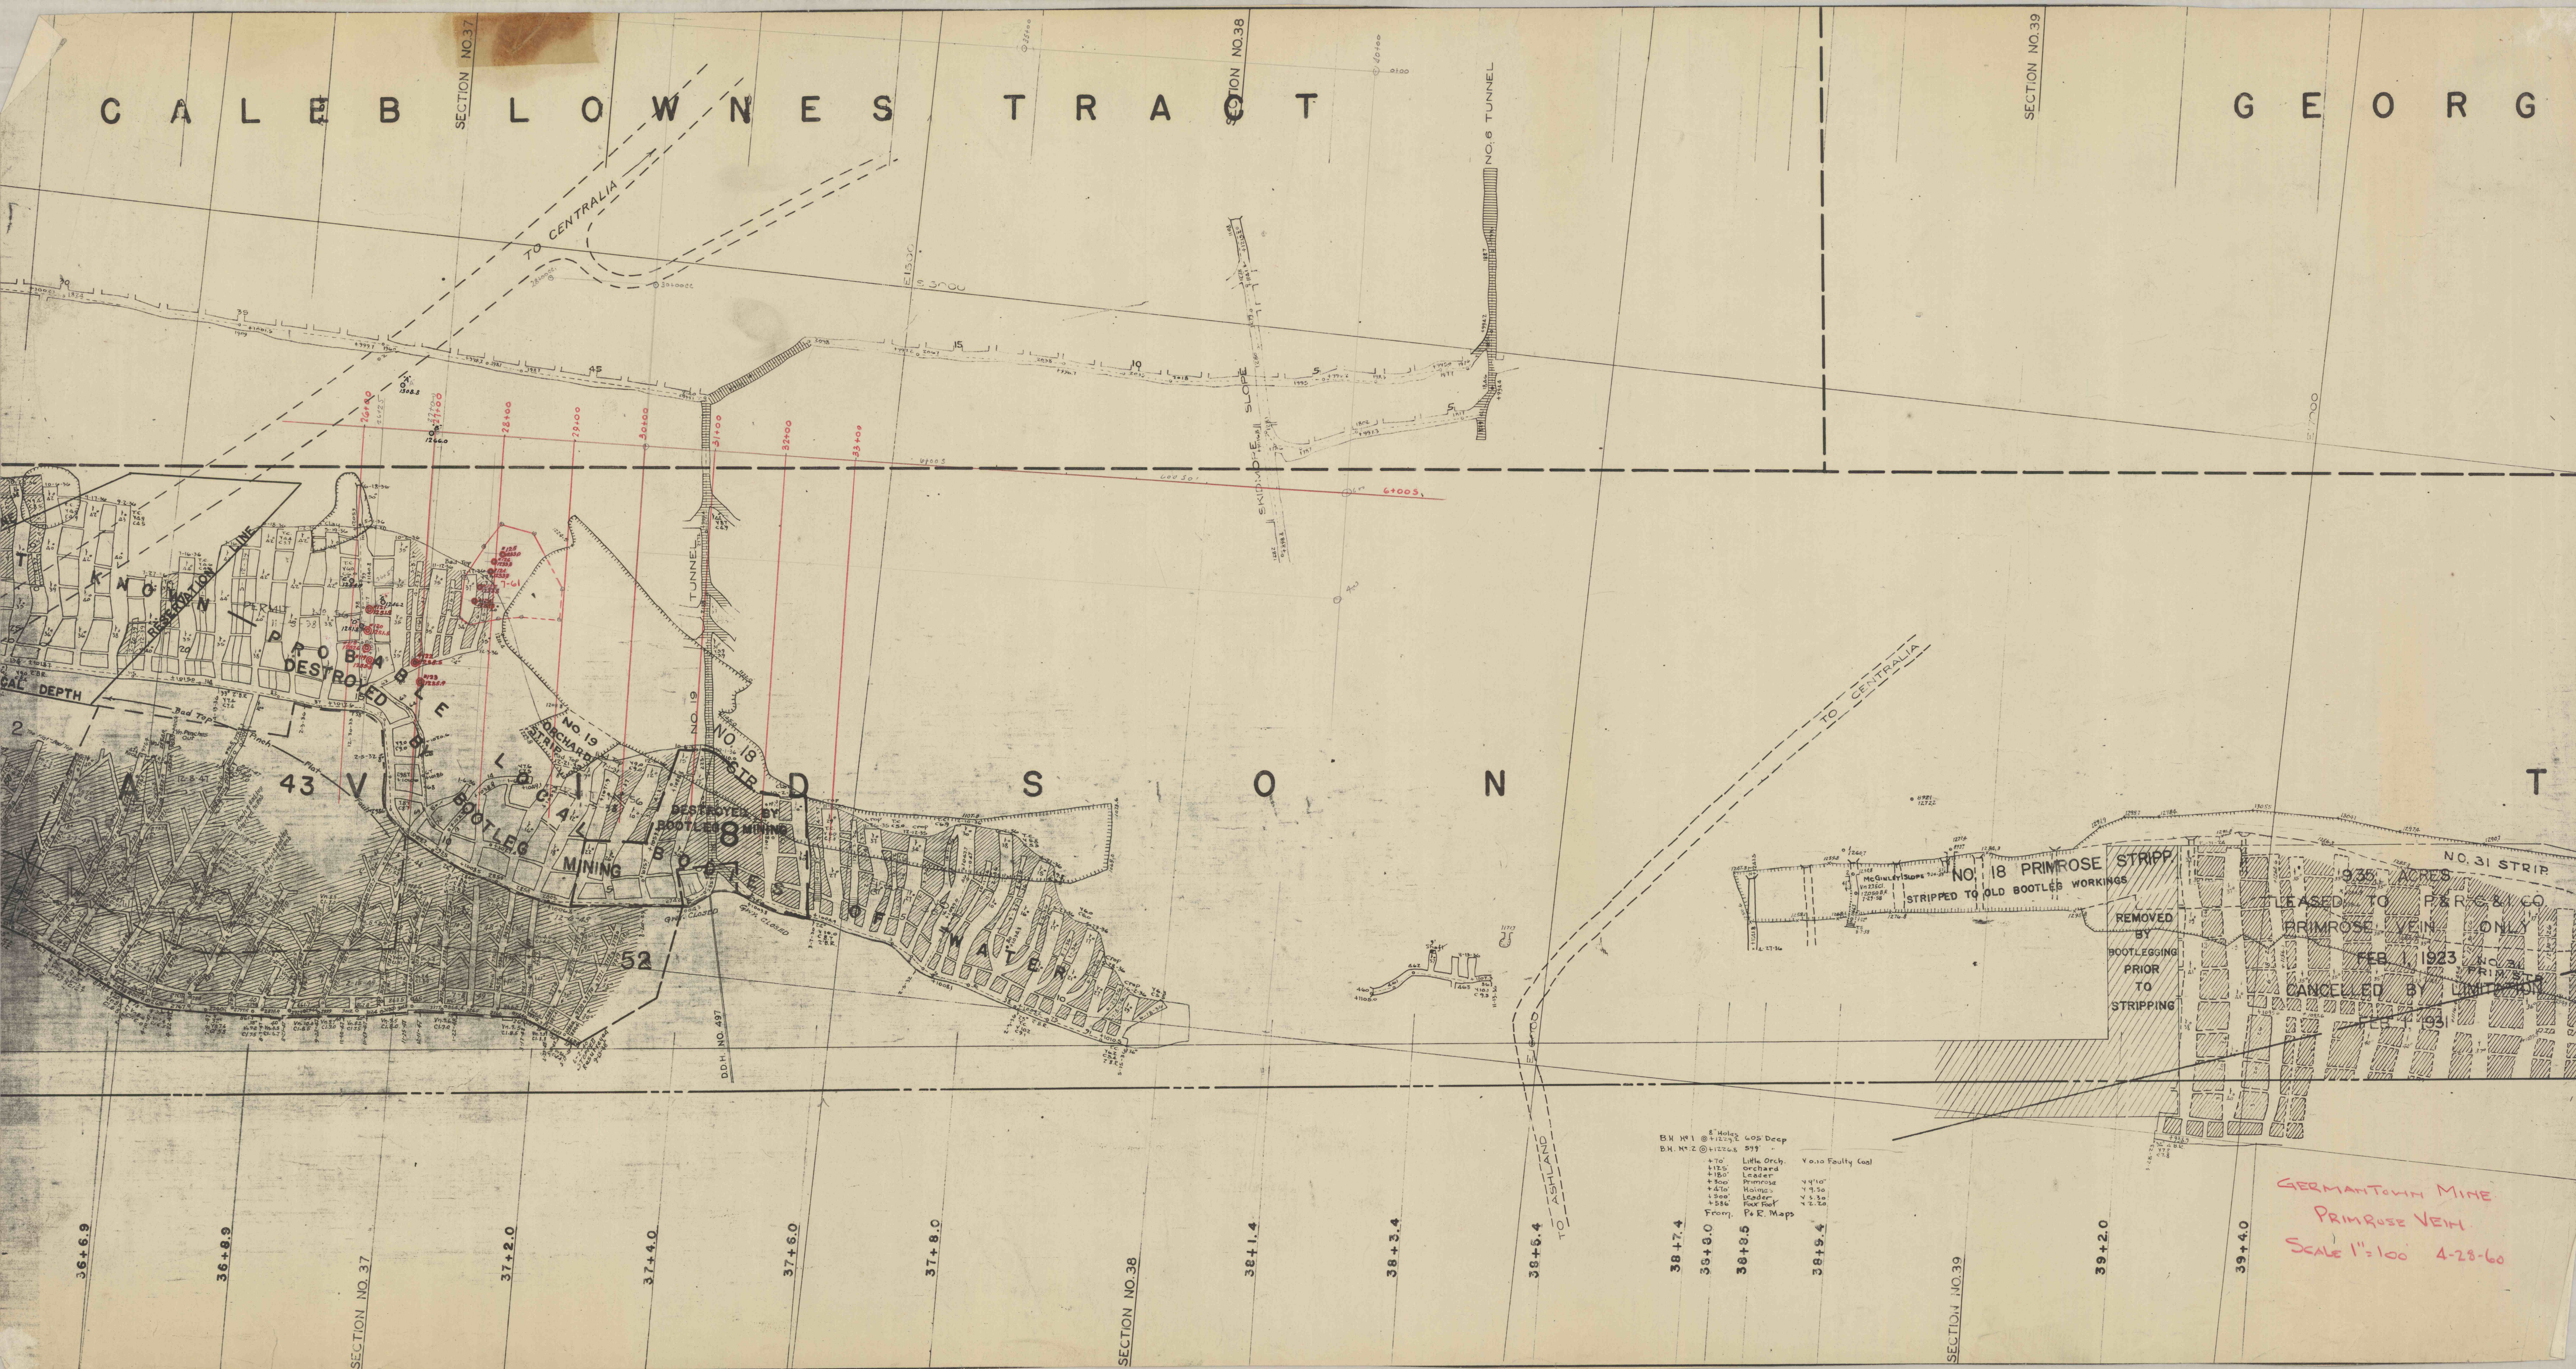

SECTION NO. 37

SECTION NO. 38

SECTION NO. 39

SECTION NO. 37

SECTION NO. 38

SECTION NO. 39

B.H. No. 1 @ 1122.5 605 Deep
B.H. No. 2 @ 1122.5 599
+10' Little Orch.
+115' Orchard
+180' Leader
+300' Primrose
+420' Main
+586' Fox Roof
From P.E. Maps
Y. 10 Faulty Coal

GERMANTOWN MINE
PRIMROSE VEIN
Scale 1"=100 4-28-60